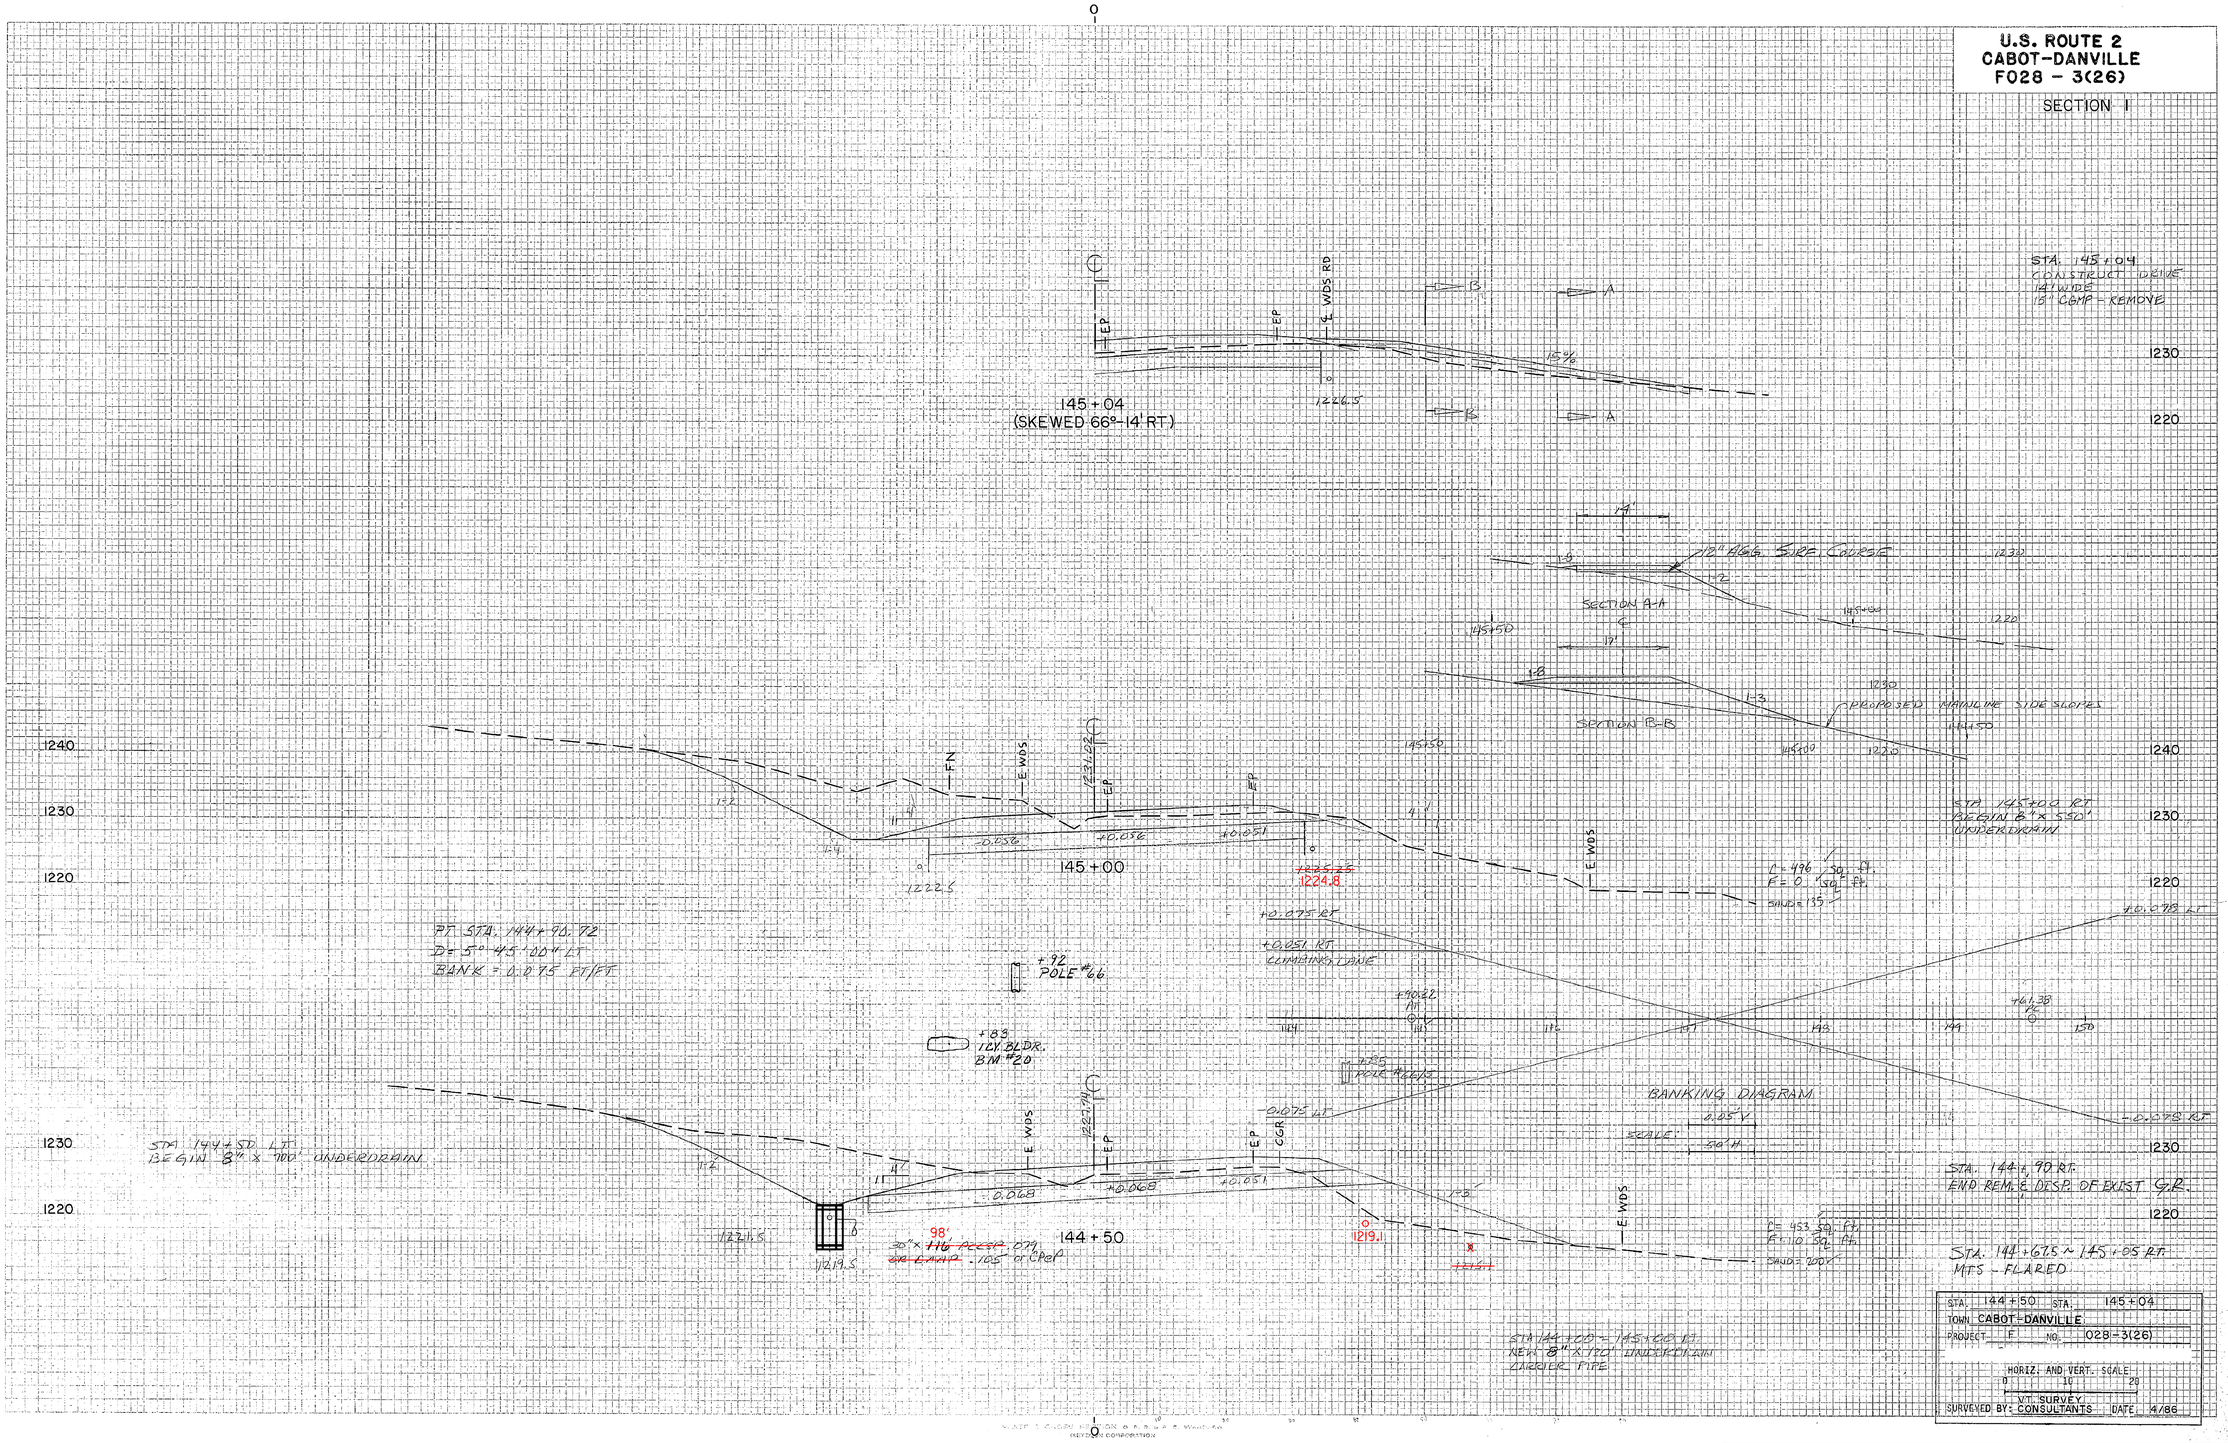

PROJECT NAME: CABOT-DANVILLE	
PROJECT NUMBER: FEGC F 028-3(26) C/I	
FILE NAME: 78d058xs.dgn	PLOT DATE: 06-OCT-2010
PROJECT LEADER: K. ROBIE	DRAWN BY: I. SHEA
DESIGNED BY: I. SHEA	CHECKED BY: S. MENARD
MAINLINE CROSS SECTIONS 35	SHEET 167 OF 250