U.S. ROUTE 2
CABOT-DANVILLE
F028 - 3(26)

SECTION I

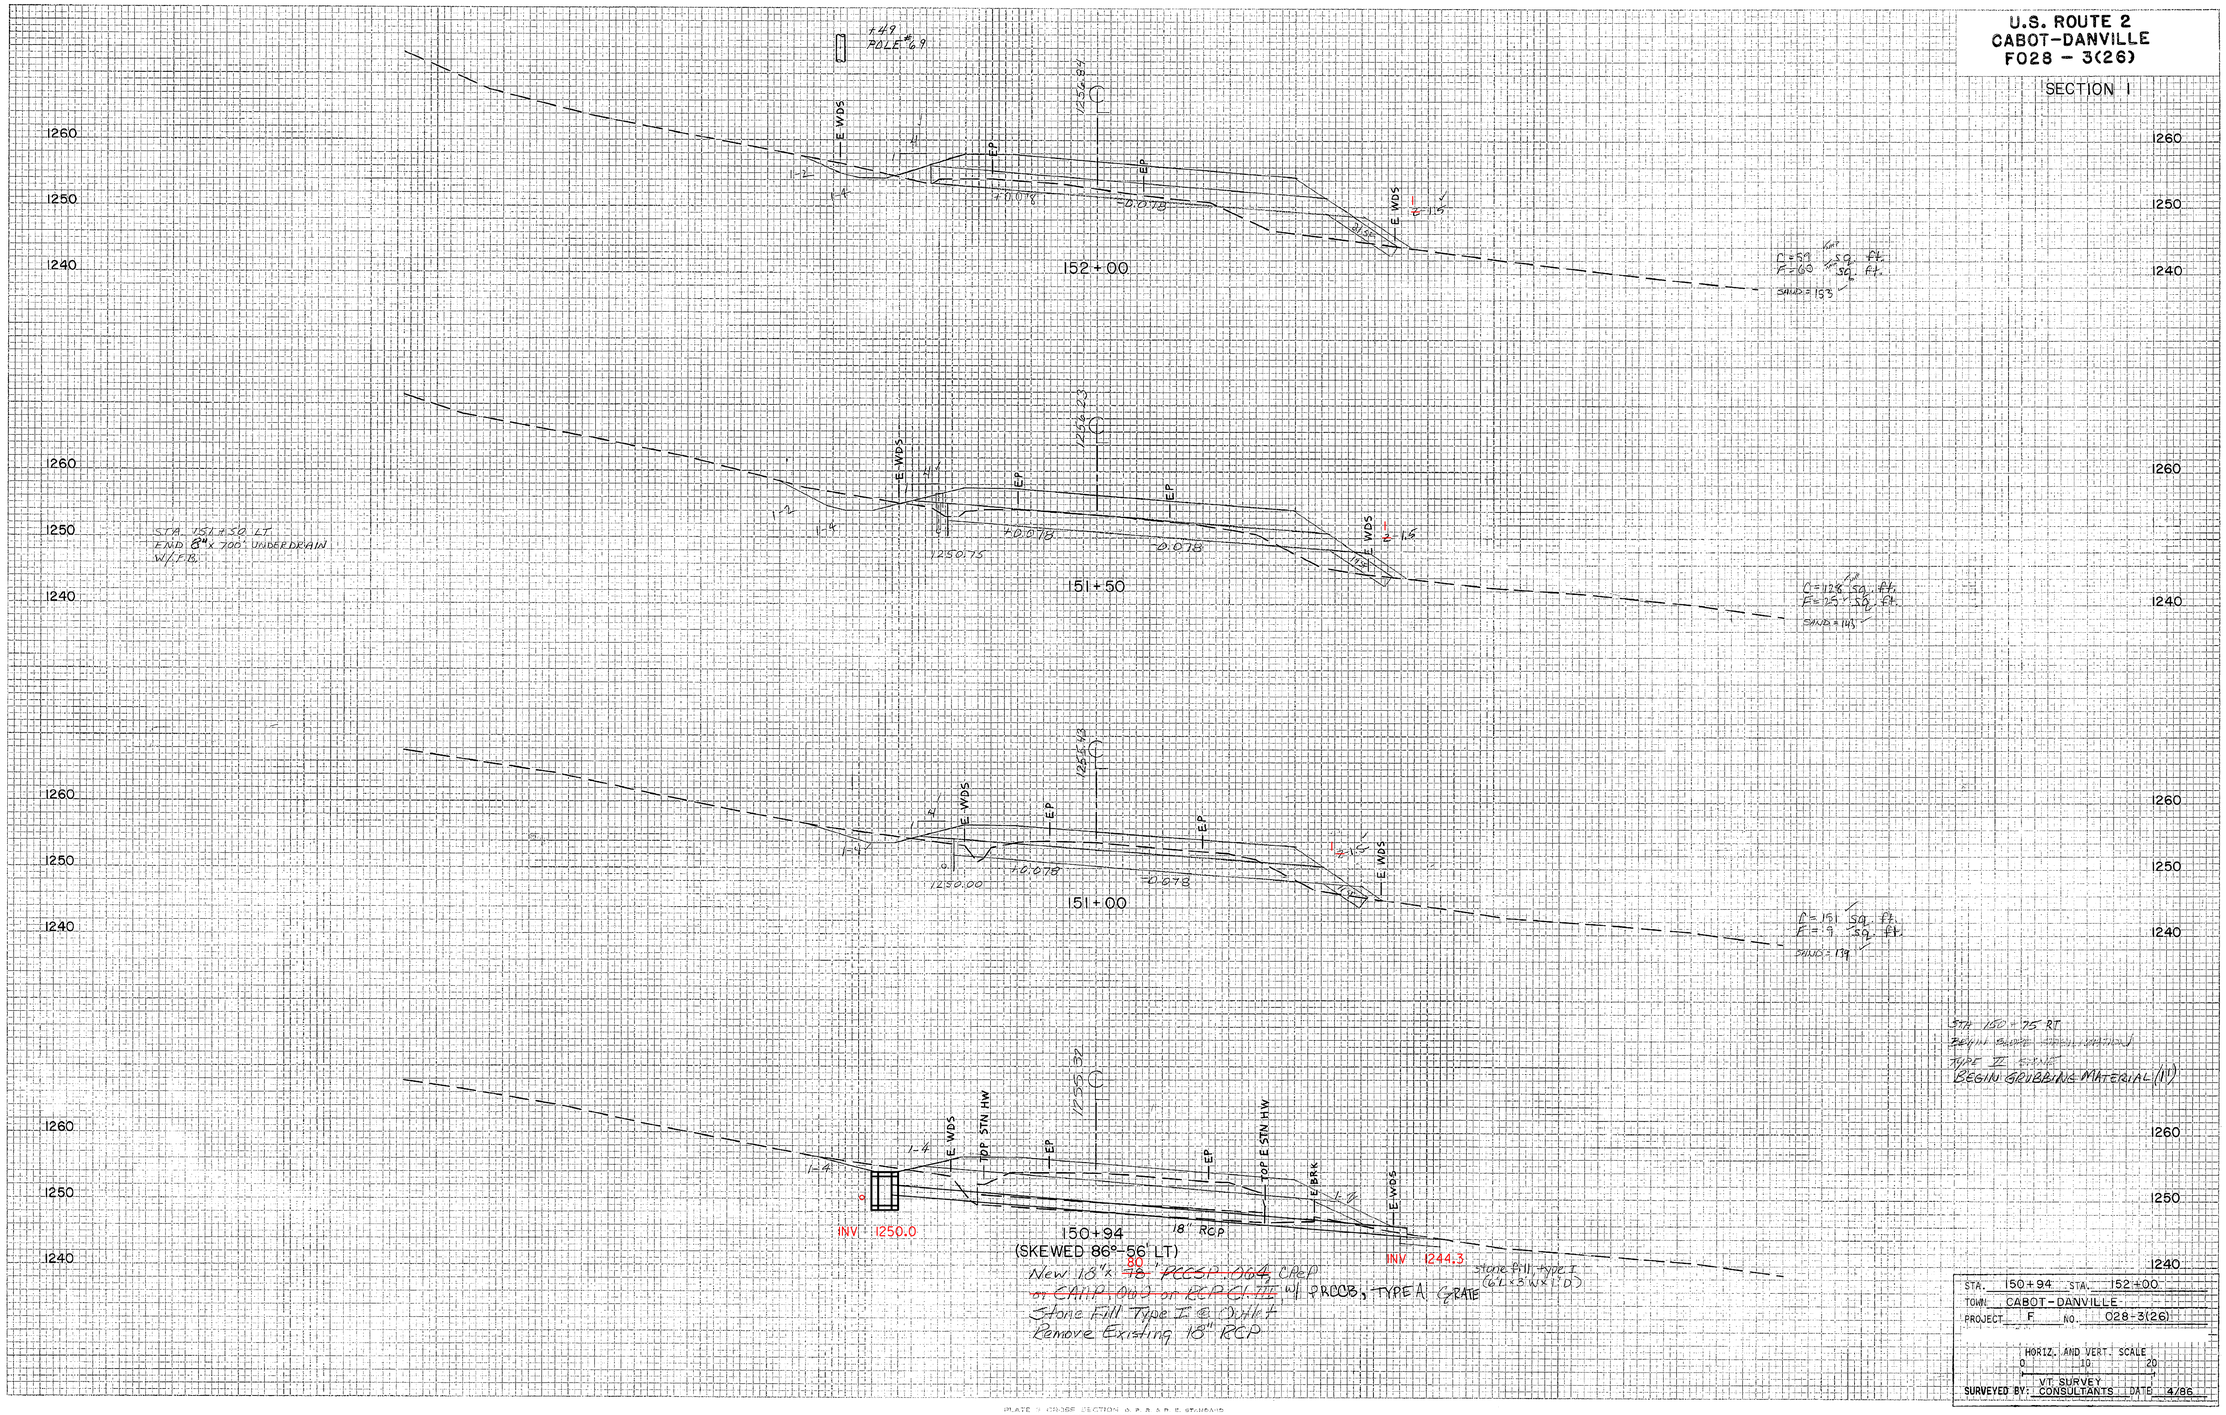

PROJECT NAME: CABOT-DANVILLE
PROJECT NUMBER: FEGC F 028-3(26) C/I

FILE NAME: 78d058xs.dgn
PROJECT LEADER: K. ROBIE
DESIGNED BY: I. SHEA
MAINLINE CROSS SECTIONS 39

PLOT DATE: 06-OCT-2010
DRAWN BY: I. SHEA
CHECKED BY: S. MENARD
SHEET 171 OF 250