

U.S. ROUTE 2
CABOT-DANVILLE
F028 - 3(26)

SECTION 1

DATE	
BY	
REVISION	
NO.	
DESCRIPTION	
DATE	
BY	
REVISION	
NO.	
DESCRIPTION	

DATE	4/86
BY	BRYANT ASSOC.
REVISION	
NO.	
DESCRIPTION	
DATE	
BY	
REVISION	
NO.	
DESCRIPTION	

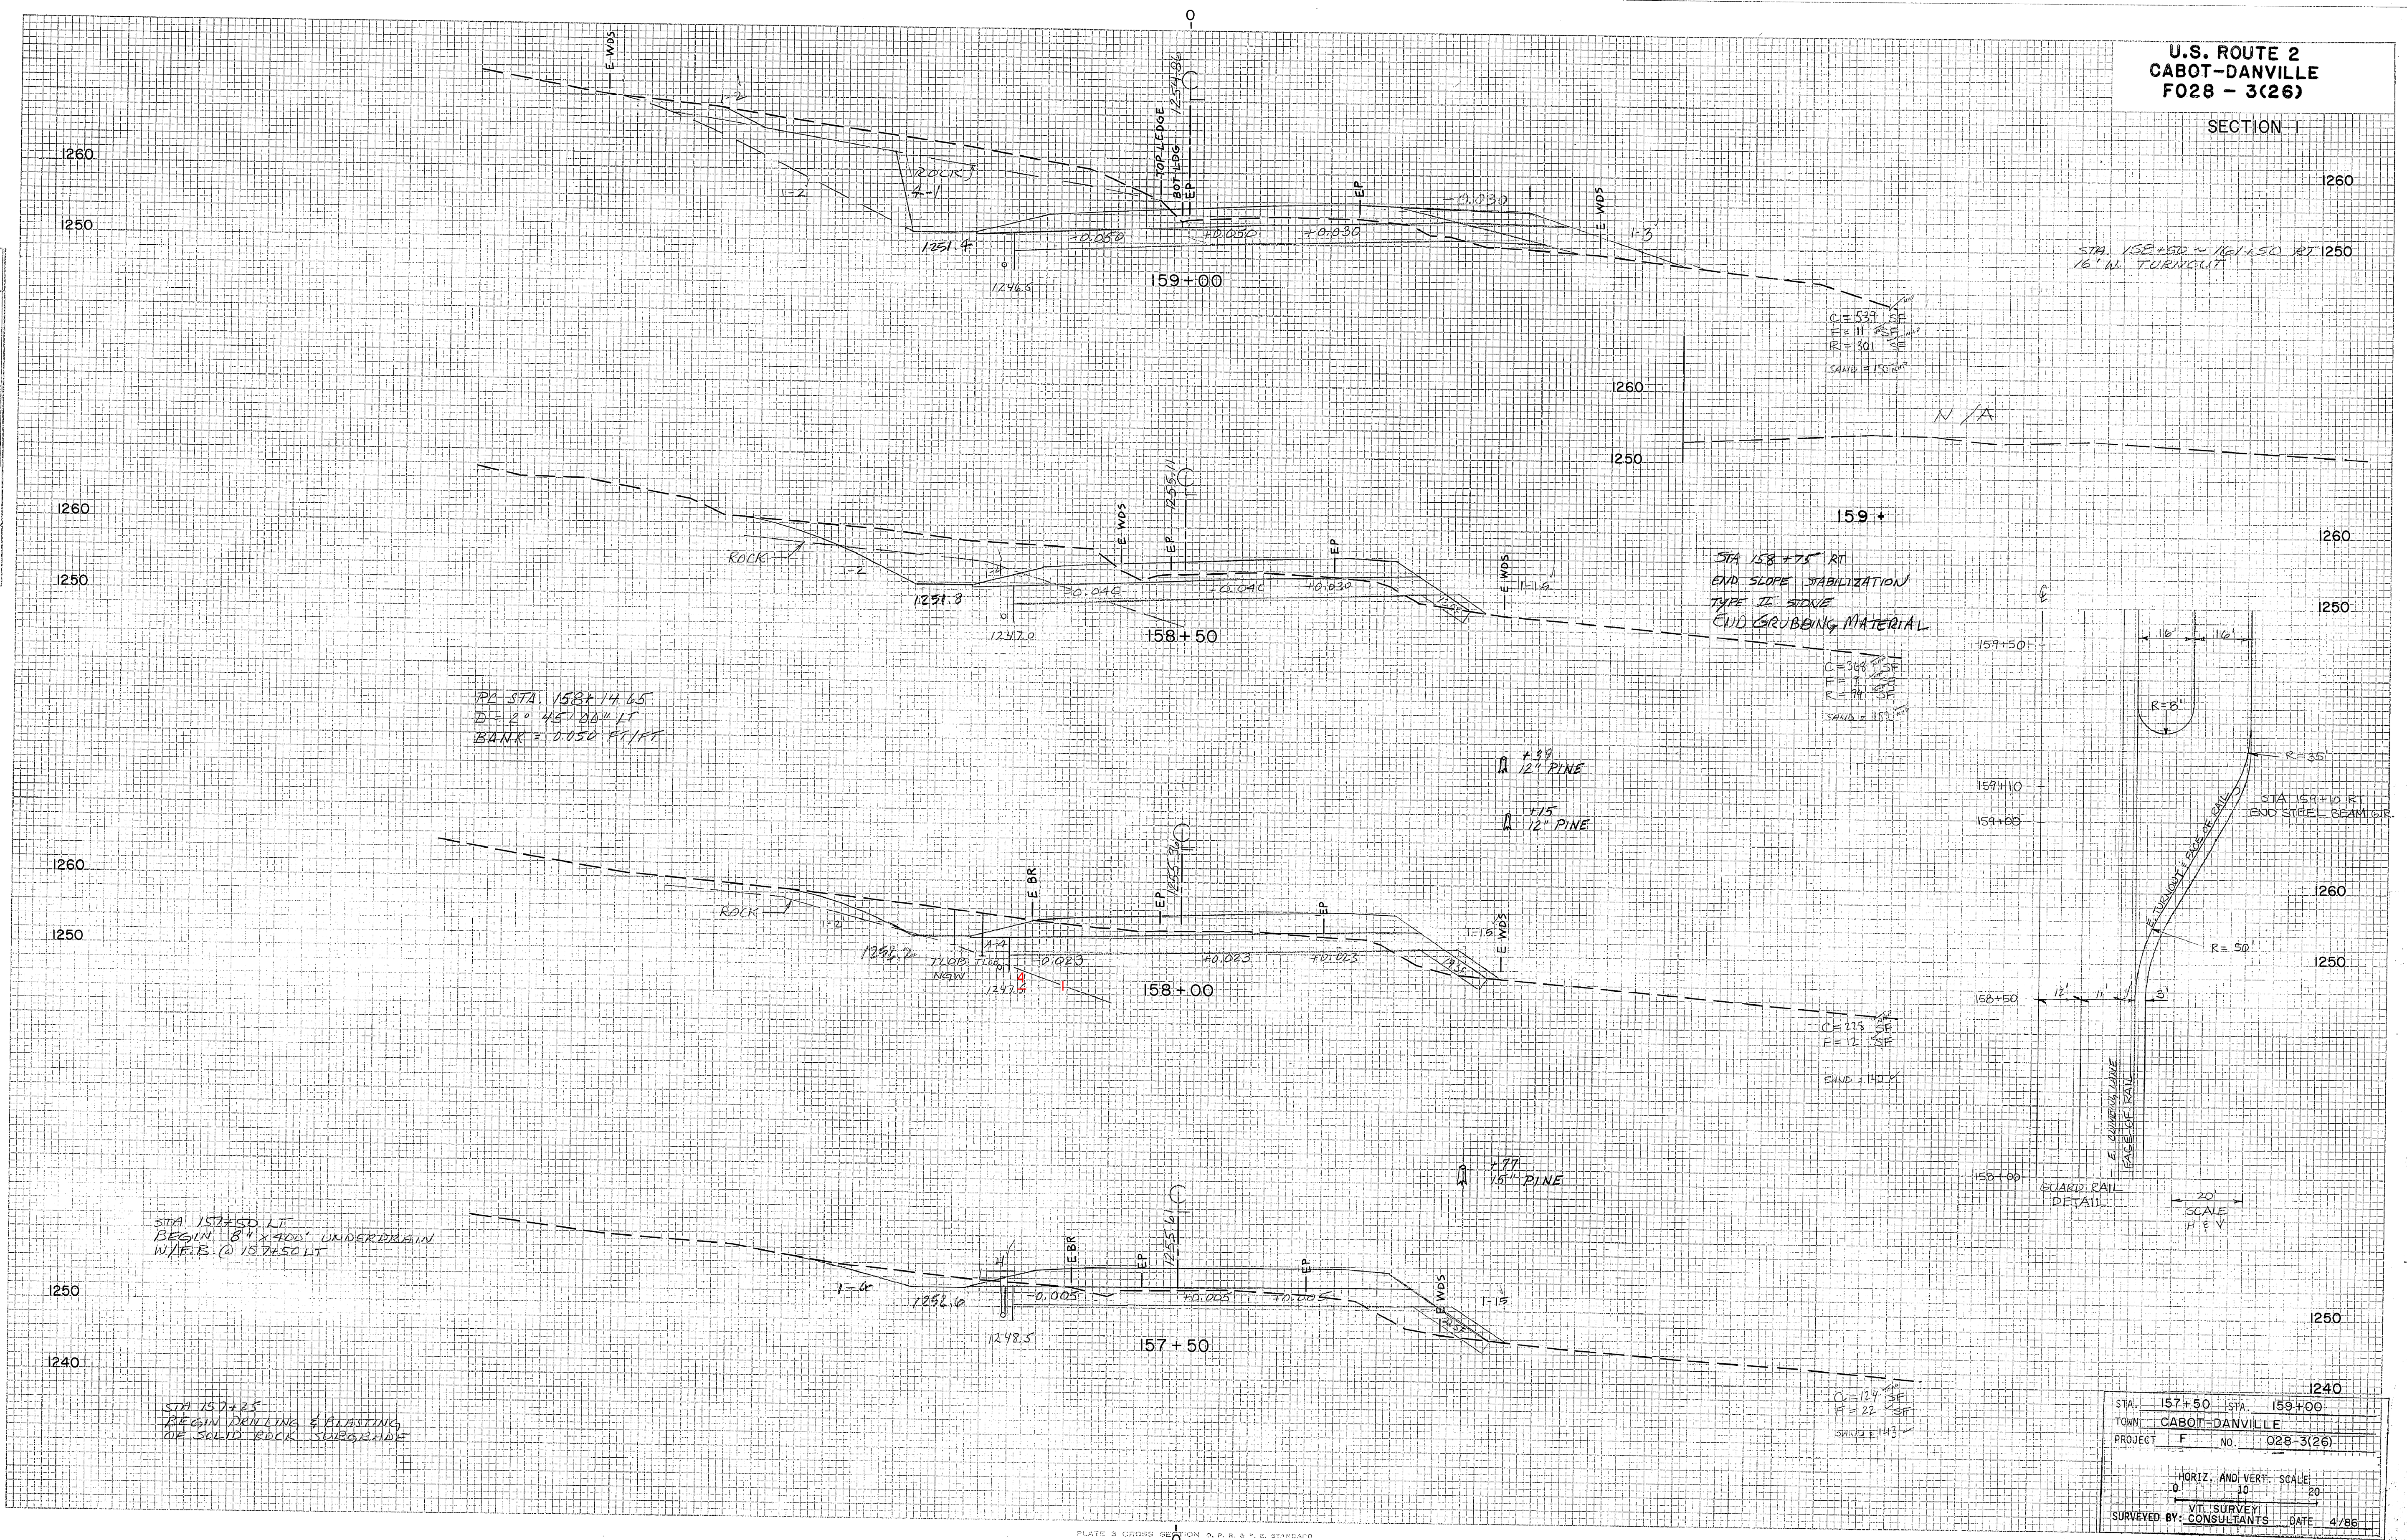


PLATE 3 CROSS SECTION A, P. R. O. T. E. S. T. A. R. D.
SHEET 176 OF 250

PROJECT NAME: CABOT-DANVILLE
 PROJECT NUMBER: FECC F 028-3(26) C/1
 FILE NAME: 78d058xs.dgn
 PROJECT LEADER: K. ROBE
 DESIGNED BY: I. SHEA
 MAINLINE CROSS SECTIONS 44
 PLOT DATE: 06-OCT-2010
 DRAWN BY: I. SHEA
 CHECKED BY: S. MENARD
 SHEET 176 OF 250