U.S. ROUTE 2
CABOT-DANVILLE
F028 - 3(26)

SECTION 1

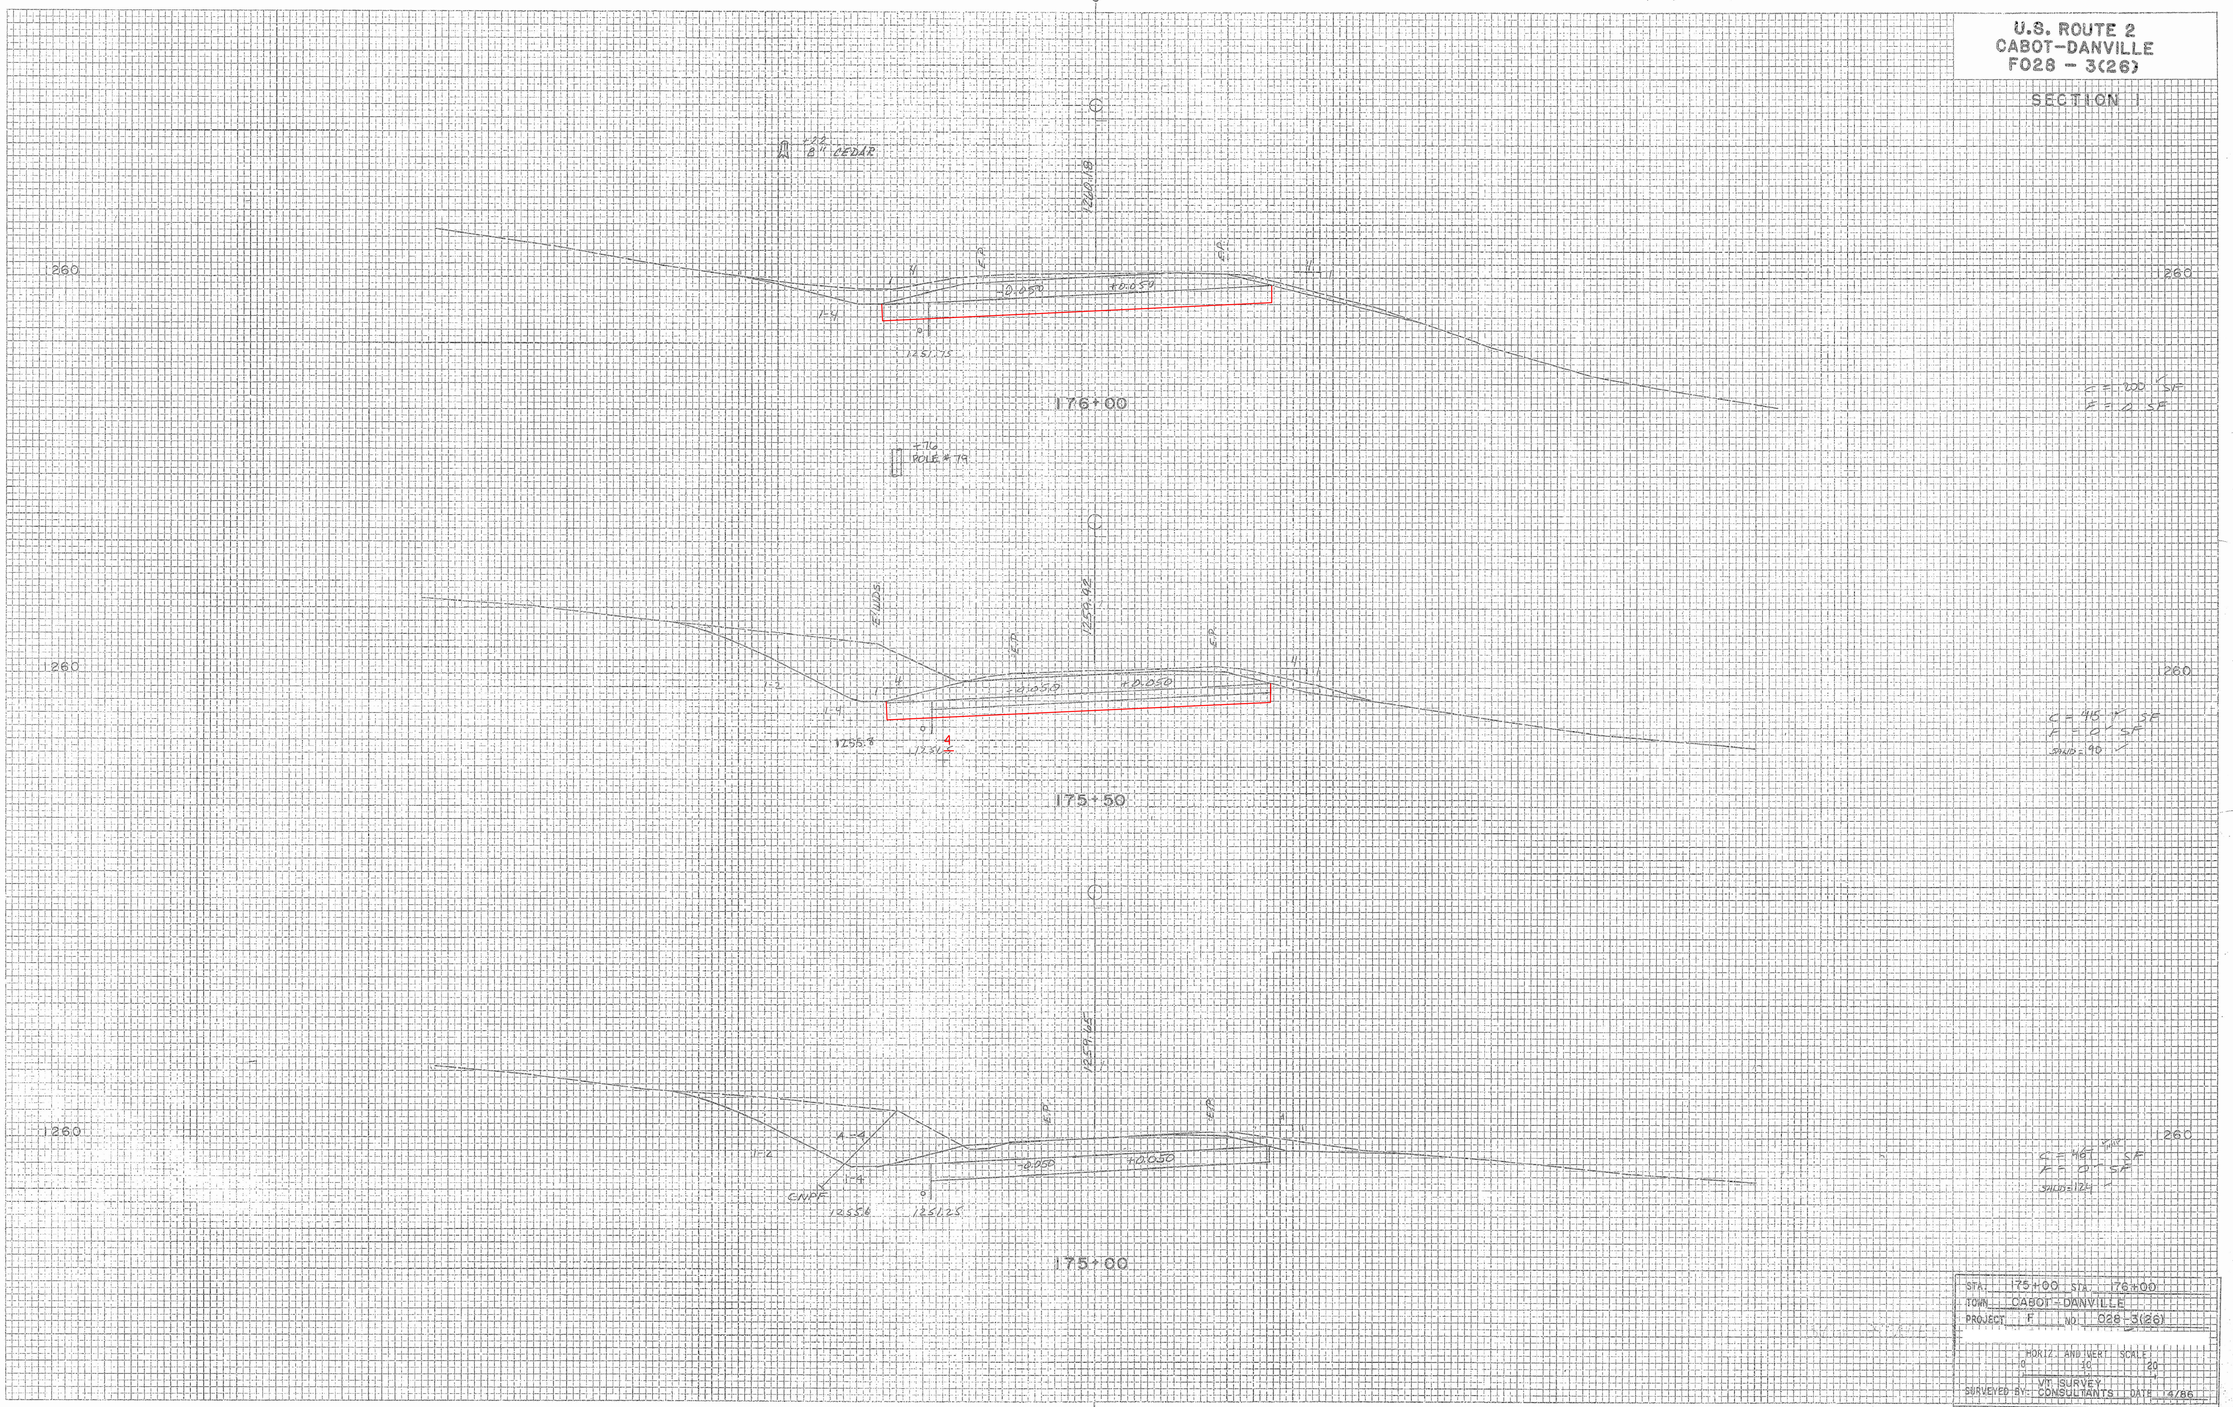
260
176+00
175+50
175+00
POLE # 79
EP
EP
EP