U.S. ROUTE 2
CABOT-DANVILLE
F028 - 3(26)

SECTION 1

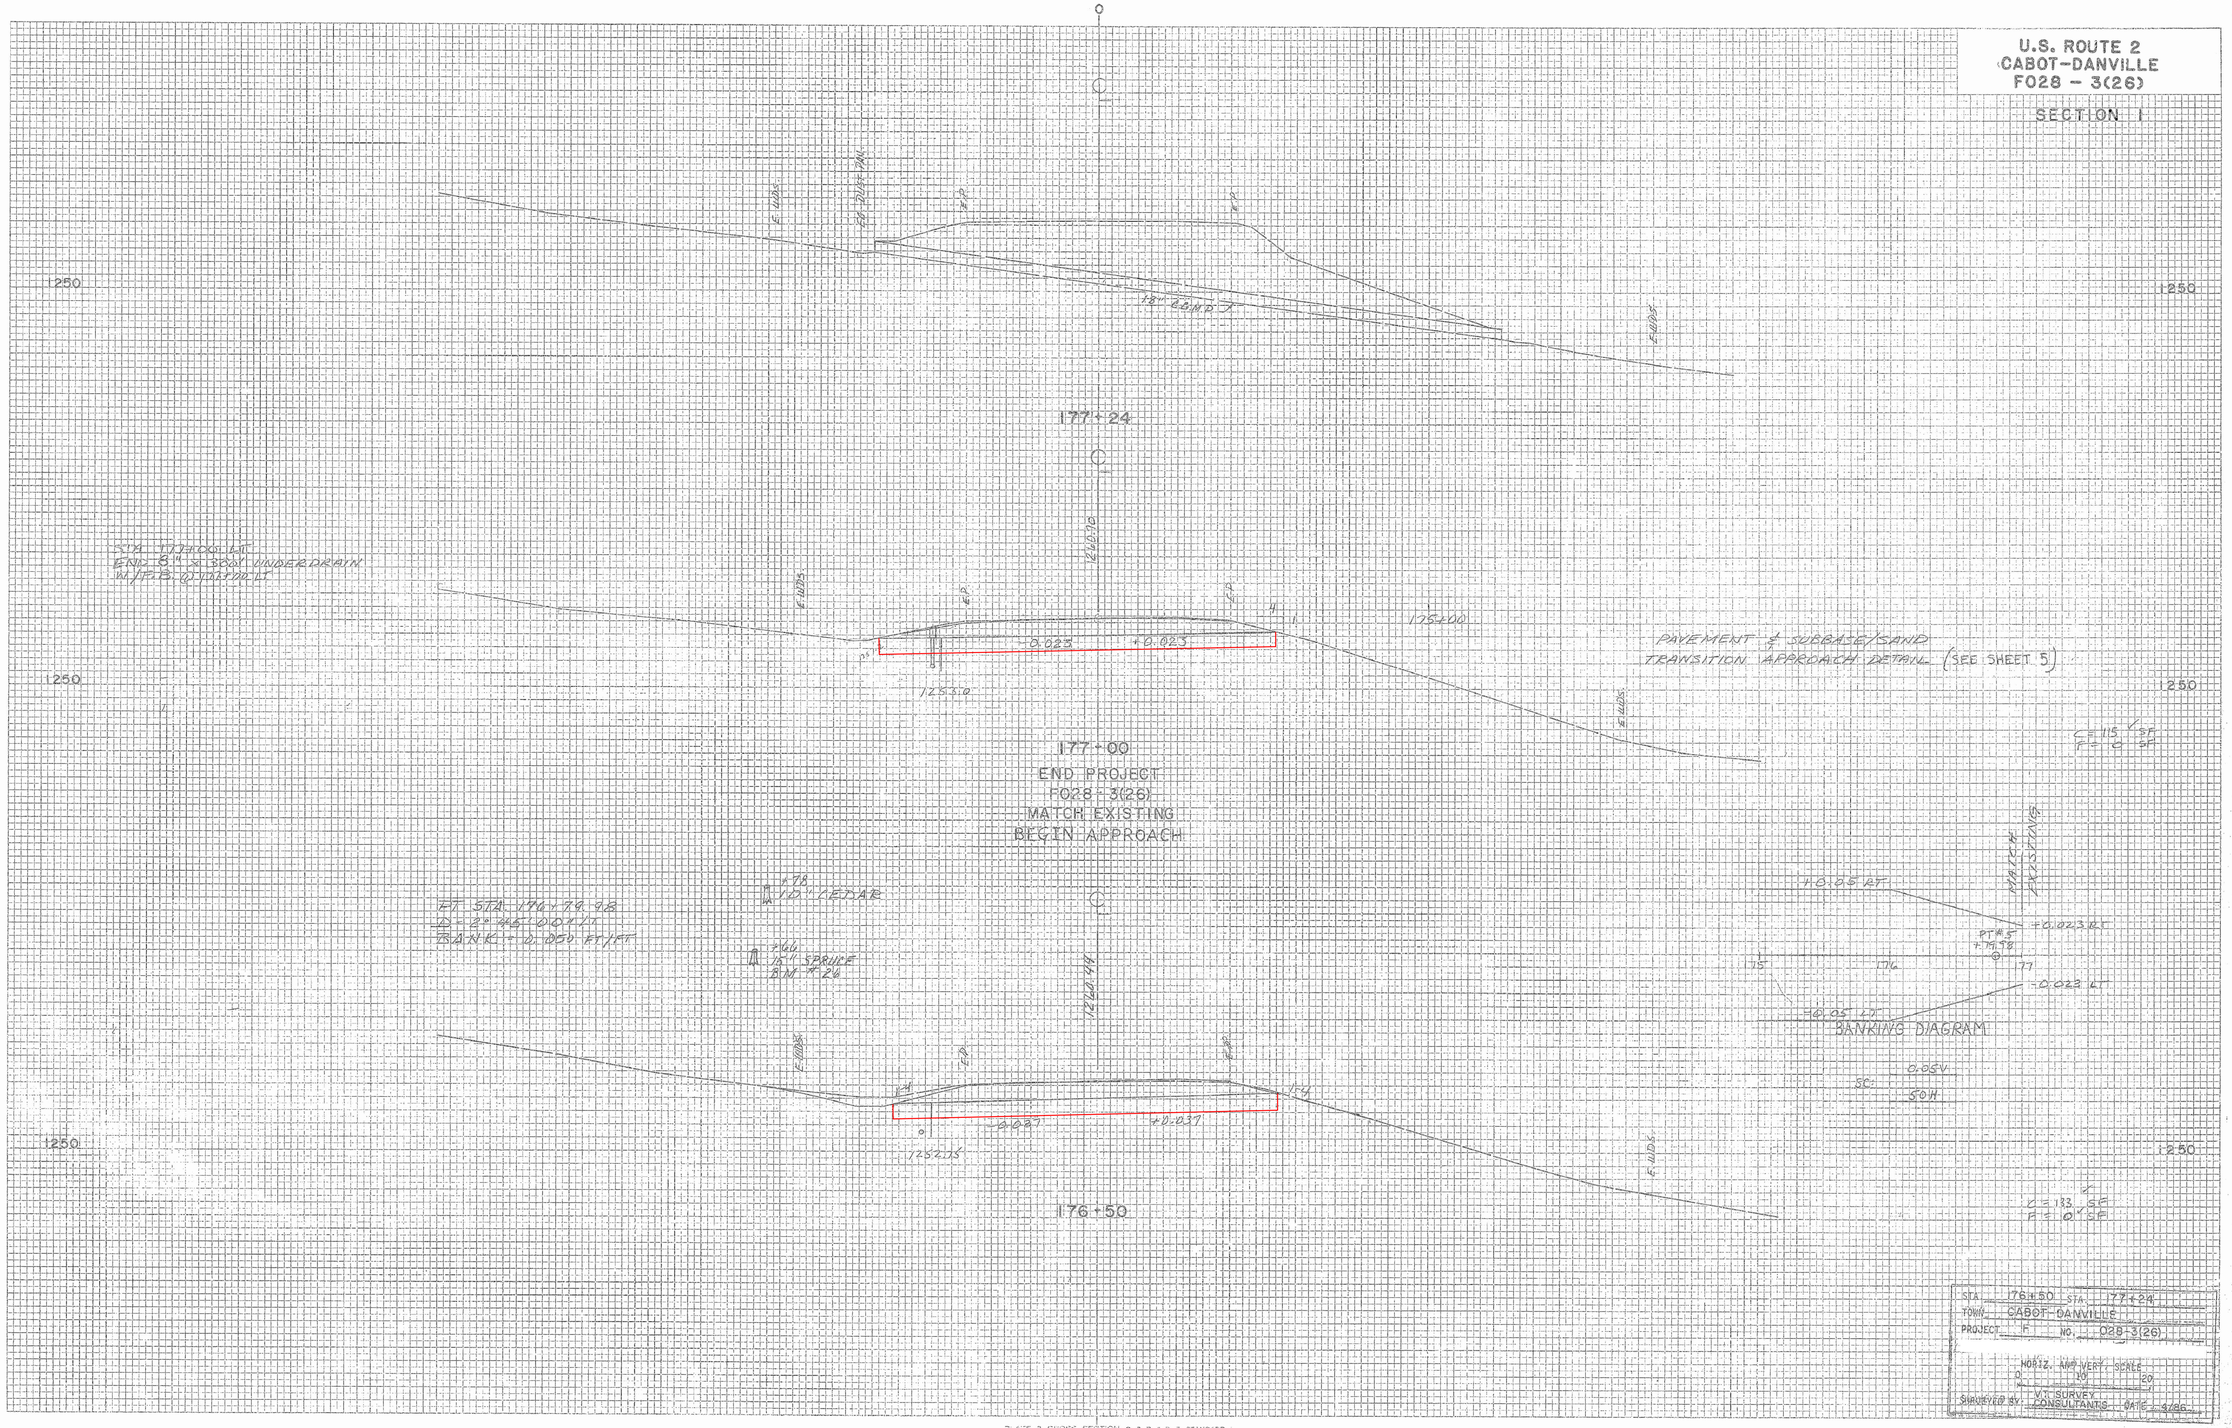

PLATE 3 CROSS SECTION O. P. R. & P. E. STANDARD
DETTON CORPORATION

PROJECT NAME:	CABOT-DANVILLE
PROJECT NUMBER:	FEGC F 028-3(26) C/I

FILE NAME: 78d058xs.dgn	PLOT DATE: 06-OCT-2010
PROJECT LEADER: K. ROBIE	DRAWN BY: I. SHEA
DESIGNED BY: I. SHEA	CHECKED BY: S. MENARD
MAINLINE CROSS SECTIONS 58	SHEET 190 OF 250