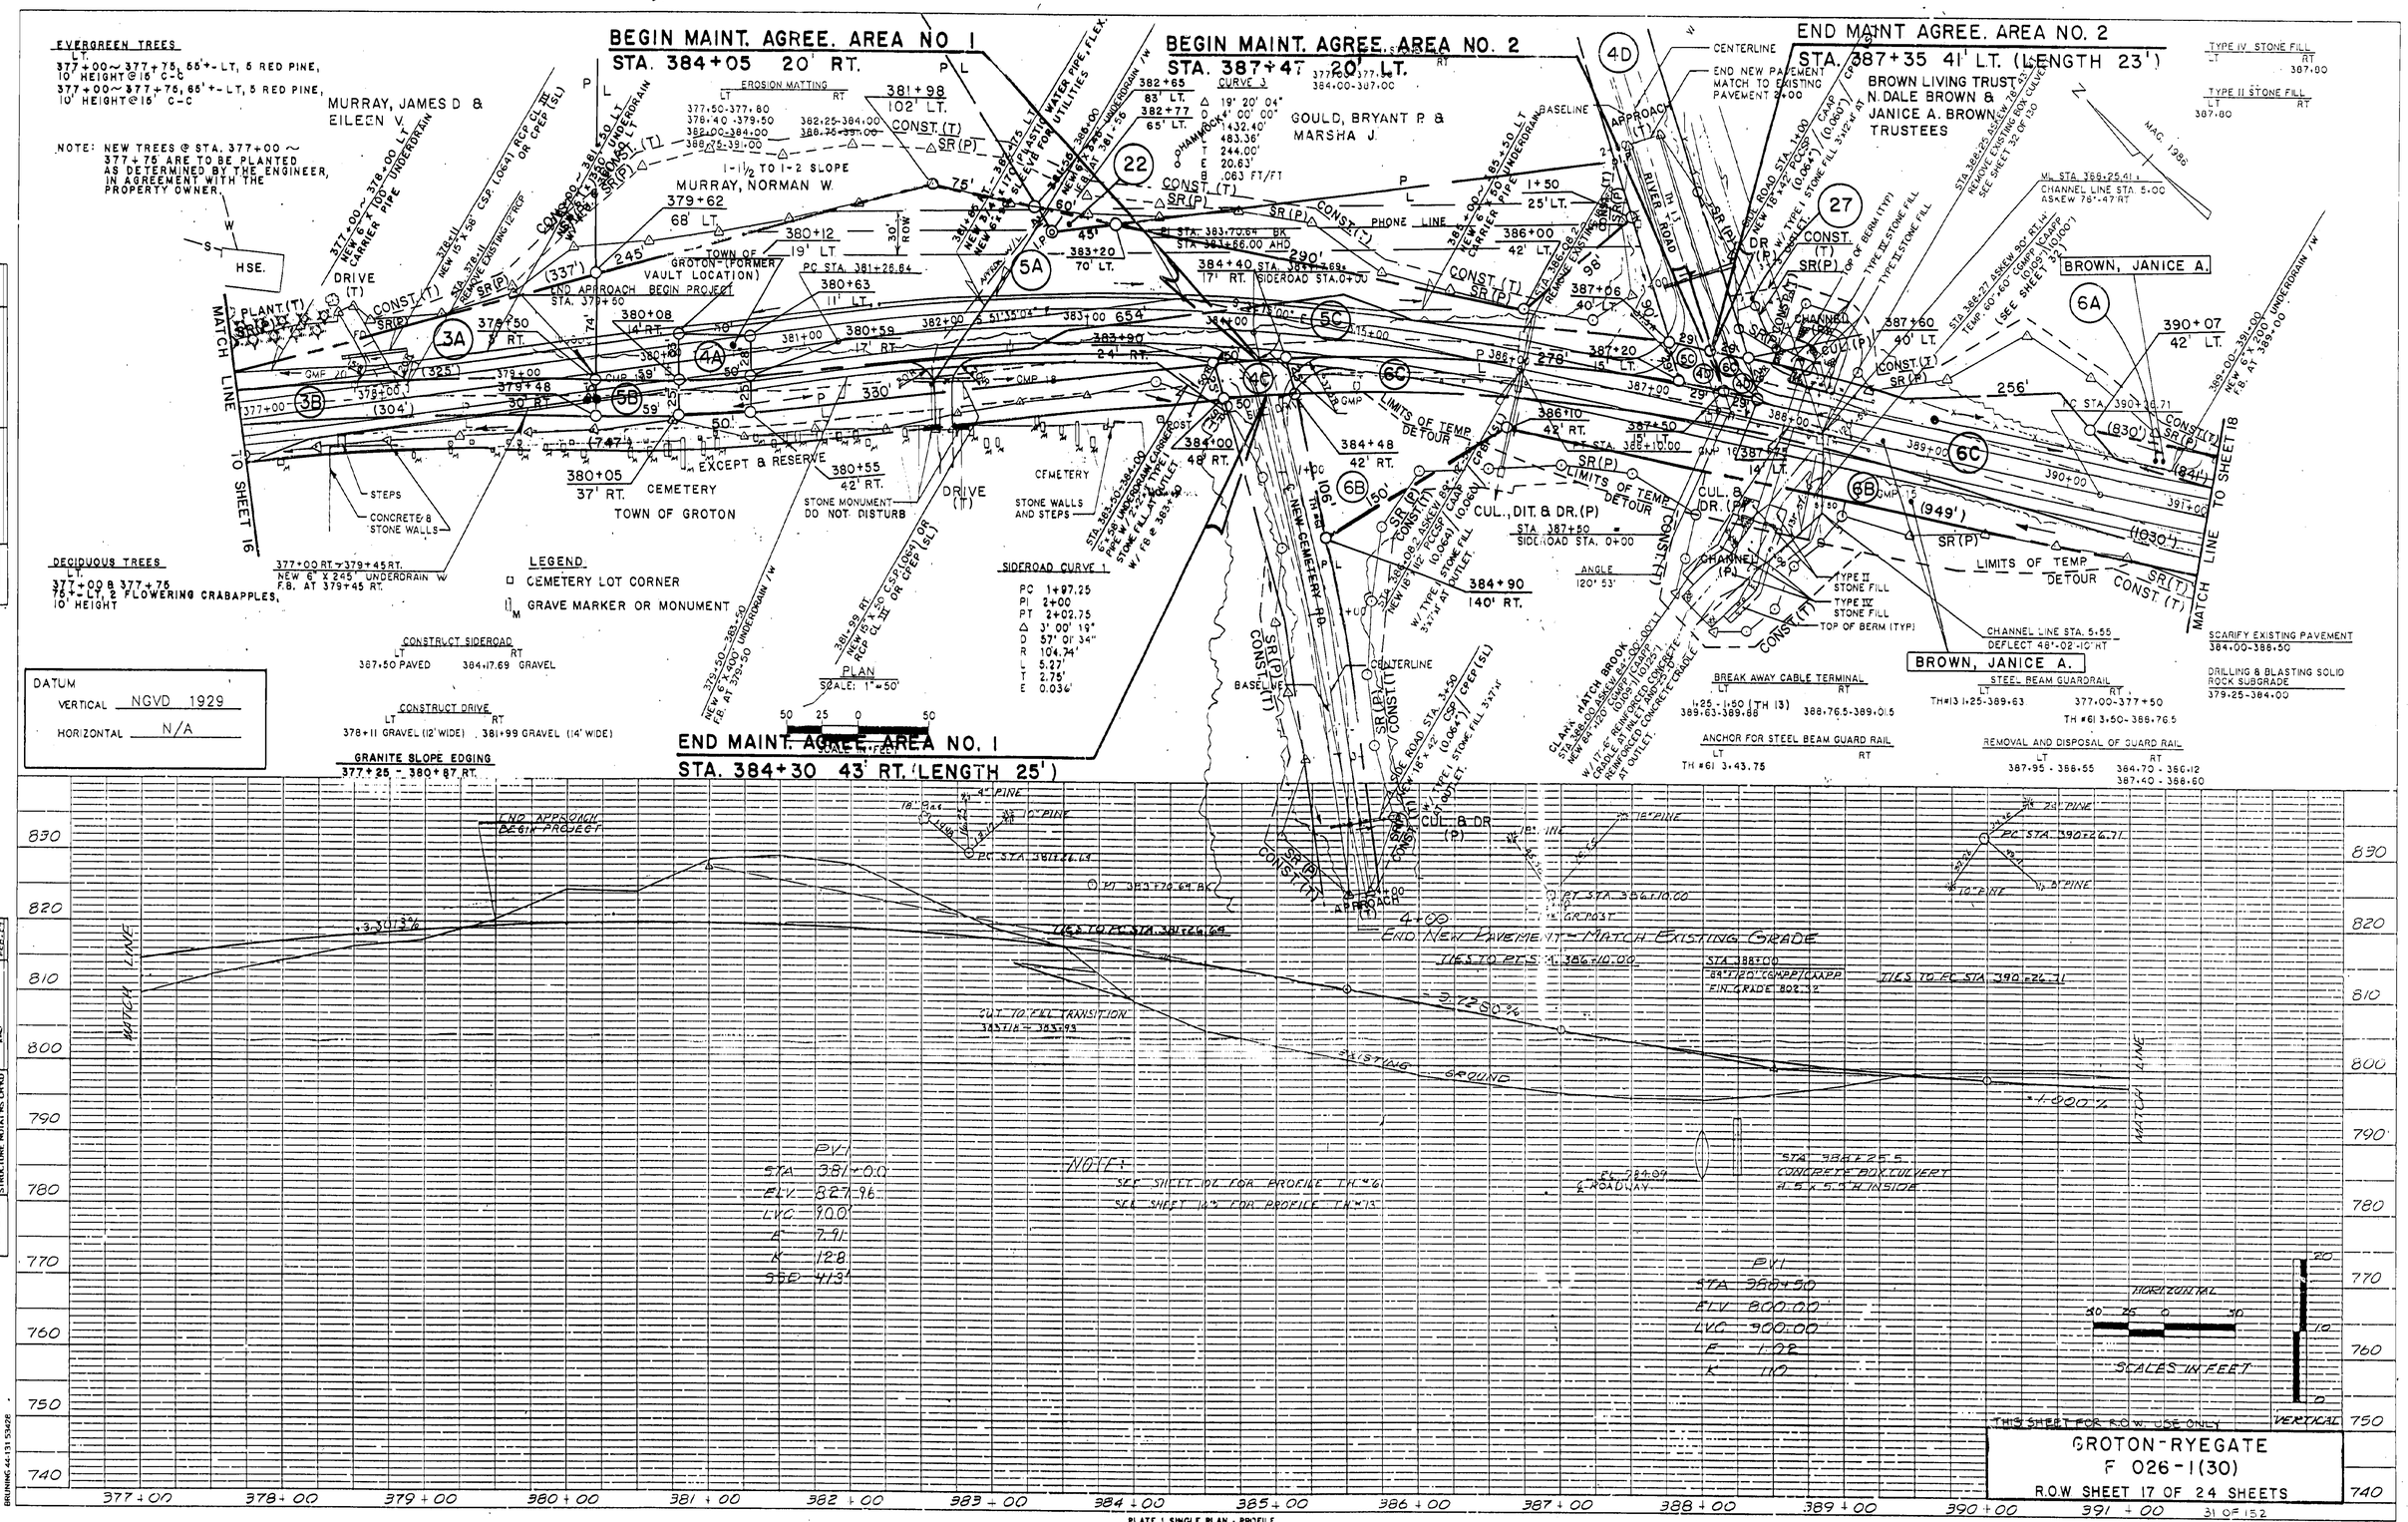
BEGIN MAINT. AGREE. AREA NO 1
STA. 384+05 20' RT.
BEGIN MAINT. AGREE. AREA NO. 2
STA. 387+47 20' LT.
END MAINT. AGREE. AREA NO. 2
STA. 387+35 41' LT. (LENGTH 23')
BROWN LIVING TRUST
N. DALE BROWN &
JANICE A. BROWN
TRUSTEES
MURRAY, JAMES D & EILEEN V.
MURRAY, NORMAN W.
GOULD, BRYANT P. & MARSHA J.
BROWN, JANICE A.
TOWN OF GROTON (FORMER VAULT LOCATION)
END APPROACH BEGIN PROJECT STA. 379+50
CEMETERY
TOWN OF GROTON
EXCEPT & RESERVE
STONE MONUMENT DO NOT DISTURB
STONE WALLS AND STEPS
CONCRETE & STONE WALLS
STEPS
HSE.
DRIVE (T)
PLANT (T)
MATCH LINE TO SHEET 16
MATCH LINE TO SHEET 18
EVERGREEN TREES
377+00~377+75, 55'+- LT, 5 RED PINE, 10' HEIGHT @ 15' C-C
377+00~377+75, 65'+- LT, 5 RED PINE, 10' HEIGHT @ 15' C-C
NOTE: NEW TREES @ STA. 377+00 ~ 377+75 ARE TO BE PLANTED AS DETERMINED BY THE ENGINEER, IN AGREEMENT WITH THE PROPERTY OWNER.
DECIDUOUS TREES
377+00 & 377+75
75'+- LT, 2 FLOWERING CRABAPPLES, 10' HEIGHT
LEGEND
CEMETERY LOT CORNER
GRAVE MARKER OR MONUMENT
CONSTRUCT SIDEROAD
LT 387+50 PAVED RT 384+17.69 GRAVEL
CONSTRUCT DRIVE
LT 378+11 GRAVEL (12' WIDE) RT 381+99 GRAVEL (14' WIDE)
GRANITE SLOPE EDGING
377+25 - 380+87 RT.
SIDEROAD CURVE 1
PC 1+97.25
PI 2+00
PT 2+02.75
Δ 3° 00' 19"
D 57° 0' 34"
R 104.74'
L 5.27'
T 2.75'
E 0.036'
PLAN
SCALE: 1" = 50'
DATUM
VERTICAL NGVD 1929
HORIZONTAL N/A
END MAINT. AGREE. AREA NO. 1
STA. 384+30 43' RT. (LENGTH 25')
BROWN, JANICE A.
CHANNEL LINE STA. 5+55 DEFLECT 48°-02'-10" RT
SCARIFY EXISTING PAVEMENT 384+00-388+50
DRILLING & BLASTING SOLID ROCK SUBGRADE 379+25-384+00
BREAK AWAY CABLE TERMINAL
ANCHOR FOR STEEL BEAM GUARD RAIL
TH #61 3+43.75
STEEL BEAM GUARDRAIL
TH #13 1+25-389+63
TH #61 3+50-388+76.5
REMOVAL AND DISPOSAL OF GUARD RAIL
LT 387+95 - 388+55 RT 384+70 - 386+12, 387+40 - 388+60
TYPE II STONE FILL
TYPE IV STONE FILL
TOP OF BERM (TYP)
LIMITS OF TEMP. DETOUR
CUL., DIT. & DR. (P)
CUL. & DR. (P)
CENTERLINE
END NEW PAVEMENT MATCH TO EXISTING PAVEMENT 0+00
APPROACH
RIVER ROAD
PHONE LINE
CLARK, HATCH BROOK
END NEW PAVEMENT - MATCH EXISTING GRADE
CUT TO FILL TRANSITION
EXISTING GROUND
NOTE: SEE SHEET 10C FOR PROFILE TH #61
SEE SHEET 10D FOR PROFILE TH #13
PV1 STA 381+00 ELV 827.96 LVC 100 E 7.91 K 12.8 SSD 413'
PV1 STA 388+50 ELV 800.00 LVC 900.00 E 1.08 K 110
PC STA 381+26.69
PC STA 390+26.71
STA 388+25.5 CONCRETE BOX CULVERT 4.5 x 5.5' INSIDE
HORIZONTAL
VERTICAL
SCALES IN FEET
THIS SHEET FOR R.O.W. USE ONLY
GROTON-RYEGATE
F 026-1(30)
R.O.W SHEET 17 OF 24 SHEETS
31 OF 152
PLATE 1 SINGLE PLAN - PROFILE
CHARLES BRUNING CO.
BRUNING 44-131 53428