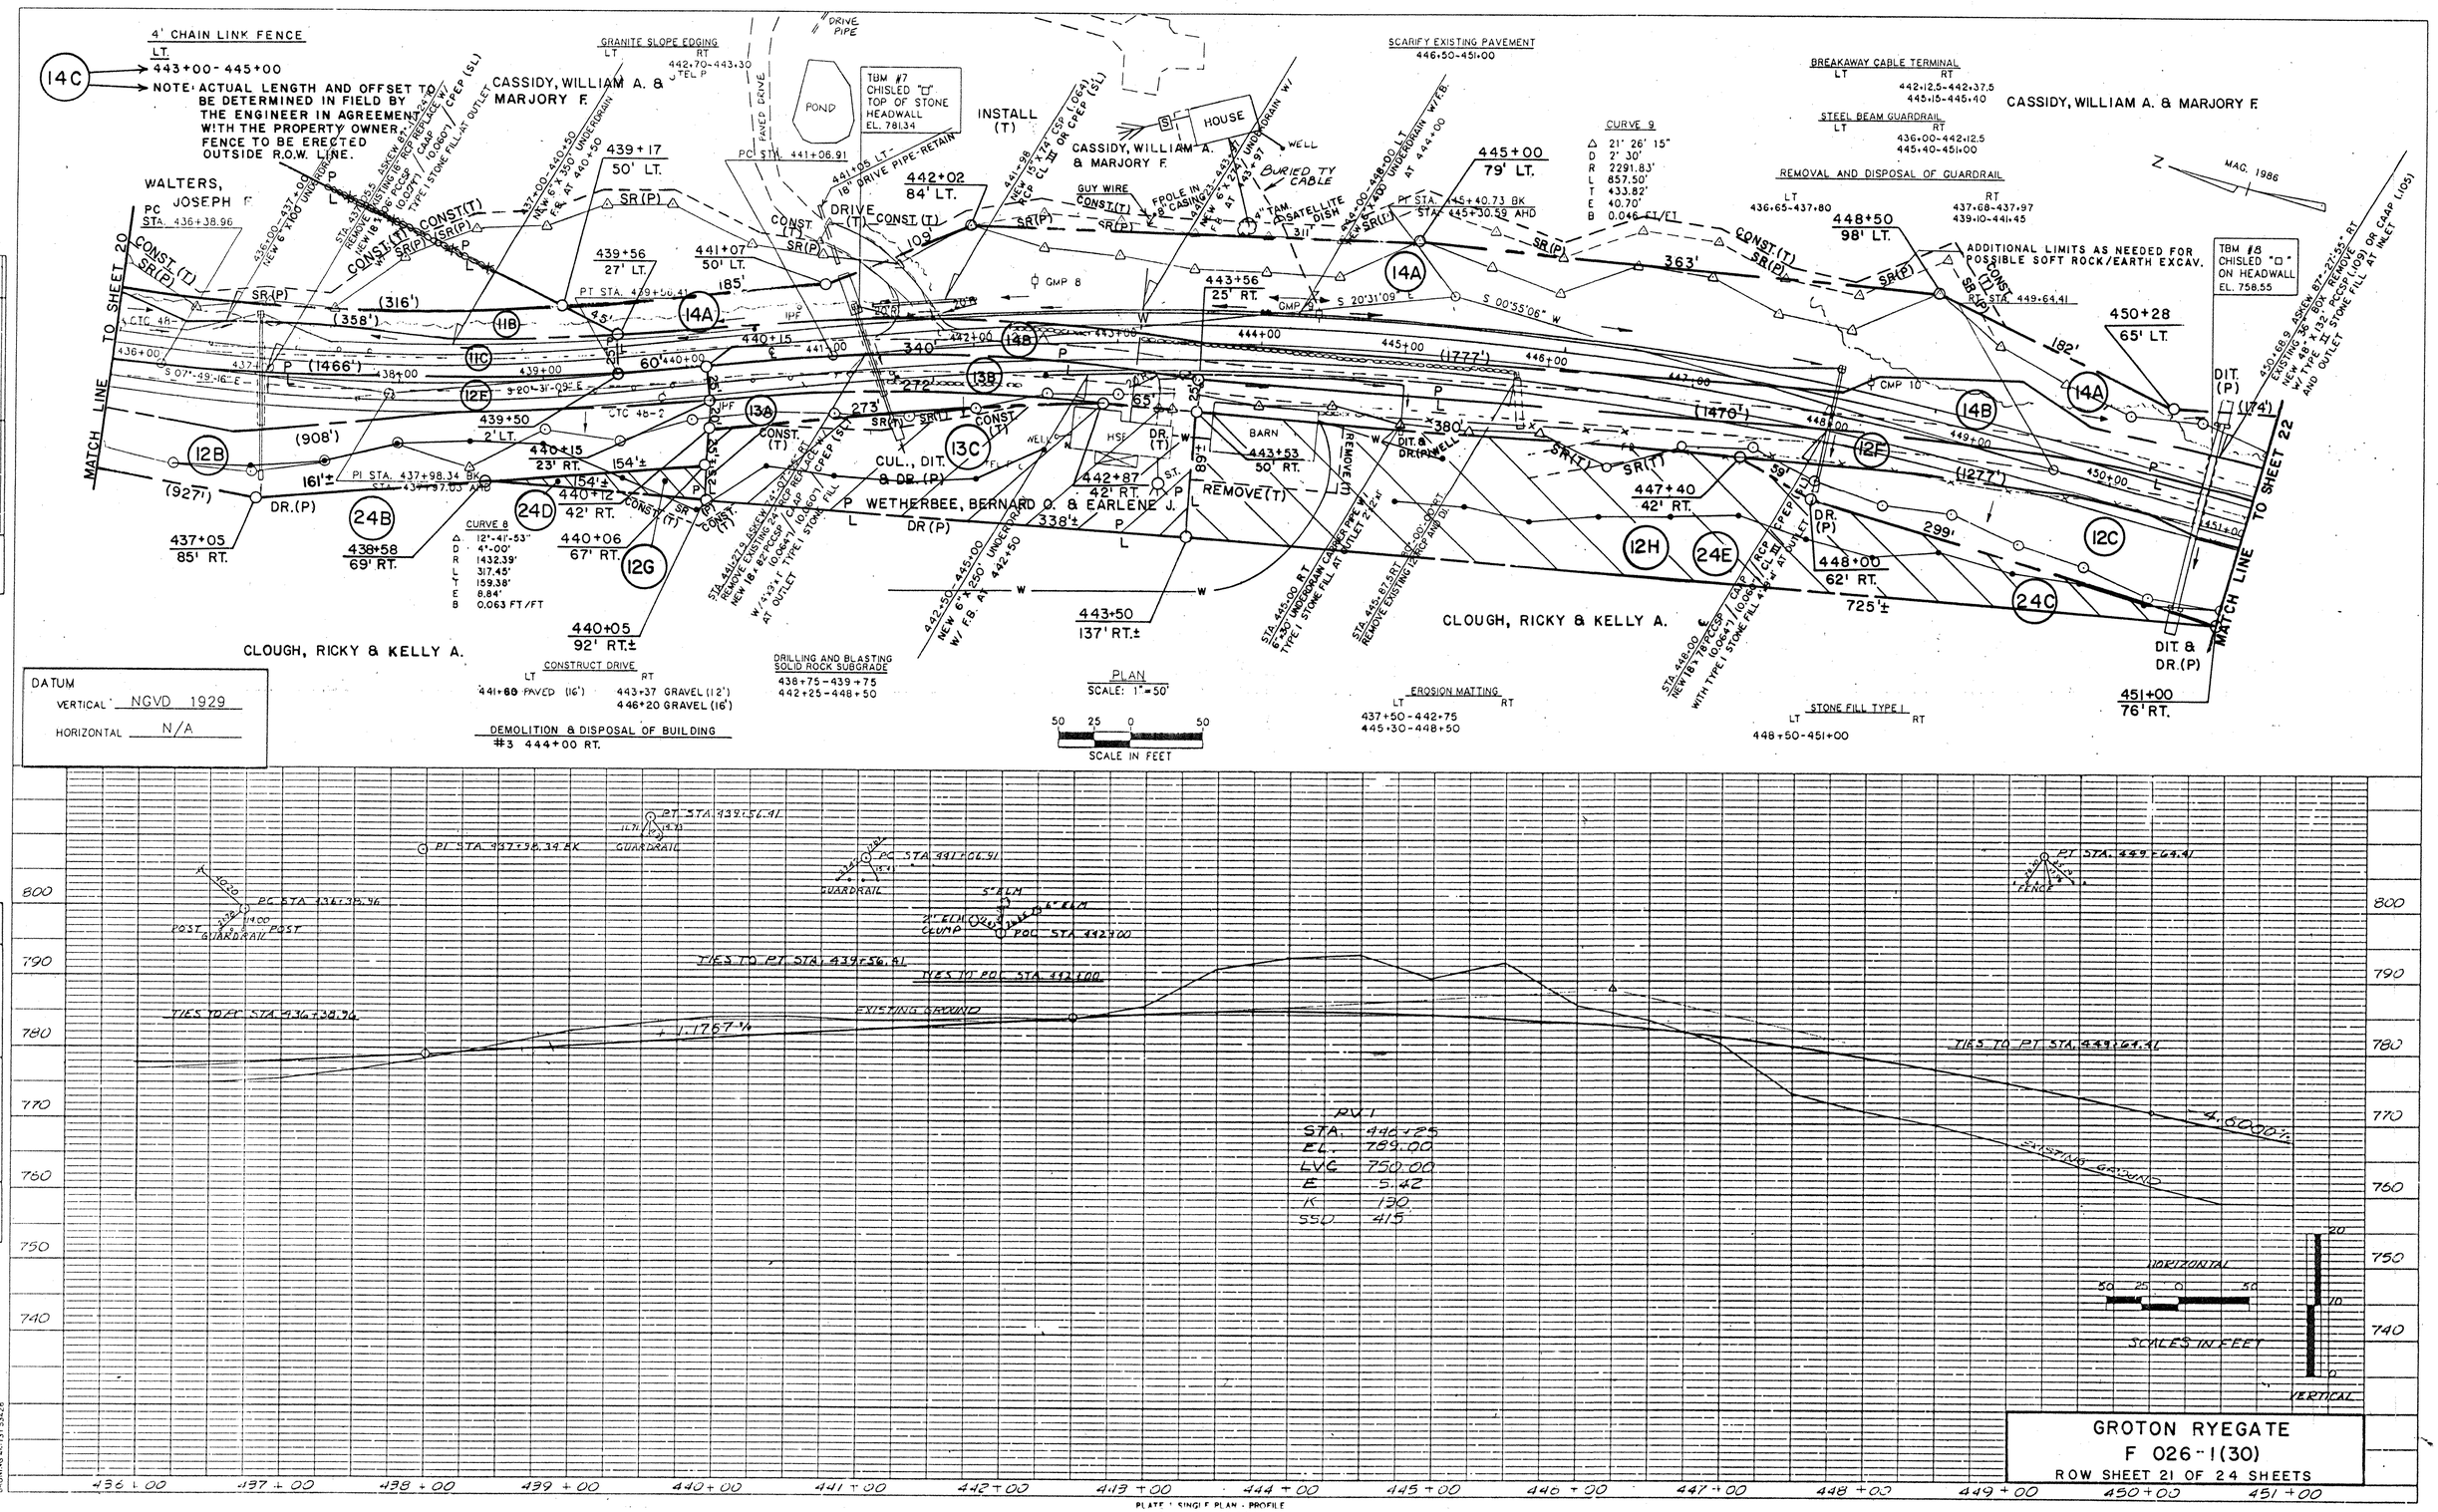
4' CHAIN LINK FENCE
LT
443+00- 445+00
NOTE: ACTUAL LENGTH AND OFFSET TO BE DETERMINED IN FIELD BY THE ENGINEER IN AGREEMENT WITH THE PROPERTY OWNER. FENCE TO BE ERECTED OUTSIDE R.O.W. LINE.
CASSIDY, WILLIAM A. & MARJORY F.
WALTERS, JOSEPH F.
MATCH LINE TO SHEET 20
MATCH LINE TO SHEET 22
GRANITE SLOPE EDGING
RT
442+70-443+30
POND
TBM #7 CHISLED "□" TOP OF STONE HEADWALL EL. 781.34
INSTALL (T)
HOUSE
WELL
BURIED TV CABLE
SATELLITE DISH
SCARIFY EXISTING PAVEMENT
446+50-451+00
BREAKAWAY CABLE TERMINAL
LT RT
442+12.5-442+37.5
445+15-445+40
STEEL BEAM GUARDRAIL
LT RT
436+00-442+12.5
445+40-451+00
REMOVAL AND DISPOSAL OF GUARDRAIL
LT RT
436+65-437+80 437+68-437+97
439+10-441+45
CURVE 9
Δ 21° 26' 15"
D 2° 30'
R 2291.83'
L 857.50'
T 433.82'
E 40.70'
B 0.046 FT/FT
MAG. 1986
ADDITIONAL LIMITS AS NEEDED FOR POSSIBLE SOFT ROCK/EARTH EXCAV.
TBM #8 CHISLED "□" ON HEADWALL EL. 758.55
CLOUGH, RICKY & KELLY A.
WETHERBEE, BERNARD O. & EARLENE J.
BARN
CUL., DIT. & DR. (P)
REMOVE (T)
CURVE 8
Δ 12°-41'-53"
D 4°-00'
R 1432.39'
L 317.45'
T 159.38'
E 8.84'
B 0.063 FT/FT
CONSTRUCT DRIVE
LT RT
441+88 PAVED (16') 443+37 GRAVEL (12') 446+20 GRAVEL (16')
DEMOLITION & DISPOSAL OF BUILDING
#3 444+00 RT.
DRILLING AND BLASTING SOLID ROCK SUBGRADE
438+75-439+75
442+25-448+50
EROSION MATTING
LT RT
437+50-442+75
445+30-448+50
STONE FILL TYPE I
LT RT
448+50-451+00
PLAN
SCALE: 1"=50'
SCALE IN FEET
DATUM
VERTICAL NGVD 1929
HORIZONTAL N/A
PLAN
SURVEYED
PLOTTED
ALIGNMENT CHECKED
R/W OF WAY CHECKED
NOTE BOOK NO.
PROFILE
GRADES CHECKED
B.M. NOTED
STRUCTURE NOTATIONS CHKD
PT STA. 439+56.41
PT STA. 437+98.34 BK
PC STA. 436+38.96
POST GUARDRAIL
TIES TO PT STA. 439+56.41
TIES TO PC STA. 437+00
TIES TO PT STA. 449+64.41
EXISTING GROUND
+1.17 67%
-4.60 00%
PVI
STA. 440+25
EL. 789.00
LVG 750.00
E 5.42
K 190
SSD 415
HORIZONTAL
SCALES IN FEET
VERTICAL
GROTON RYEGATE
F 026-1(30)
ROW SHEET 21 OF 24 SHEETS
PLATE 1 SINGLE PLAN - PROFILE
BRUNING 46-131 53426