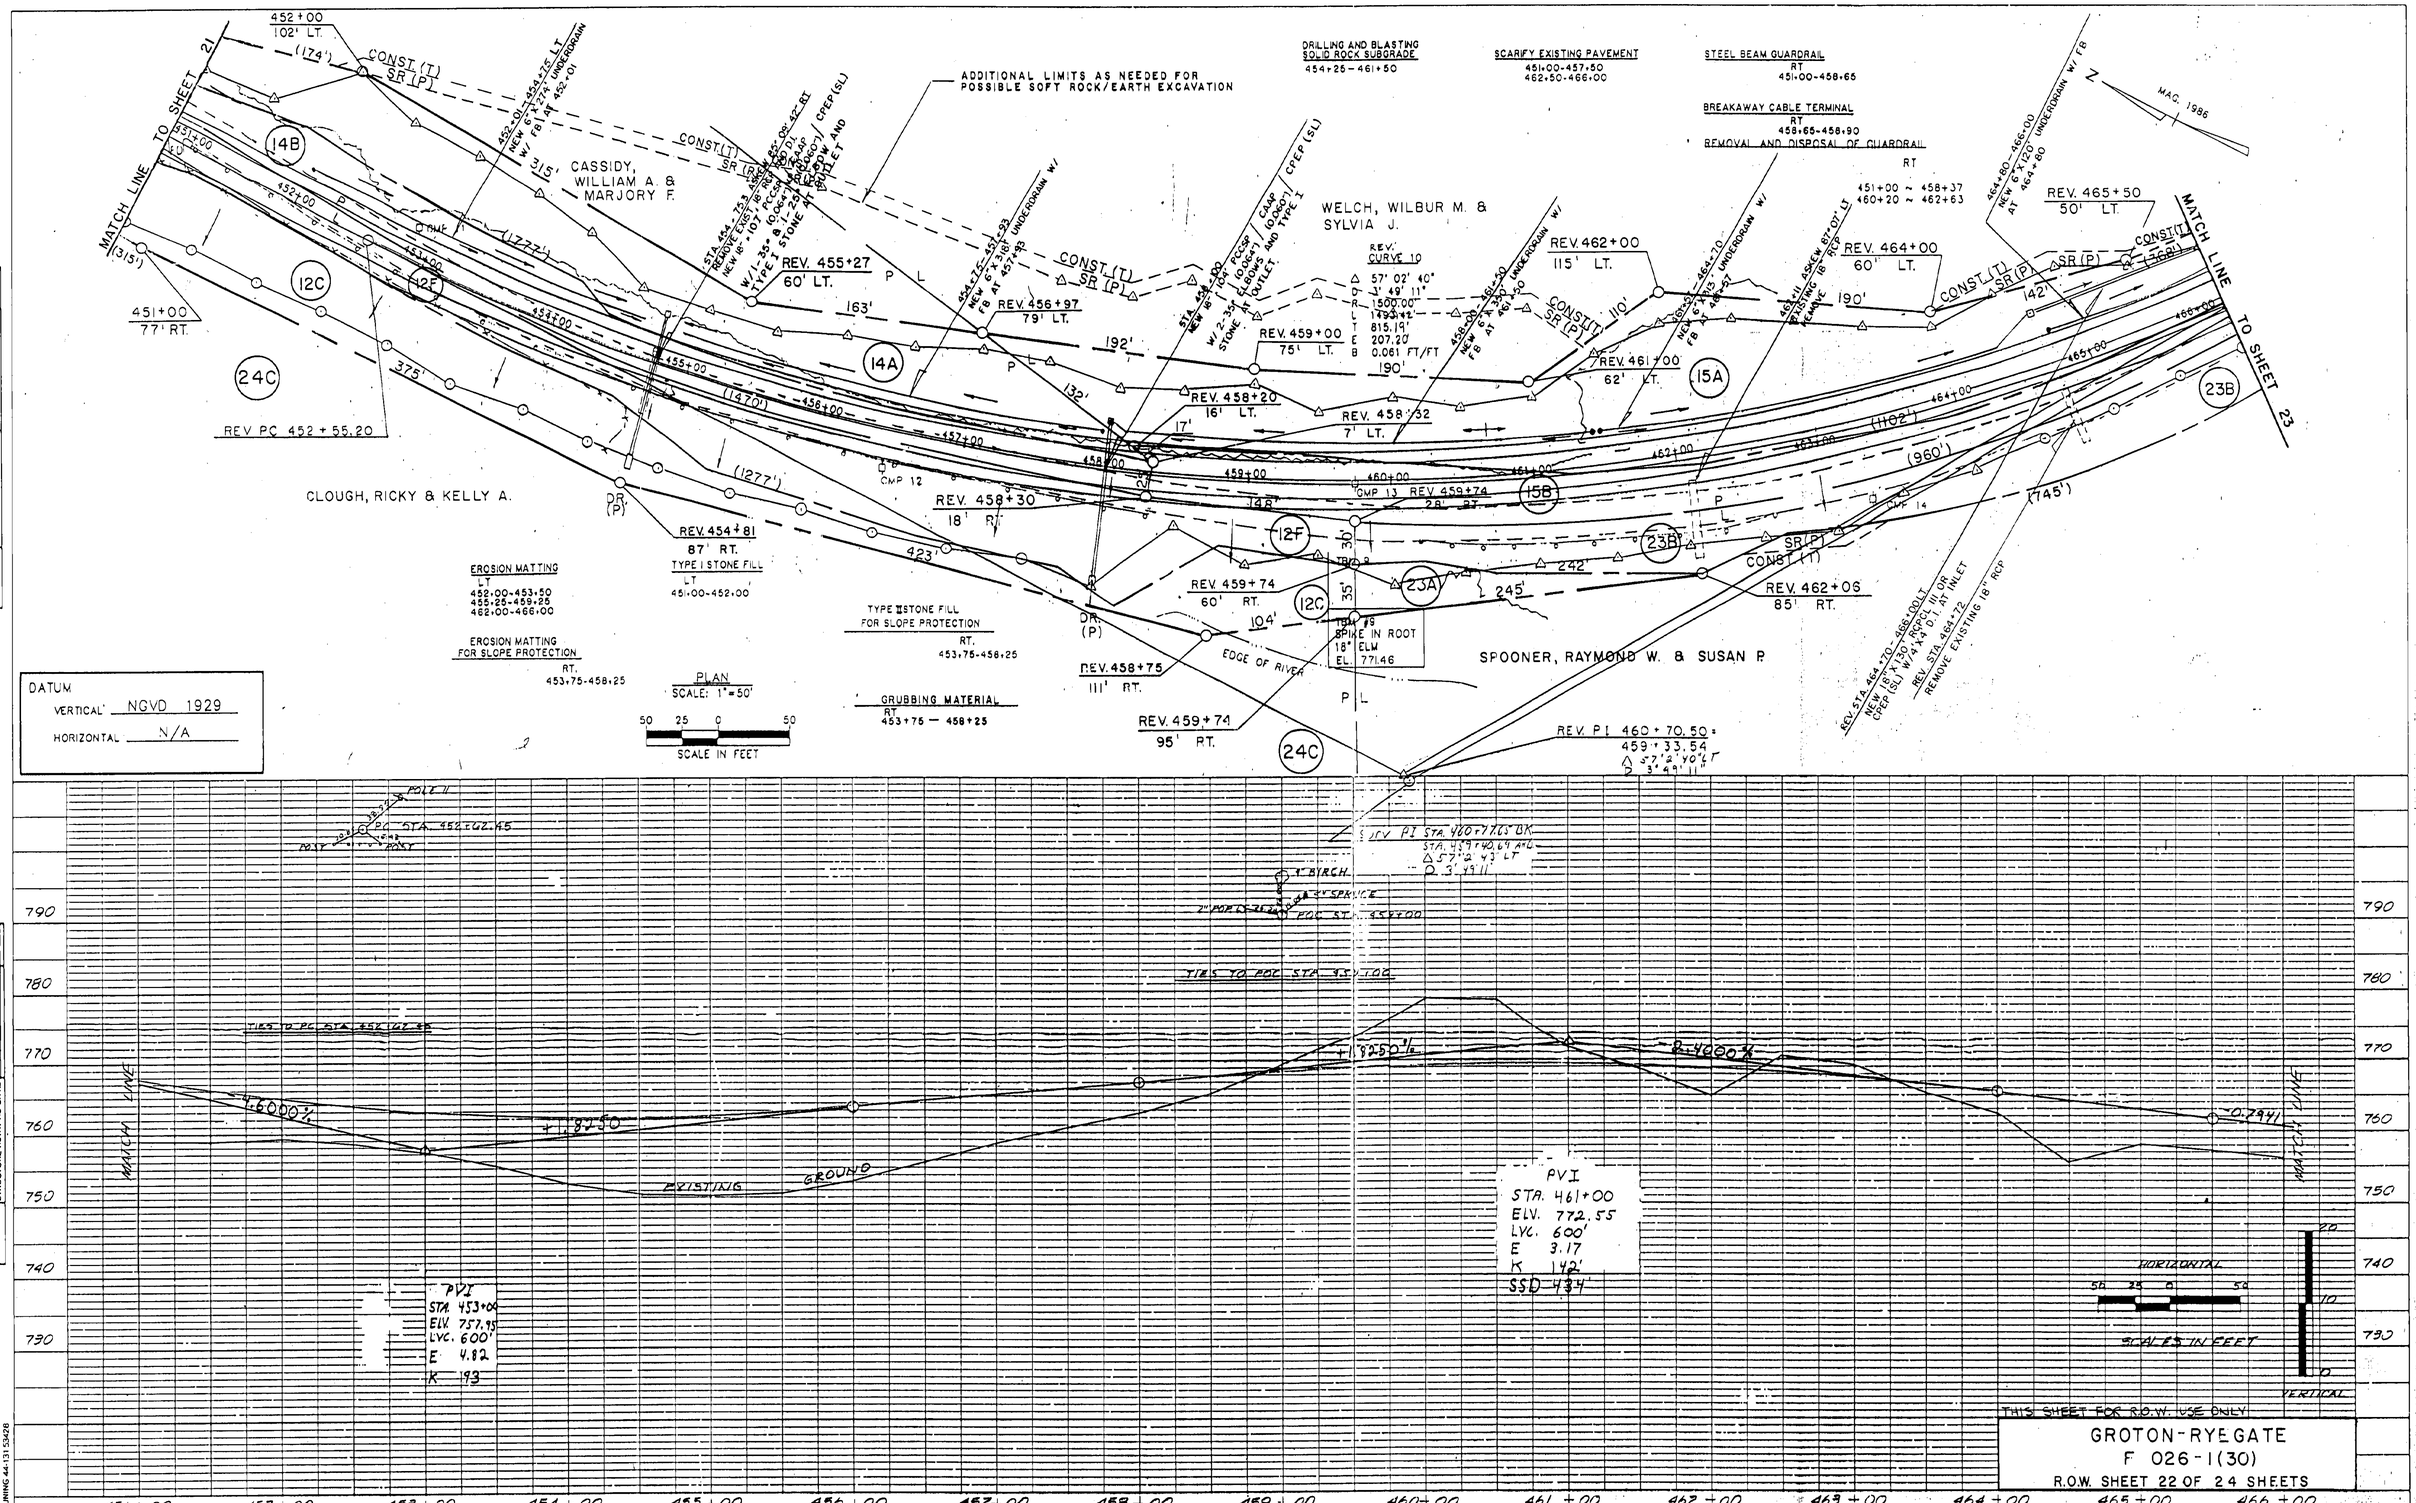

PLAN	BY	DATE
SURVEYED		
PLOTTED	DRC, JMF, GLR	OCT. 84
ALIGNMENT CHECKED	DRC	DEC. 84
RT. OF WAY CHECKED		
NOTE BOOK NO.		

PROFILE	BY	DATE
SURVEYED		
PLOTTED	CAD, DRC	FEB. 85
GRADES CHECKED	CAD	FEB. 85
B. M.'S NOTED	CAD	FEB. 85
STRUCTURE NOTAT'NS CH'KD	CAD, DRC	FEB. 85
NOTE BOOK NO.	CAD	FEB. 85

THIS SHEET FOR R.O.W. USE ONLY

GROTON-RYEGATE
F 026-1(30)
R.O.W. SHEET 22 OF 24 SHEETS

BRUNING 44-131 53428

PLATE I SINGLE PLAN - PROFILE
CHARLES BRUNING CO.