PLAN		BY	DATE
	SURVEYED	DBC, WAB, GLB	OCT. 86
	PLOTTED	DBC	DEC. 86
	GRADES CHECKED		
	ALIGNMENT CHECKED		
NOTE BOOK	RT. OF WAY CHECKED		
NO. 610			

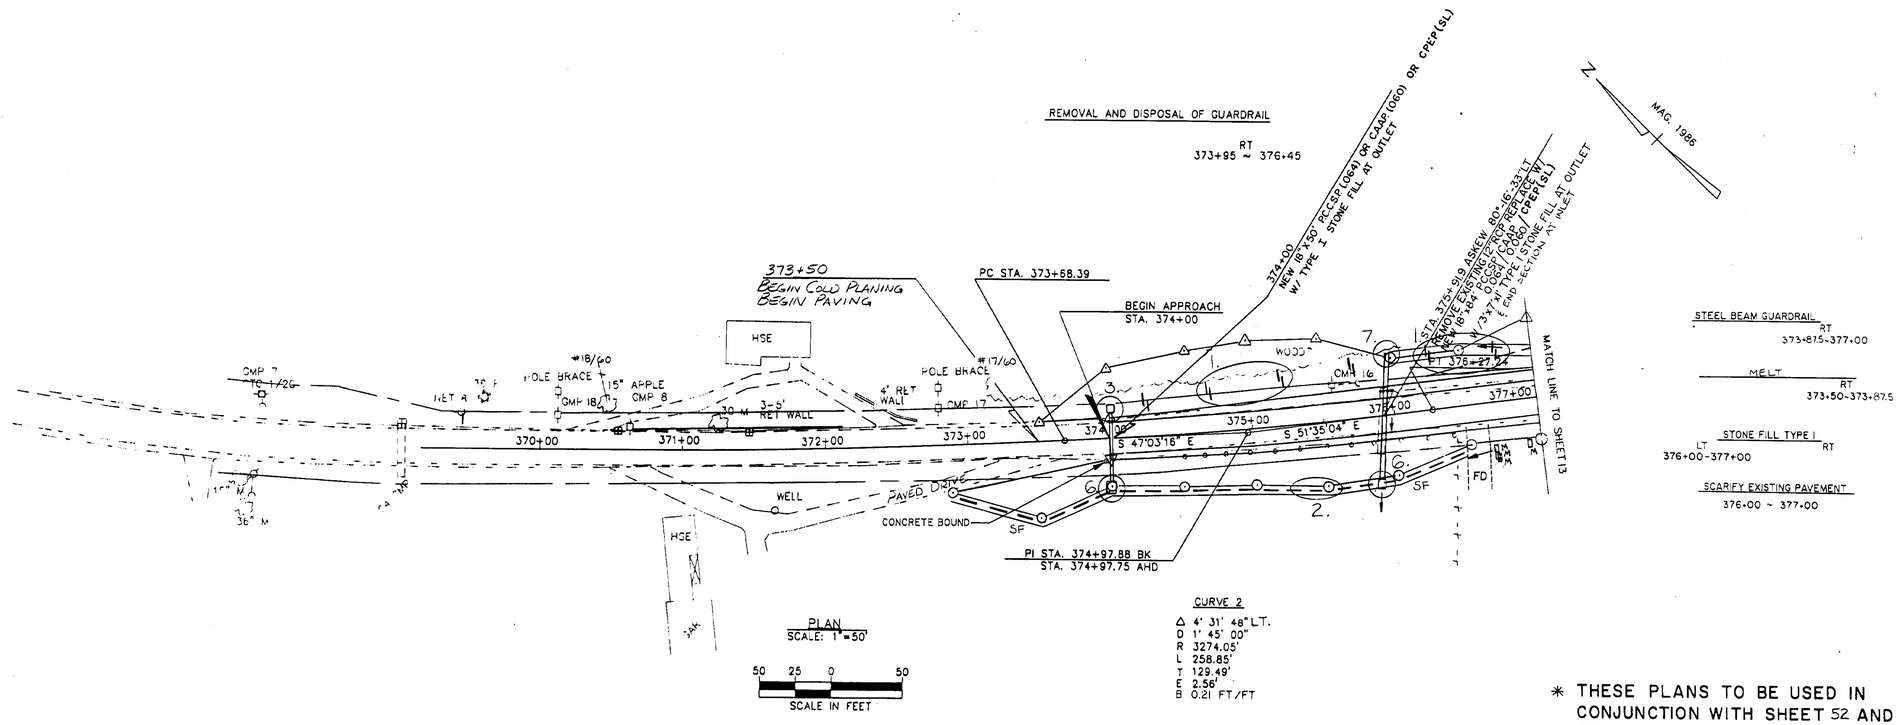

DATUM

VERTICAL NGVD 1929

HORIZONTAL N/A

CURVE 2

Δ 4° 31' 48" LT.
D 1° 45' 00"
R 3274.05'
L 258.85'
T 129.49'
E 2.56'
B 0.21 FT/FT

* THESE PLANS TO BE USED IN CONJUNCTION WITH SHEET 52 AND STANDARD SHEETS T-1 & T-2 *

SF = GEOTEXTILE FOR SILT FENCE

PROFILE		BY	DATE
	SURVEYED	DBC	APR. 85
	PLOTTED	GLB	FEB. 86
	GRADES CHECKED	AWJ	FEB. 87
NOTE BOOK	BRIDGE		
NO. 382	STRUCTURE NOTATIONS CHKD	DBC, DBK	FEB. 87

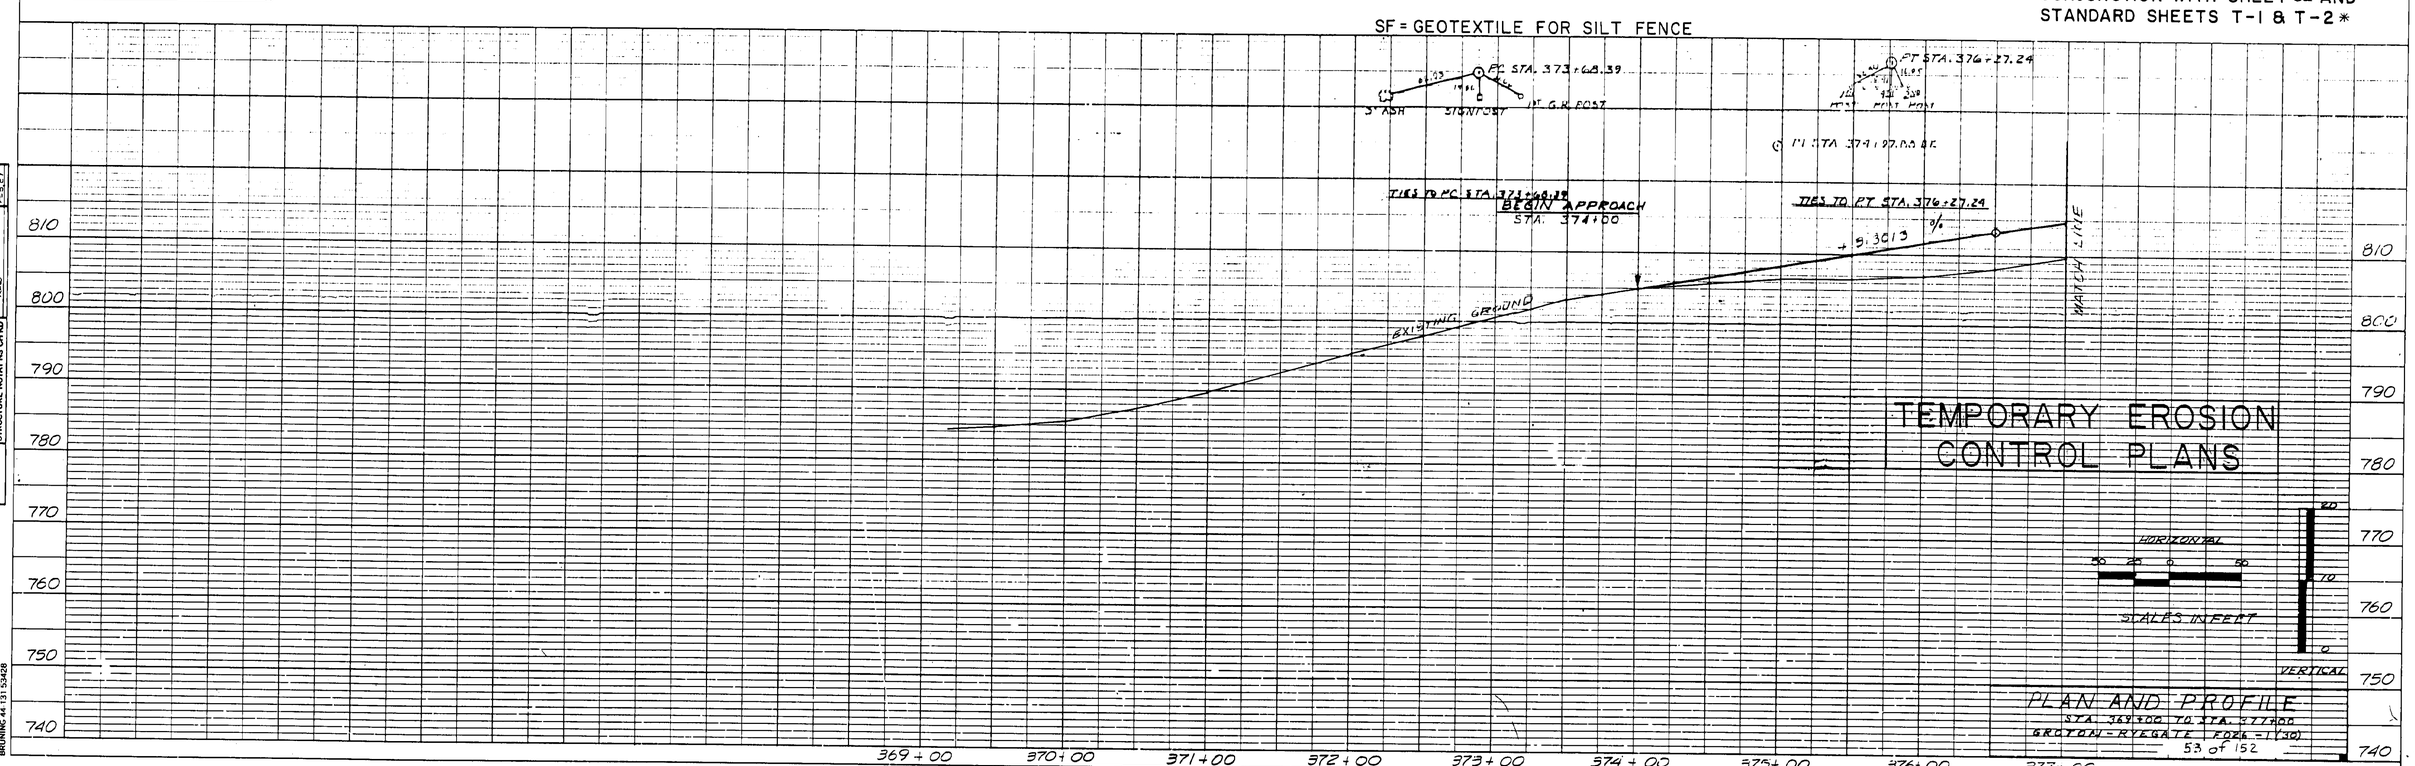

PLAN AND PROFILE
STA. 369+00 TO STA. 377+00
GROTON - RYEGATE FOR 6-1(30)
53 of 152

BRUNING 44-131 53428

PLATE 1 SINGLE PLAN - PROFILE
CHARLES BRUNING CO.