PLAN	BY	DATE
SURVEYED	D.R.C.	MAR. 1998
PLOTTED	A.L.H.	OCT. 1998
ALIGNMENT CHECKED	D.R.C.	DEC. 1998
R.T. OF WAY CHECKED		
NOTE BOOK NO.		

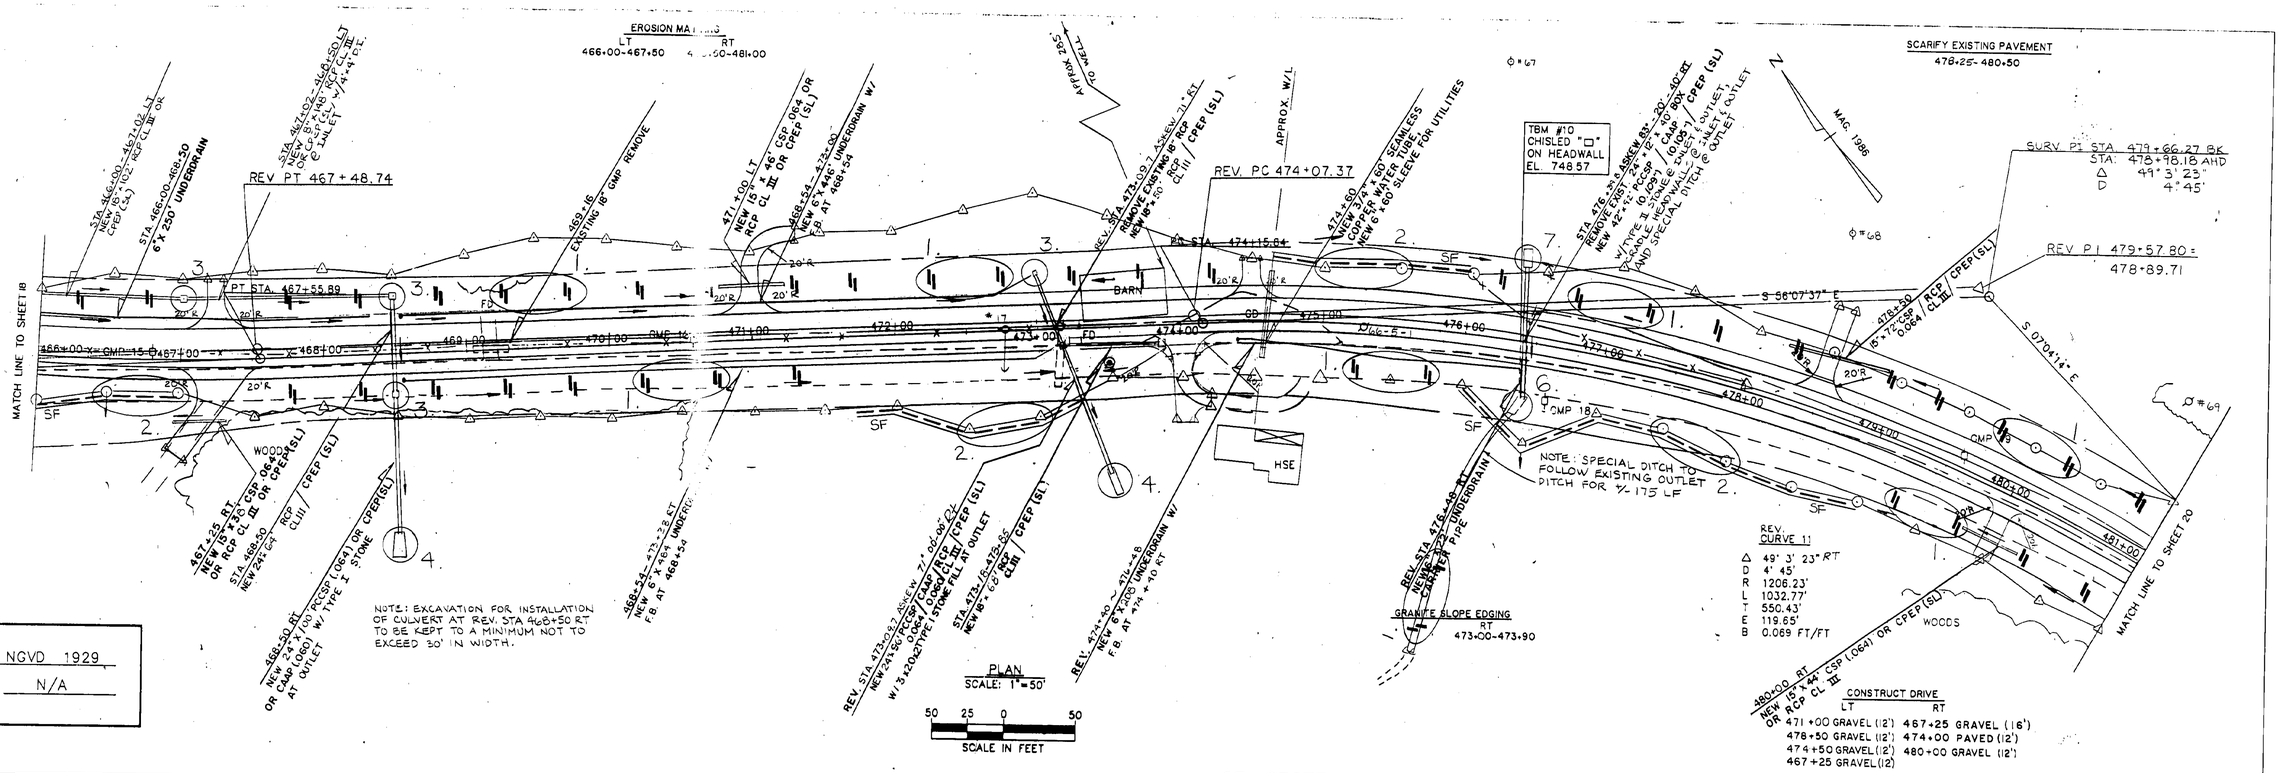

DATUM
VERTICAL NGVD 1929
HORIZONTAL N/A

SF = GEOTEXTILE FOR SILT FENCE

PROFILE	BY	DATE
SURVEYED	E.S.	FEB. 1998
PLOTTED	D.R.C.	FEB. 1998
GRADES CHECKED	R.A.U.	FEB. 1998
S.M.A. NOTED	E.S.	DEC. 1998
SIGNATURE NOTATING CHKD	S.M.A.	DEC. 1998
NOTE BOOK NO.		

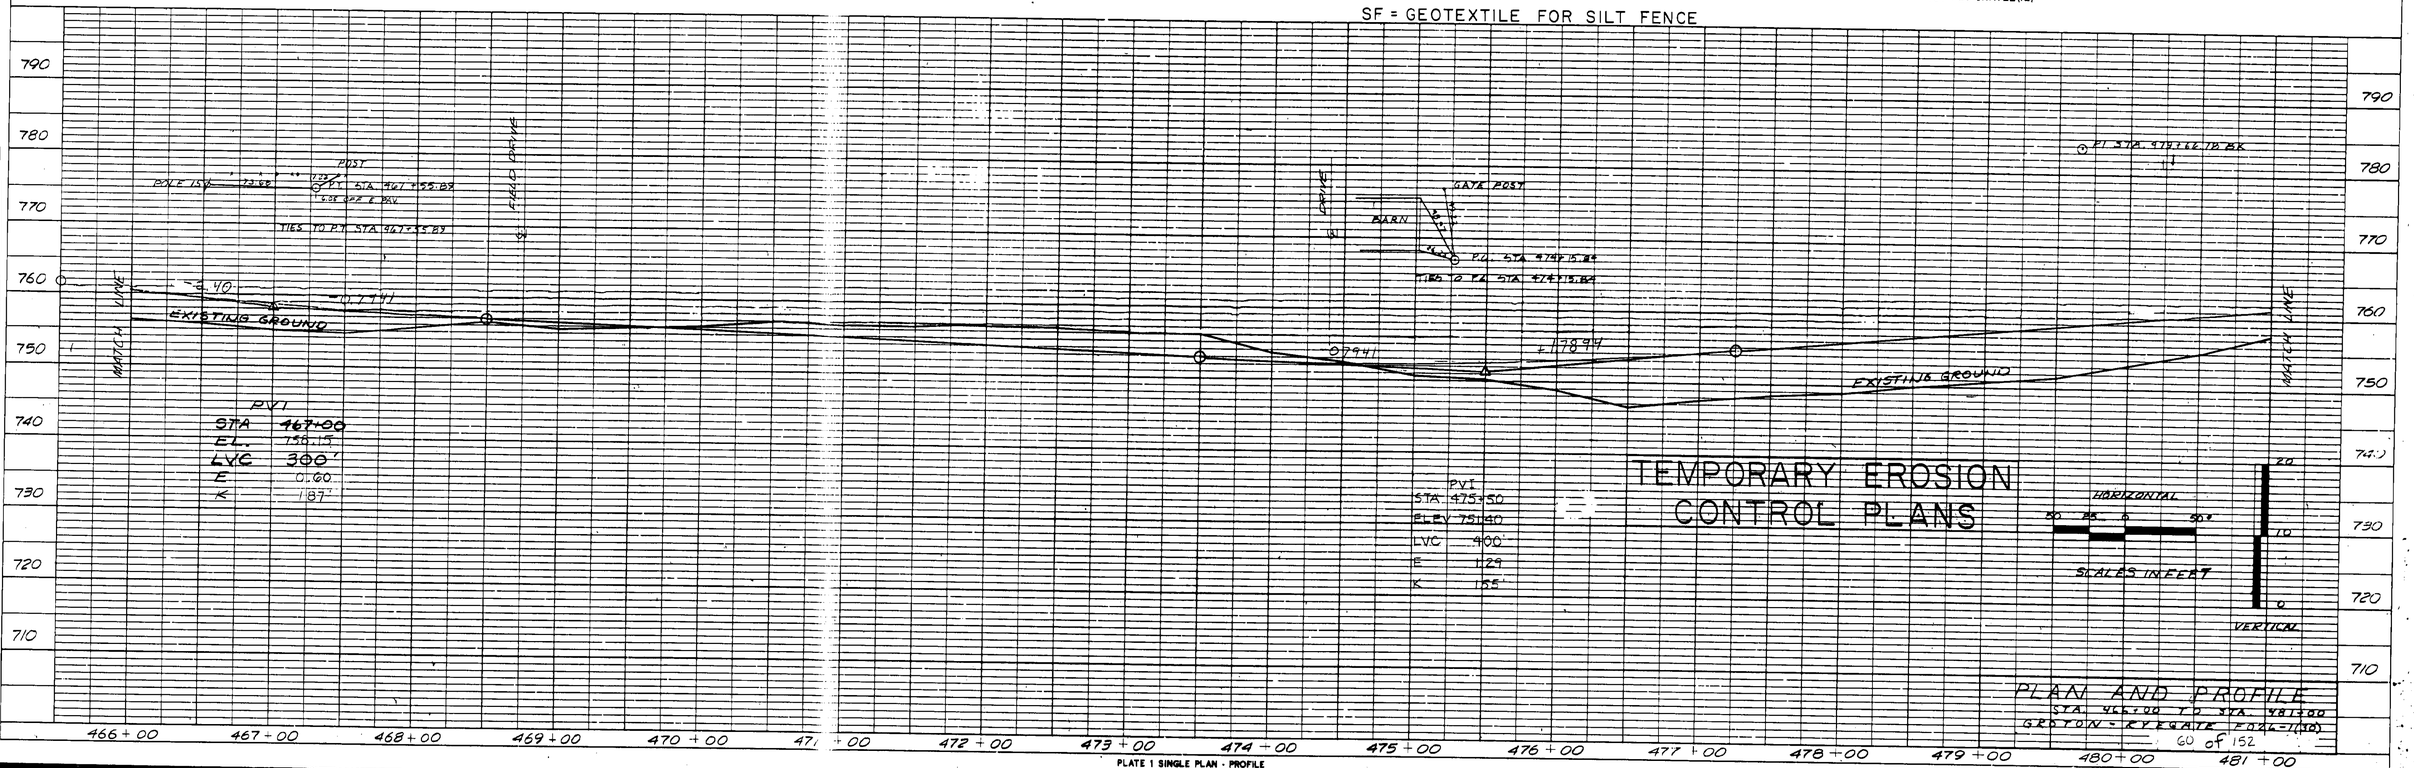

BRUNING 44-131 53428

PLATE 1 SINGLE PLAN - PROFILE
CHARLES BRUNING CO.