STATE OF VERMONT
AGENCY OF TRANSPORTATION

TRAFFIC SIGN SUMMARY SHEET

MILEMARKER, STATION, OR SIGN NUMBER	SIGN LEGEND	SIGN DIMENSIONS EA	WIDTH (in)	HEIGHT (in)	NEW & SALVAGED SIGNS "A"	"B"	SALV SIGN	SALV TIS	EXIST POST RETAIN	SALVAGE	NEW SIGN POSTS NO. OF POSTS	FLANGED CHANNEL lb/ft 1.12	2.0	3.0	SQUARE STEEL (in) lb/ft 1.75 1.88	2.0 2.16	2.5 3.35	ANCHOR	SLEEVE	TUBULAR ALUMINUM Ø (in) lb/ft 3.0 1.3	4.0 1.7	4.0 MOD 1.7	TUBULAR STEEL Ø (in) FOUND-ATION	lb/ft 3.0 7.6	3.5 9.0	4.0 10.8	5.0 14.6	W-SHAPE STEEL FTG. SIZE 24"	30"	WEIGHT	POST SIZE	SIGN REFRAMED	REMARKS	SIGN DETAIL DETAIL ON SHEET NUMBER	STD. SHEET NUMBER
488+30 RT	ERECT SALVAGE						9/2/98 L				1 ~~2~~ 18			9/2/98 X 54			~~X~~	~~1~~															NEW POSTS ONLY		
	ERECT SALVAGE	~~1~~	~~24~~	~~36~~	~~6.0~~		9/2/98 1																										VR-023		E-144
431+00 RT	STOP		30	30	6.25																												ORDERED FOR TH. TH THROWN UP. PAYED FOR SIGN GAVE TO STATE		
490+65 LT	SPEED LIMIT 50	1	24	30	9/2/98 5.0						1 14			9/2/98 X 42			~~X~~	~~1~~															R2-1		E-142
	SHEET 66 SHEET 67				41.83 36.33		2							174 306																					
	SHEET 68				39.535									300																					
	SHEET 69				11.25		2							96																					
	PROJECT TOTALS				128.945		4							876																					

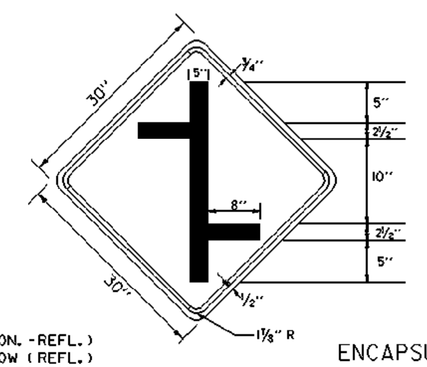

ENCAPSULATED LENS

COLORS

LEGEND - BLACK (NON.-REFL.)
BACKGROUND - YELLOW (REFL.)
REFER TO STD. E-150 FOR
MATERIALS AND SPECIFICATIONS

DETAIL B
NOT TO SCALE

FINAL POST LENGTHS ARE TO BE DETERMINED IN THE FIELD. POST SIZES ARE COMPUTED BASED ON INFORMATION FURNISHED ON THE STANDARD SHEETS AND THE TRAFFIC & SAFETY DIVISION'S "SIGN POST DESIGN GUIDELINE."

TOTALS	SF	SF	EA.	SF		LB	LB	LB	EA.	LB	EA.	EA.	LB
	~~11.0~~ 11.25		~~1~~ 2			~~148~~ 96	~~148~~						

PROJECT: GROTON - RYEGATE	PROJECT NO.: STP F 026-1(30)
DESIGN FILE NAME: /sqdc/78d073/dd073.dgn IPARM FILE NAME: dd073ts4.i SURVEYED BY: SQUAD LEADER: S. MENARD	PLOT DATE: 13-MAR-1997 SURVEY DATE: DRAWN BY: B. MCAVOY SHEET: 69 OF 152