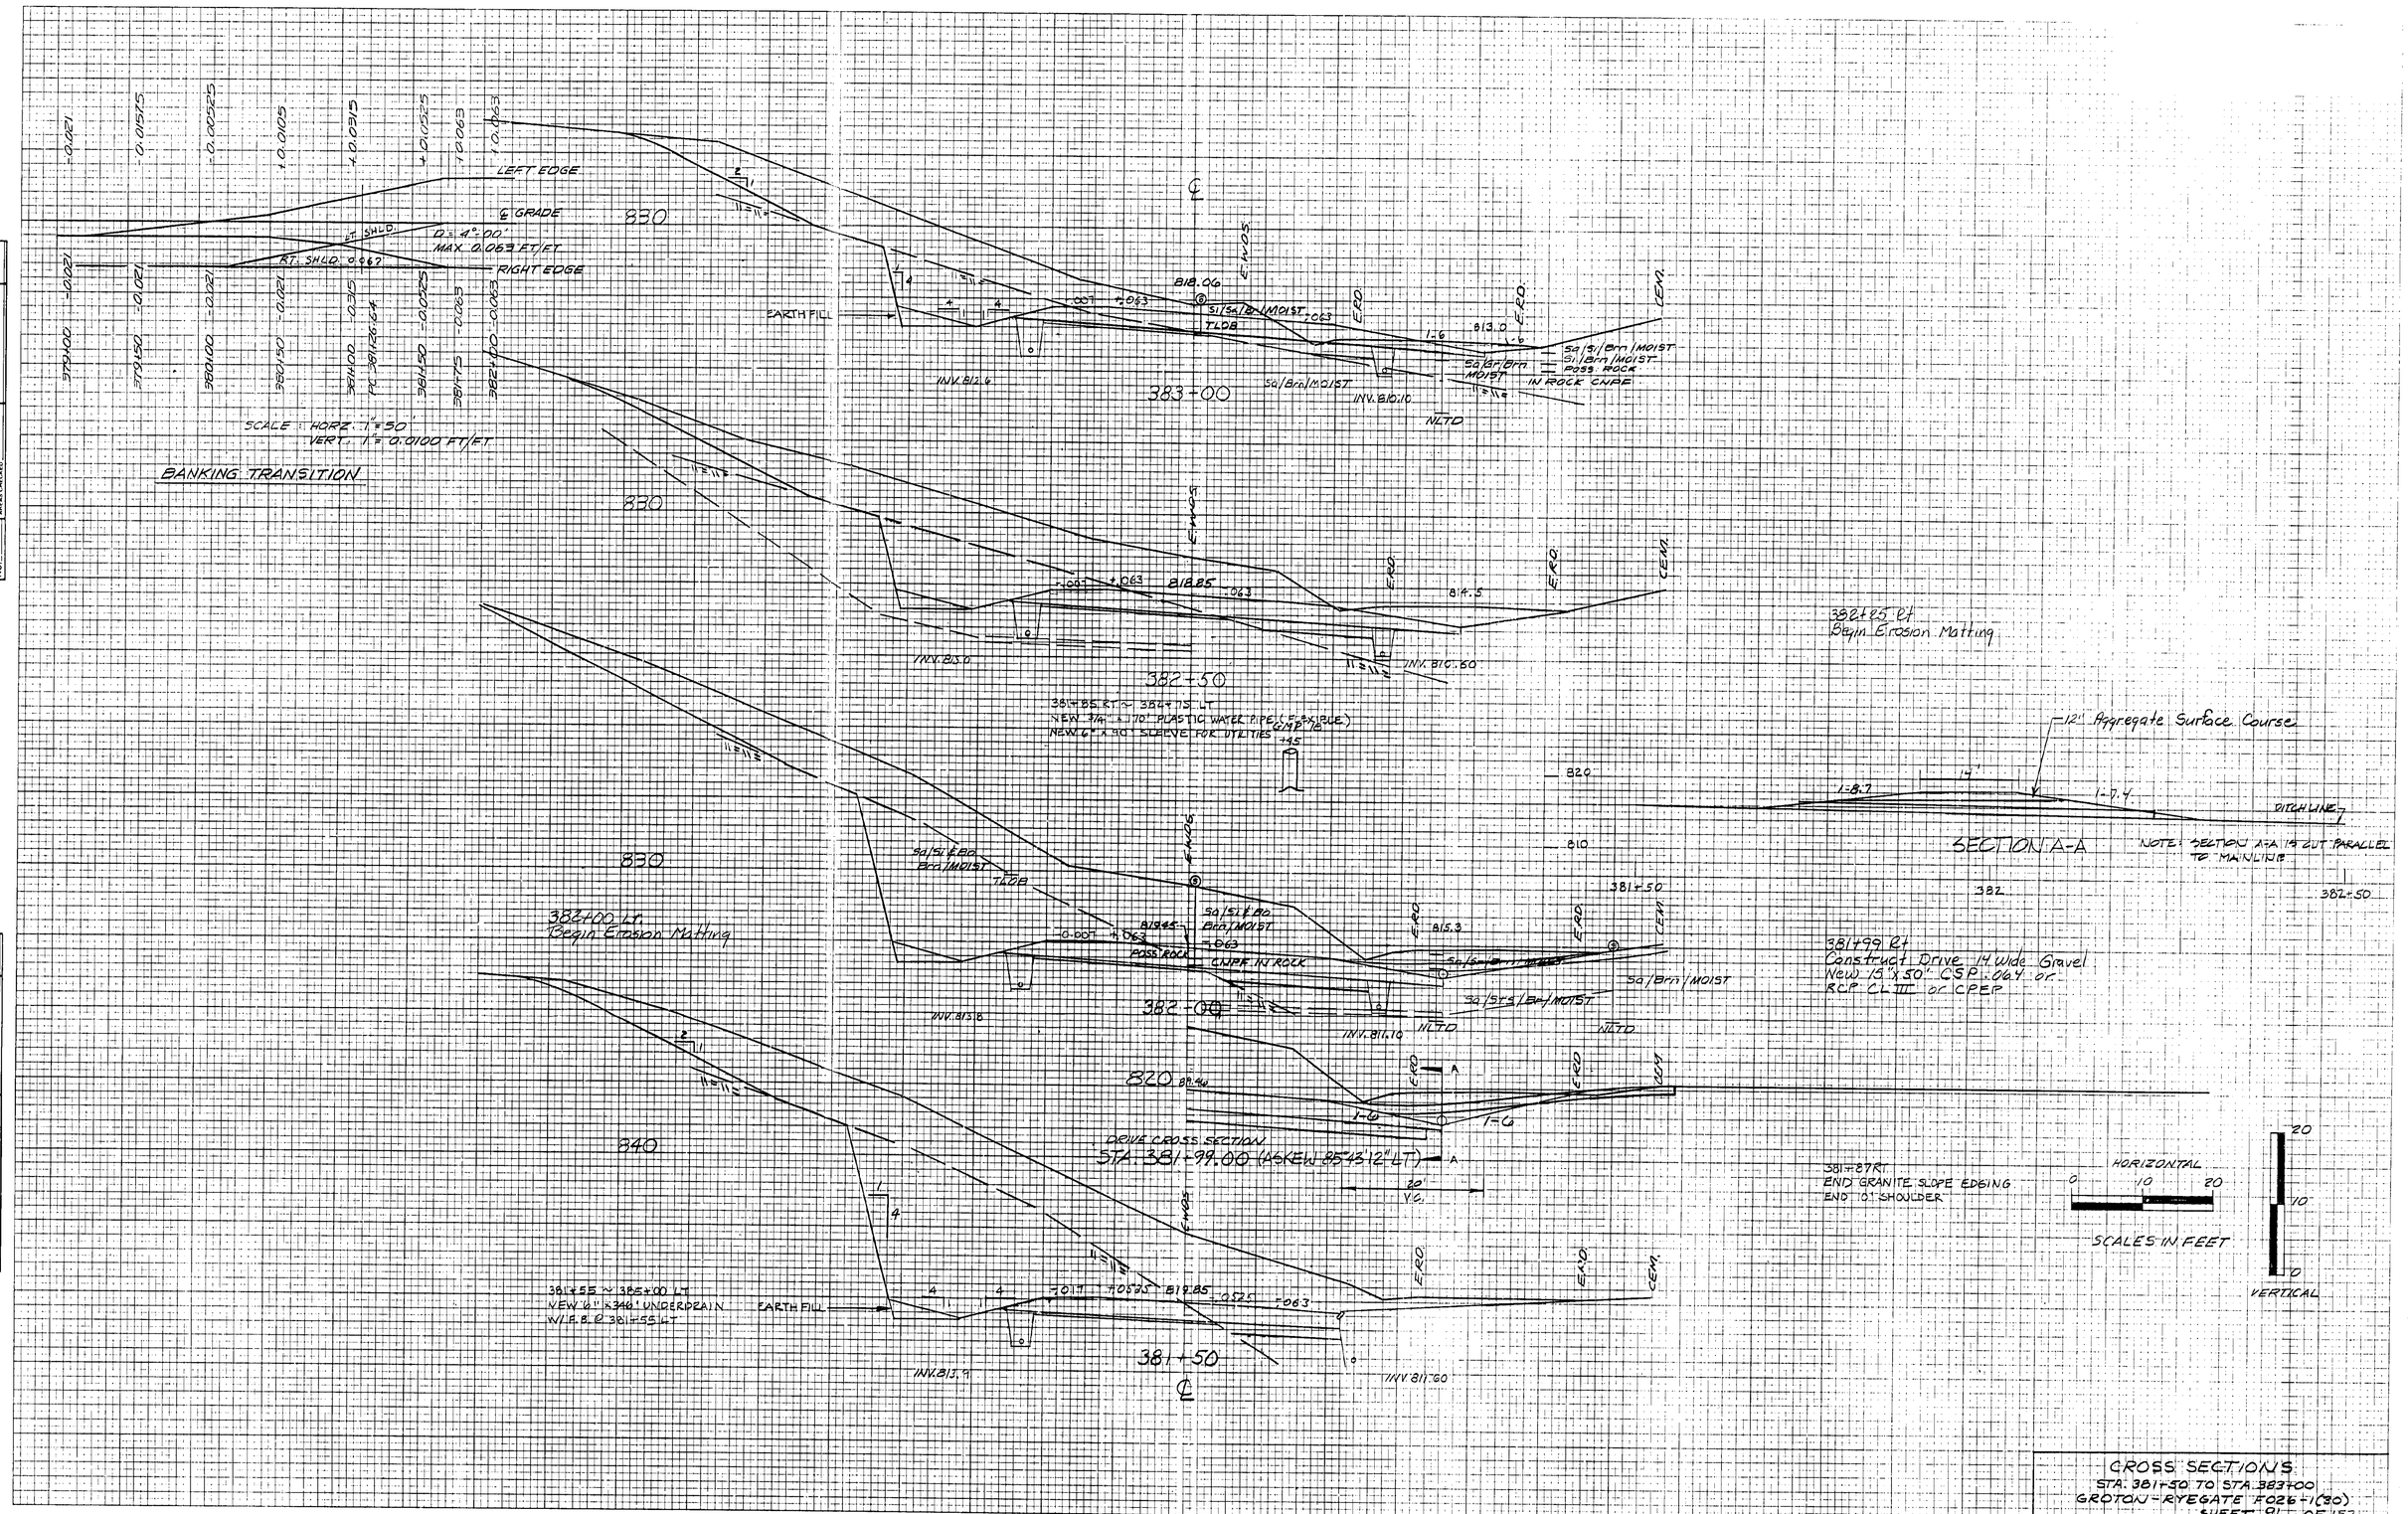

FINAL SURVEY — NOTE BOOK NO. — SURVEYED — PLOTTED — TEMPLATE — AREAS — AREAS CHECKED — BY — DATE

ORIGINAL SURVEY — NOTE BOOK NO. 317, 427 — SURVEYED ECS, RWB, GPF — PLOTTED GPF, RWB — TEMPLATE RWB — AREAS CHECKED SJS — DATE DEC. 96, MAR. 97, JAN. 97, SEPT. 96

PLATE 3 CROSS SECTION O. V. R. & R. E. STANDARD
DIETZGEN CORPORATION