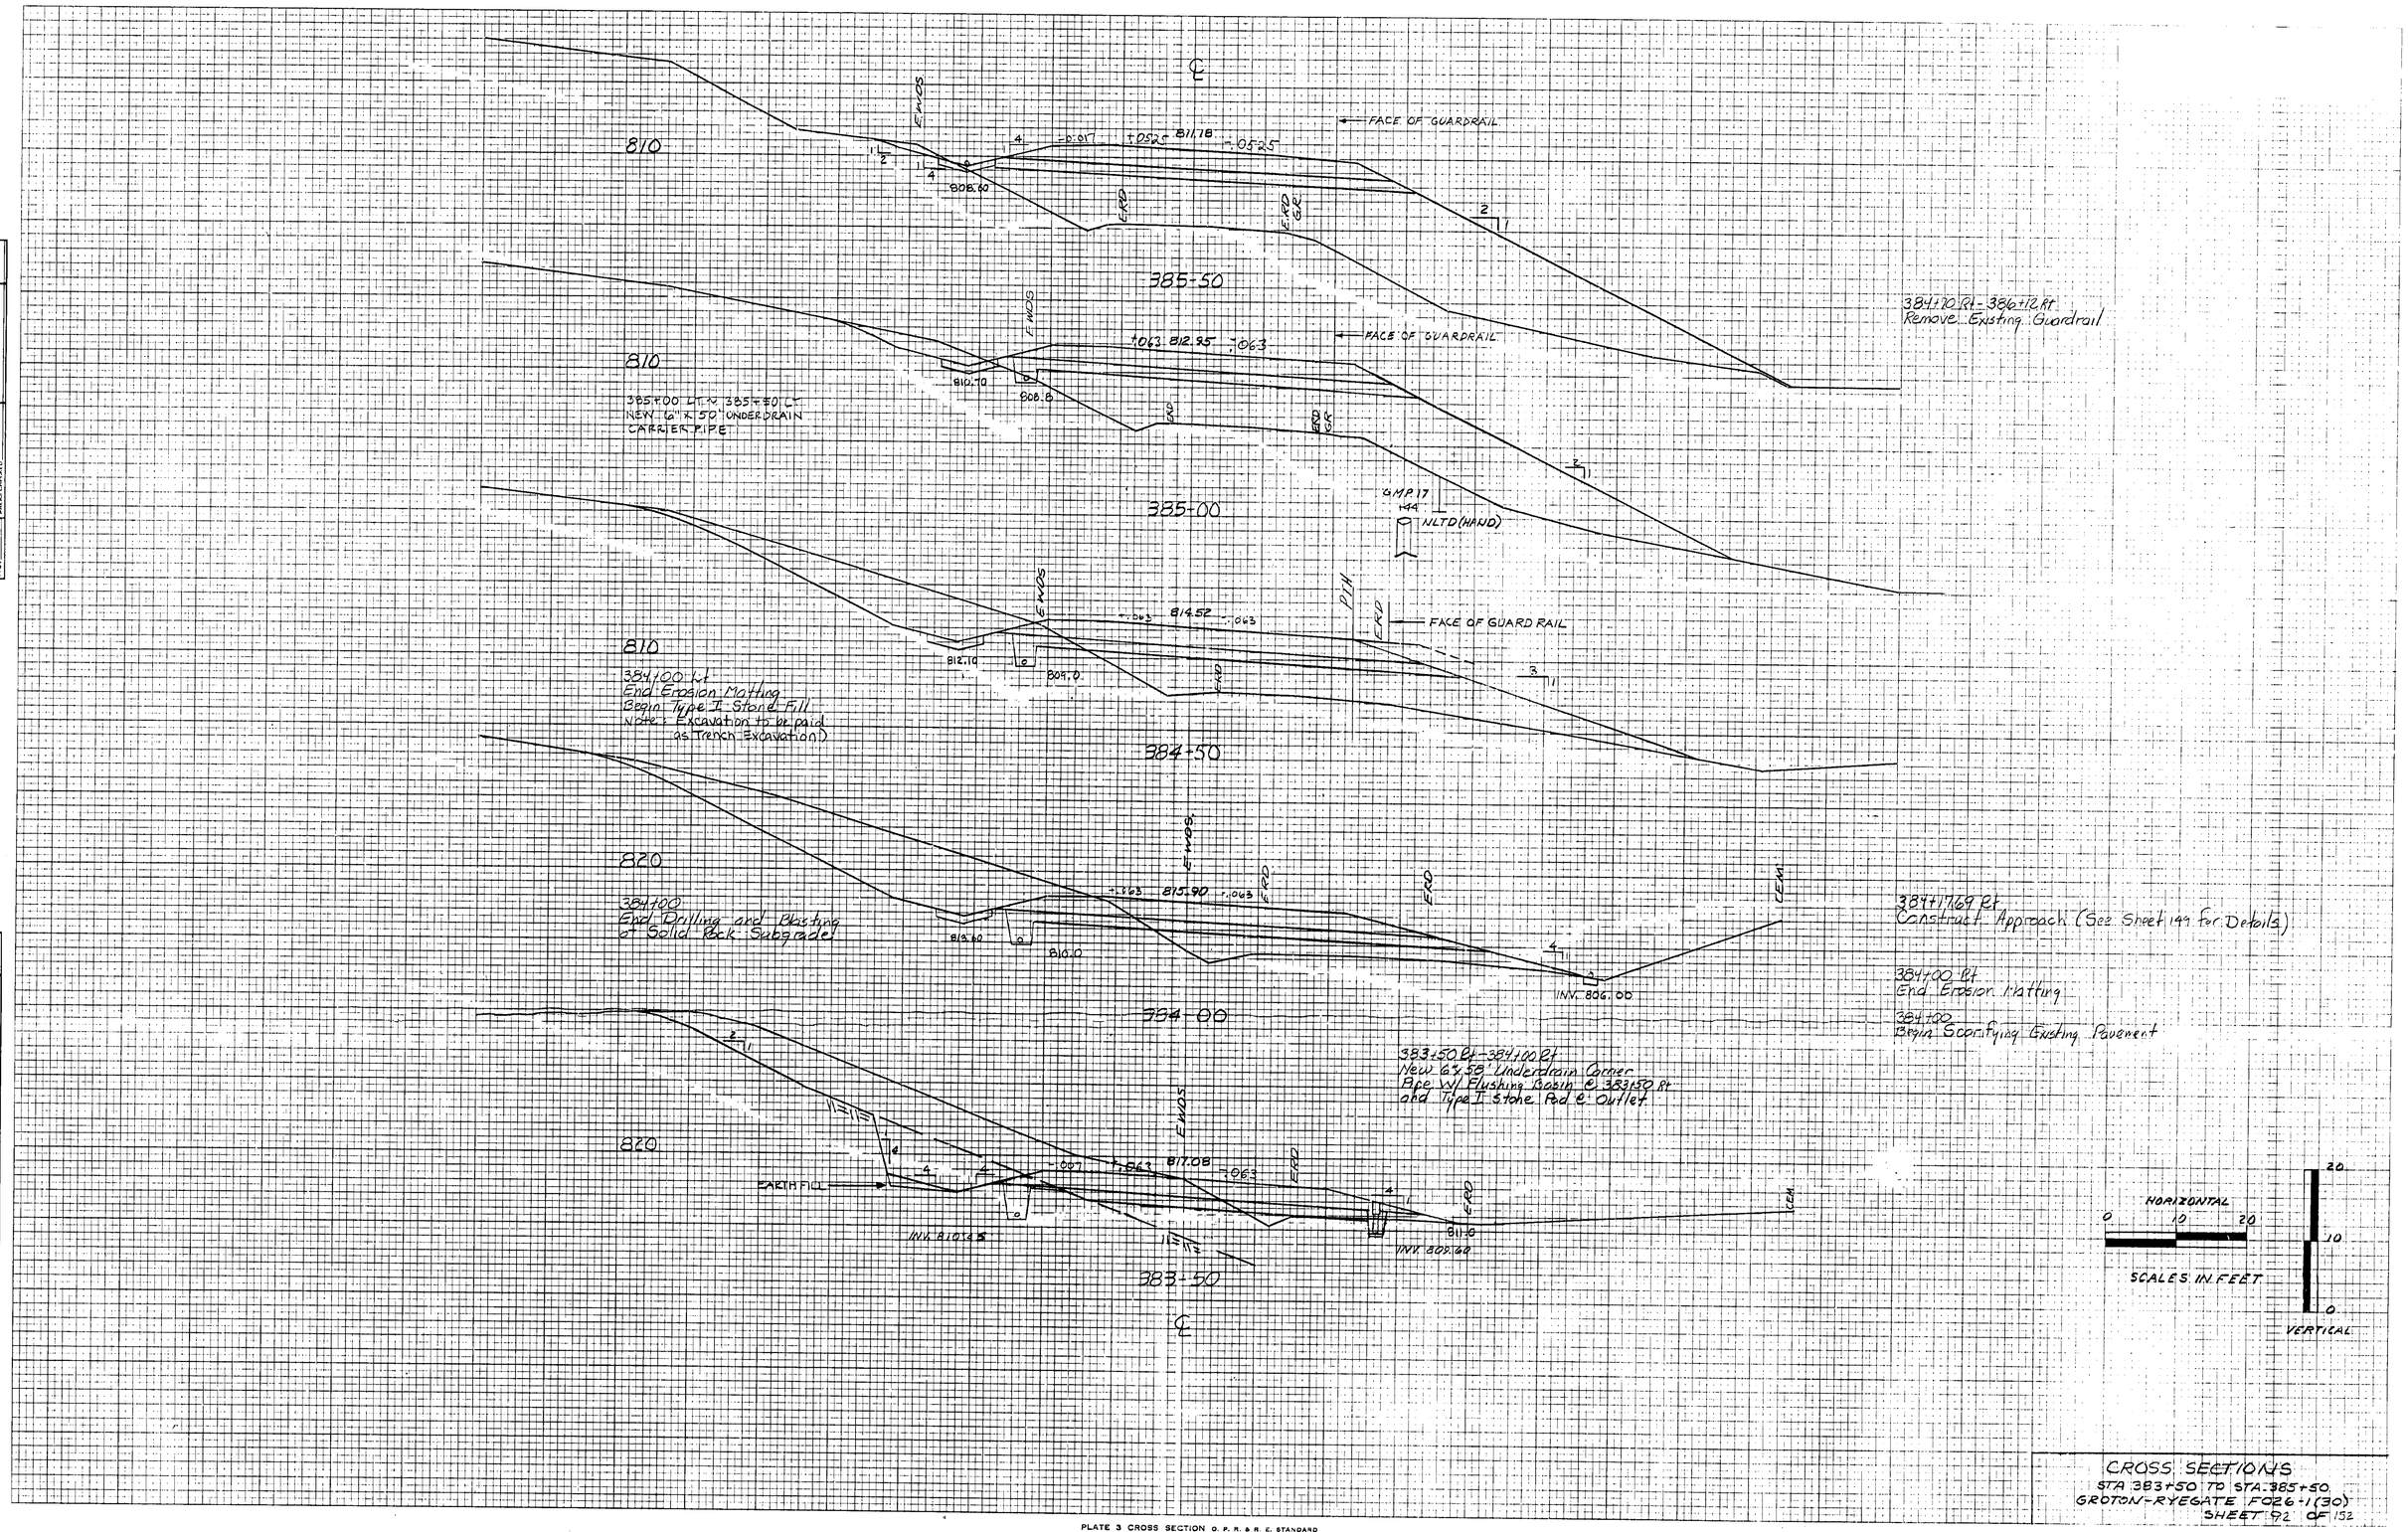

FINAL SURVEY		BY	DATE
NOTE BOOK	SURVEYED	E.C.J., E.K.B., C.P.F.	DEC. '96
	PLOTTED	C.P.F.	MAR. '97
	TEMPLATE	K.L.B.	MAR. '97
	AREAS		SEPT. '97
No.	AREAS CHECKED	R.A.U.	JAN. '98
		S.J.S.	SEPT. '98

ORIGINAL SURVEY		BY	DATE
NOTE BOOK No. 675, 679	SURVEYED	E.C.J., E.K.B., C.P.F.	DEC. '96
	PLOTTED	C.P.F.	MAR. '97
	TEMPLATE	K.L.B.	MAR. '97
	AREAS		SEPT. '97
	AREAS CHECKED	R.A.U.	JAN. '98
		S.J.S.	SEPT. '98

CROSS SECTIONS
STA 383+50 TO STA. 385+50
GROTON-RYEGATE F026-1(30)
SHEET 92 OF 152

PLATE 3 CROSS SECTION O. P. R. & R. E. STANDARD
DIETZGEN CORPORATION