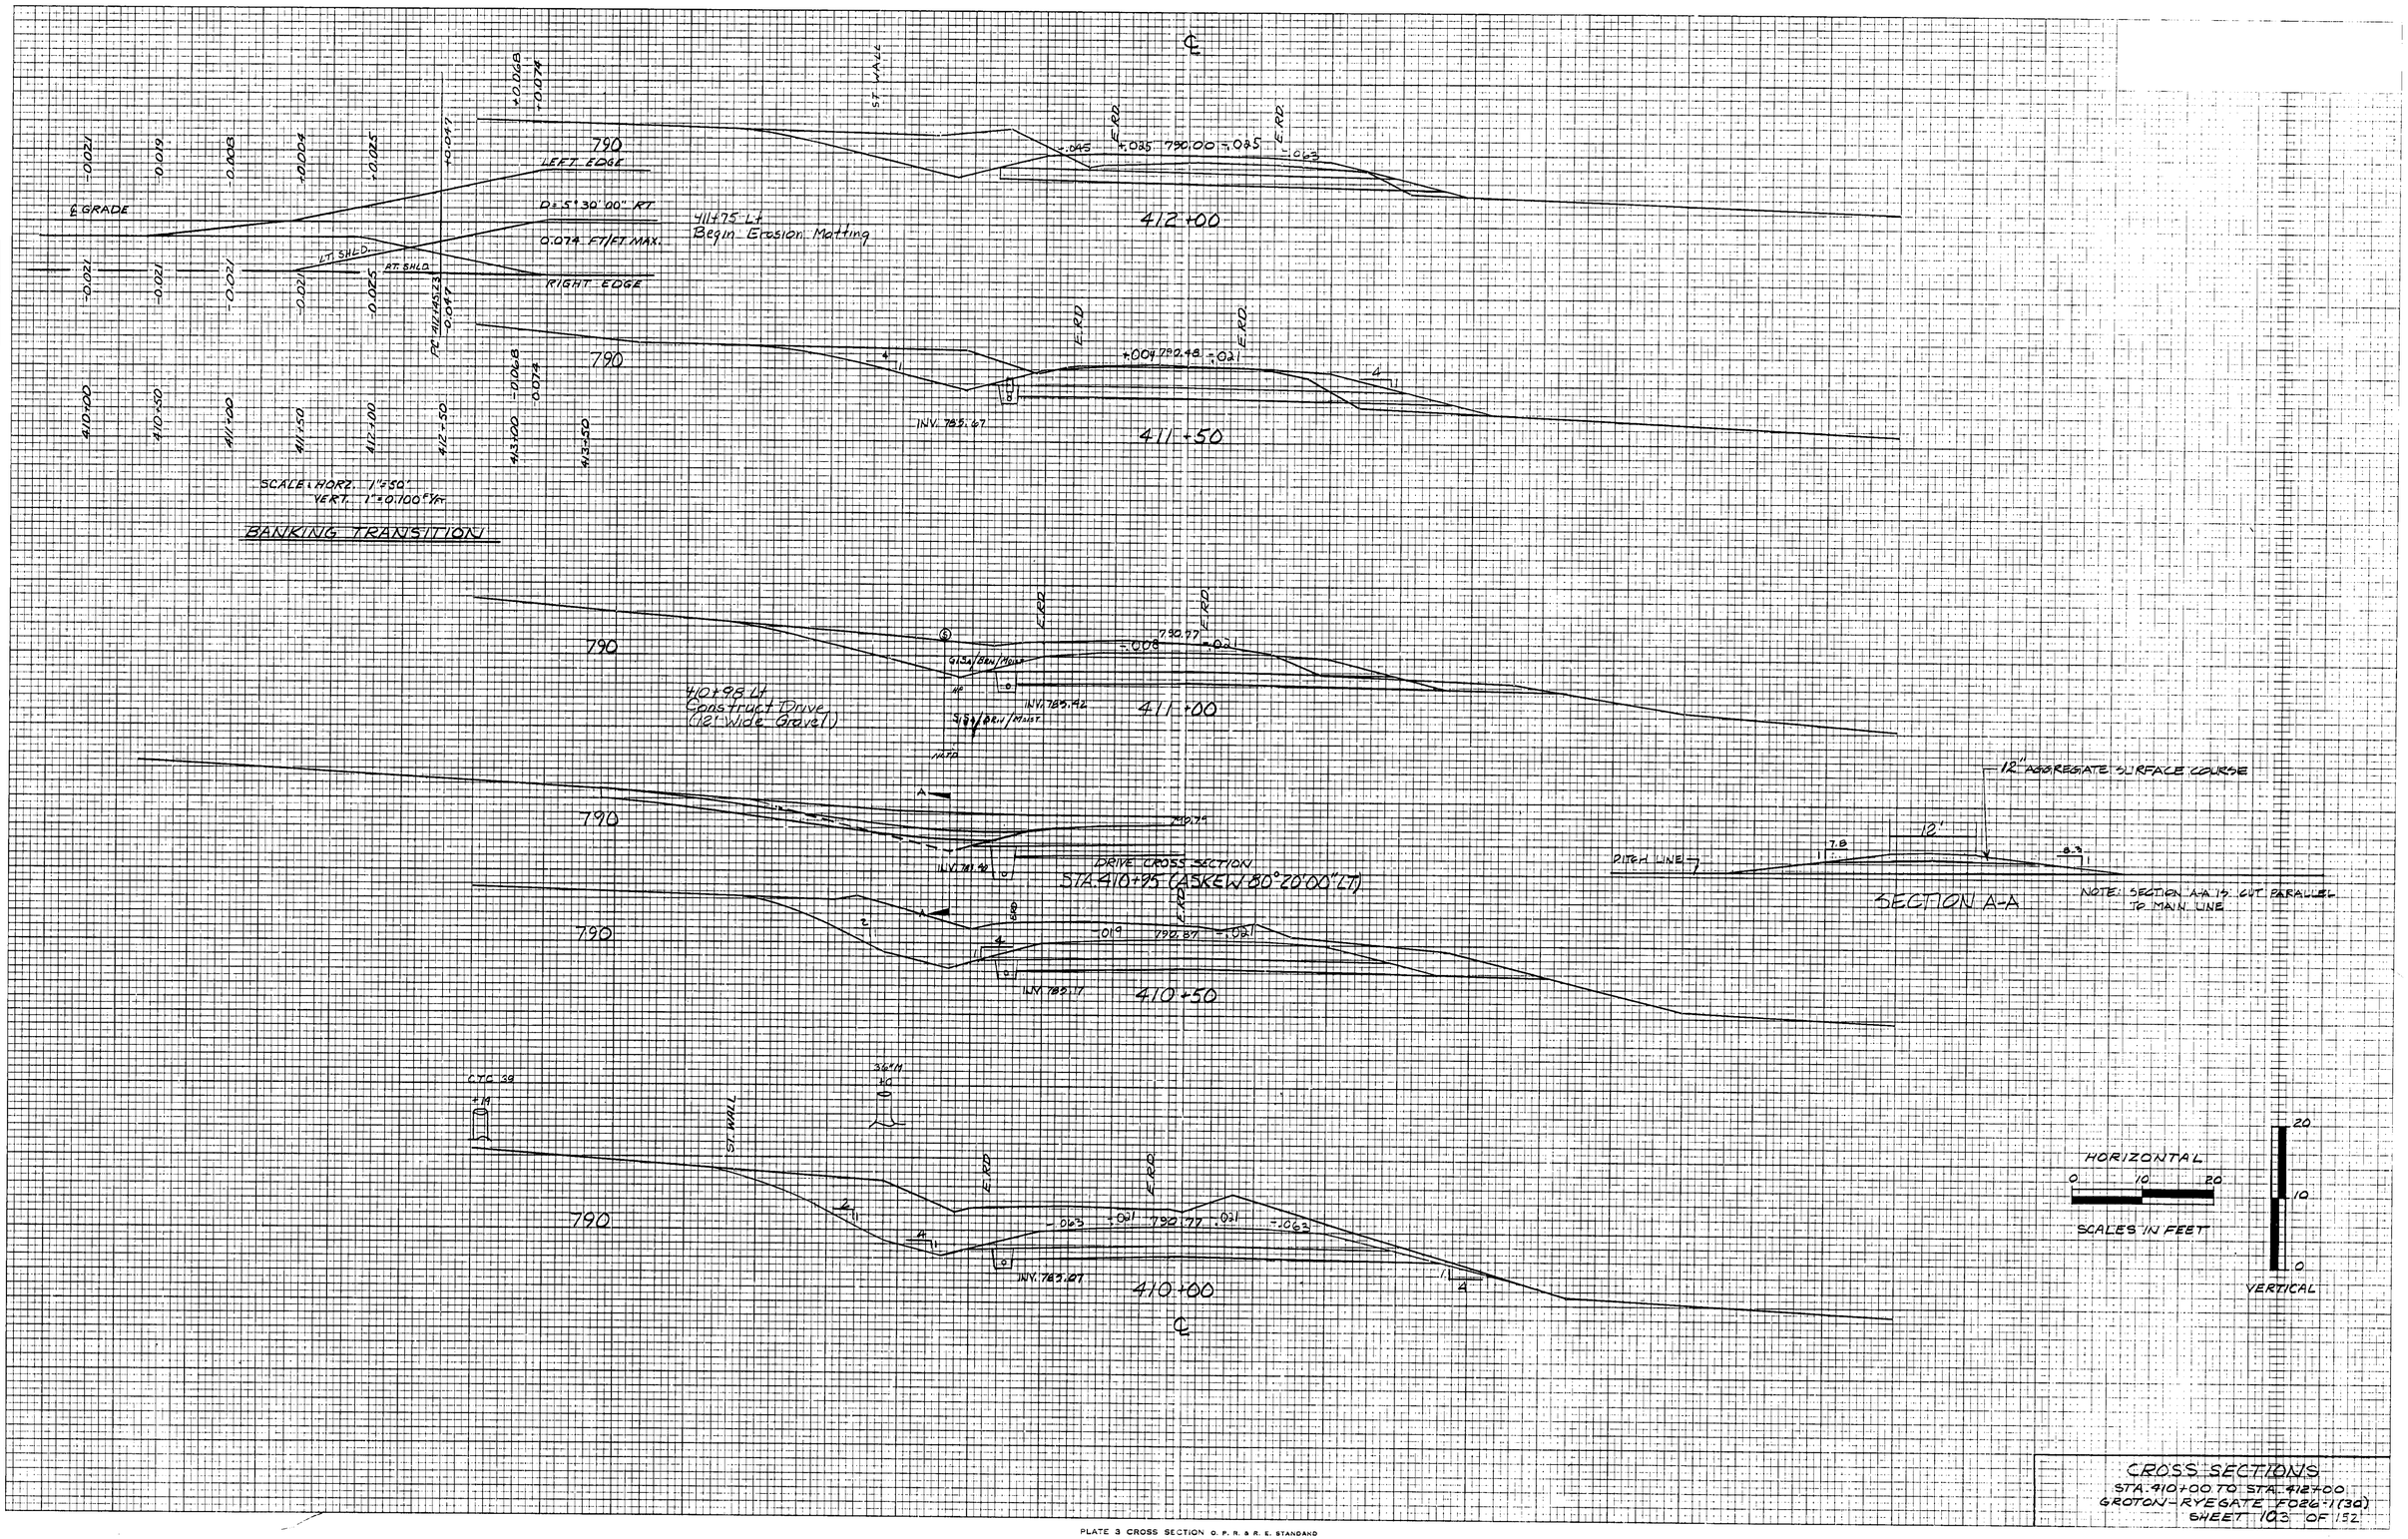

FINAL SURVEY		BY	DATE
NOTE BOOK No.	SURVEYED		
	PLOTTED		
	TEMPLATE		
	AREAS		
	AREAS CHECKED		

ORIGINAL SURVEY		BY	DATE
NOTE BOOK No. 617, 637	SURVEYED	ELS, EWB, LBF	DEC. 84
	PLOTTED	GPF, RJB	AUG. 87
	TEMPLATE	GPF	APR. 87
	AREAS	RWJ	JUN. 86
	AREAS CHECKED	SJS	SEPT. 86

PLATE 3 CROSS SECTION O. P. R. & R. E. STANDARD
DIETZGEN CORPORATION