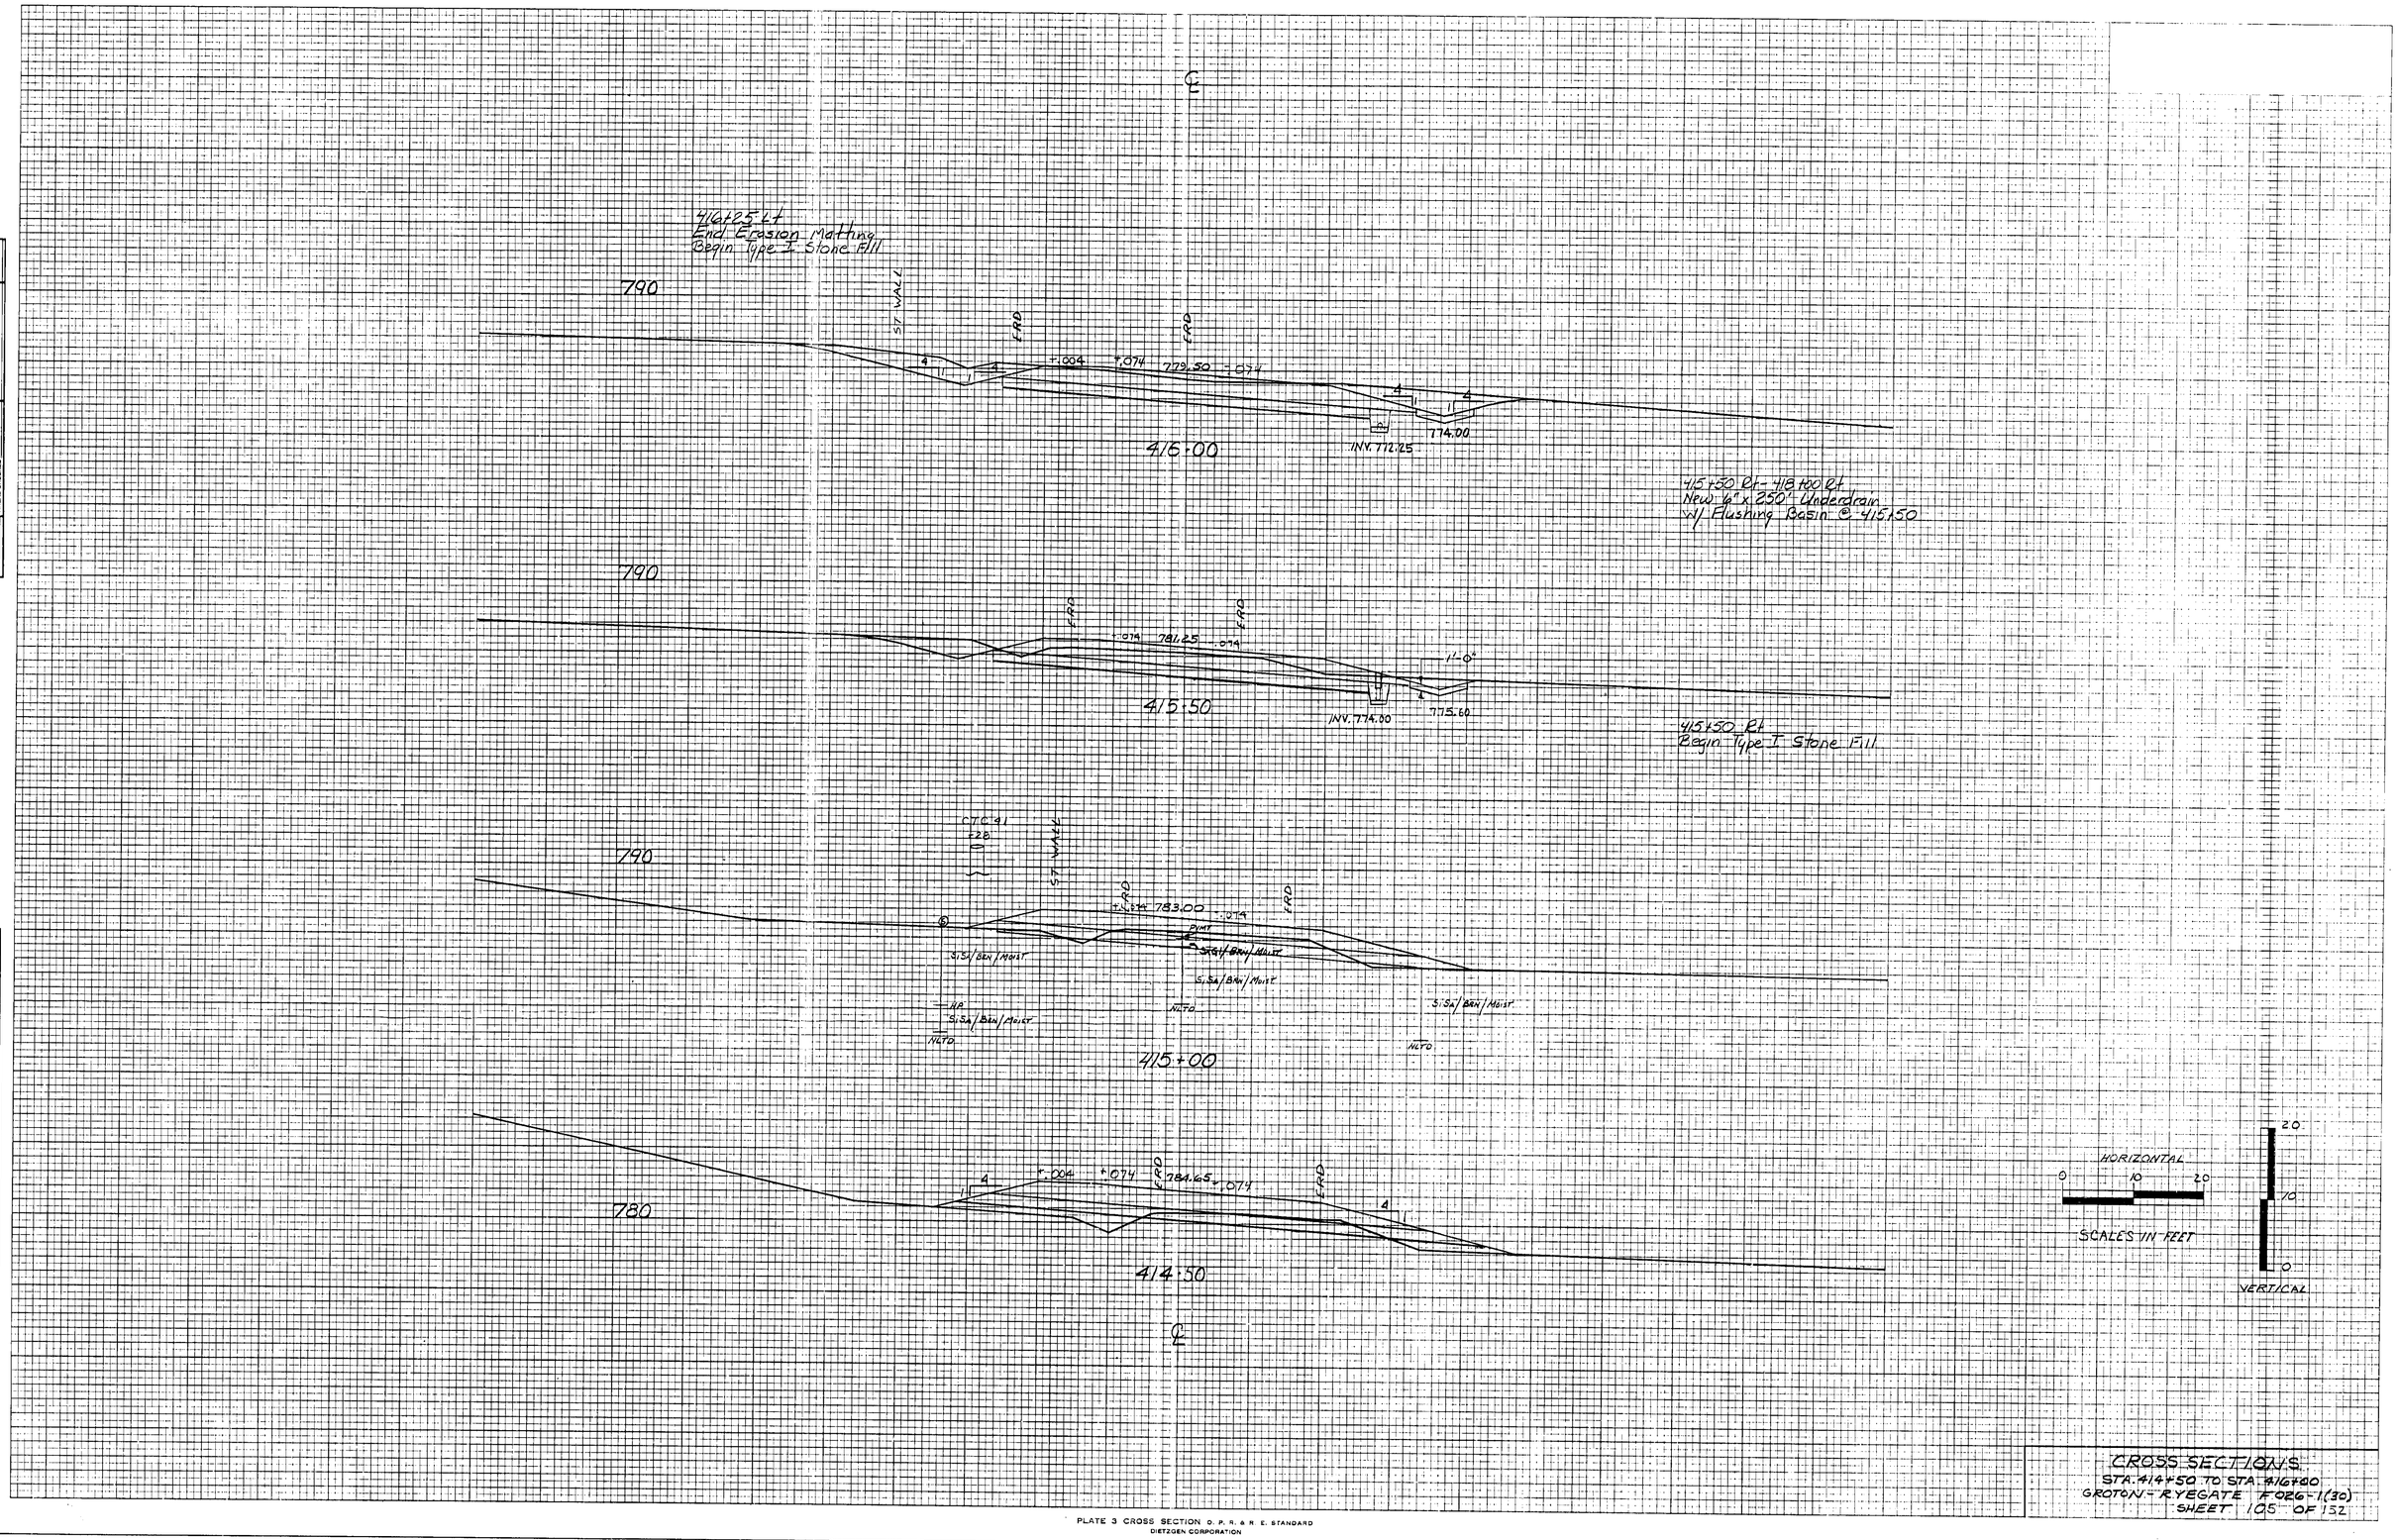

CROSS SECTIONS
STA. 414+50 TO STA. 416+00
GROTON - RYEGATE F026-1(30)
SHEET 105 OF 132

FINAL SURVEY		BY	DATE
NOTE BOOK	SURVEYED		
No.	PLOTTED		
	TEMPLATE		
	AREAS		
	AREAS CHECKED		

ORIGINAL SURVEY		BY	DATE
NOTE BOOK	SURVEYED	ECS, RGB, GPF	DEC. 86
528, 610, 616	PLOTTED	GPF, RJB	MAR. 87
NO. 417, 639	TEMPLATE	GPF	APR. 87
	AREAS	RAW	JAN. 90
	AREAS CHECKED	SJS	SEPT. 90

PLATE 3 CROSS SECTION O. P. R. & R. E. STANDARD
DIETZGEN CORPORATION