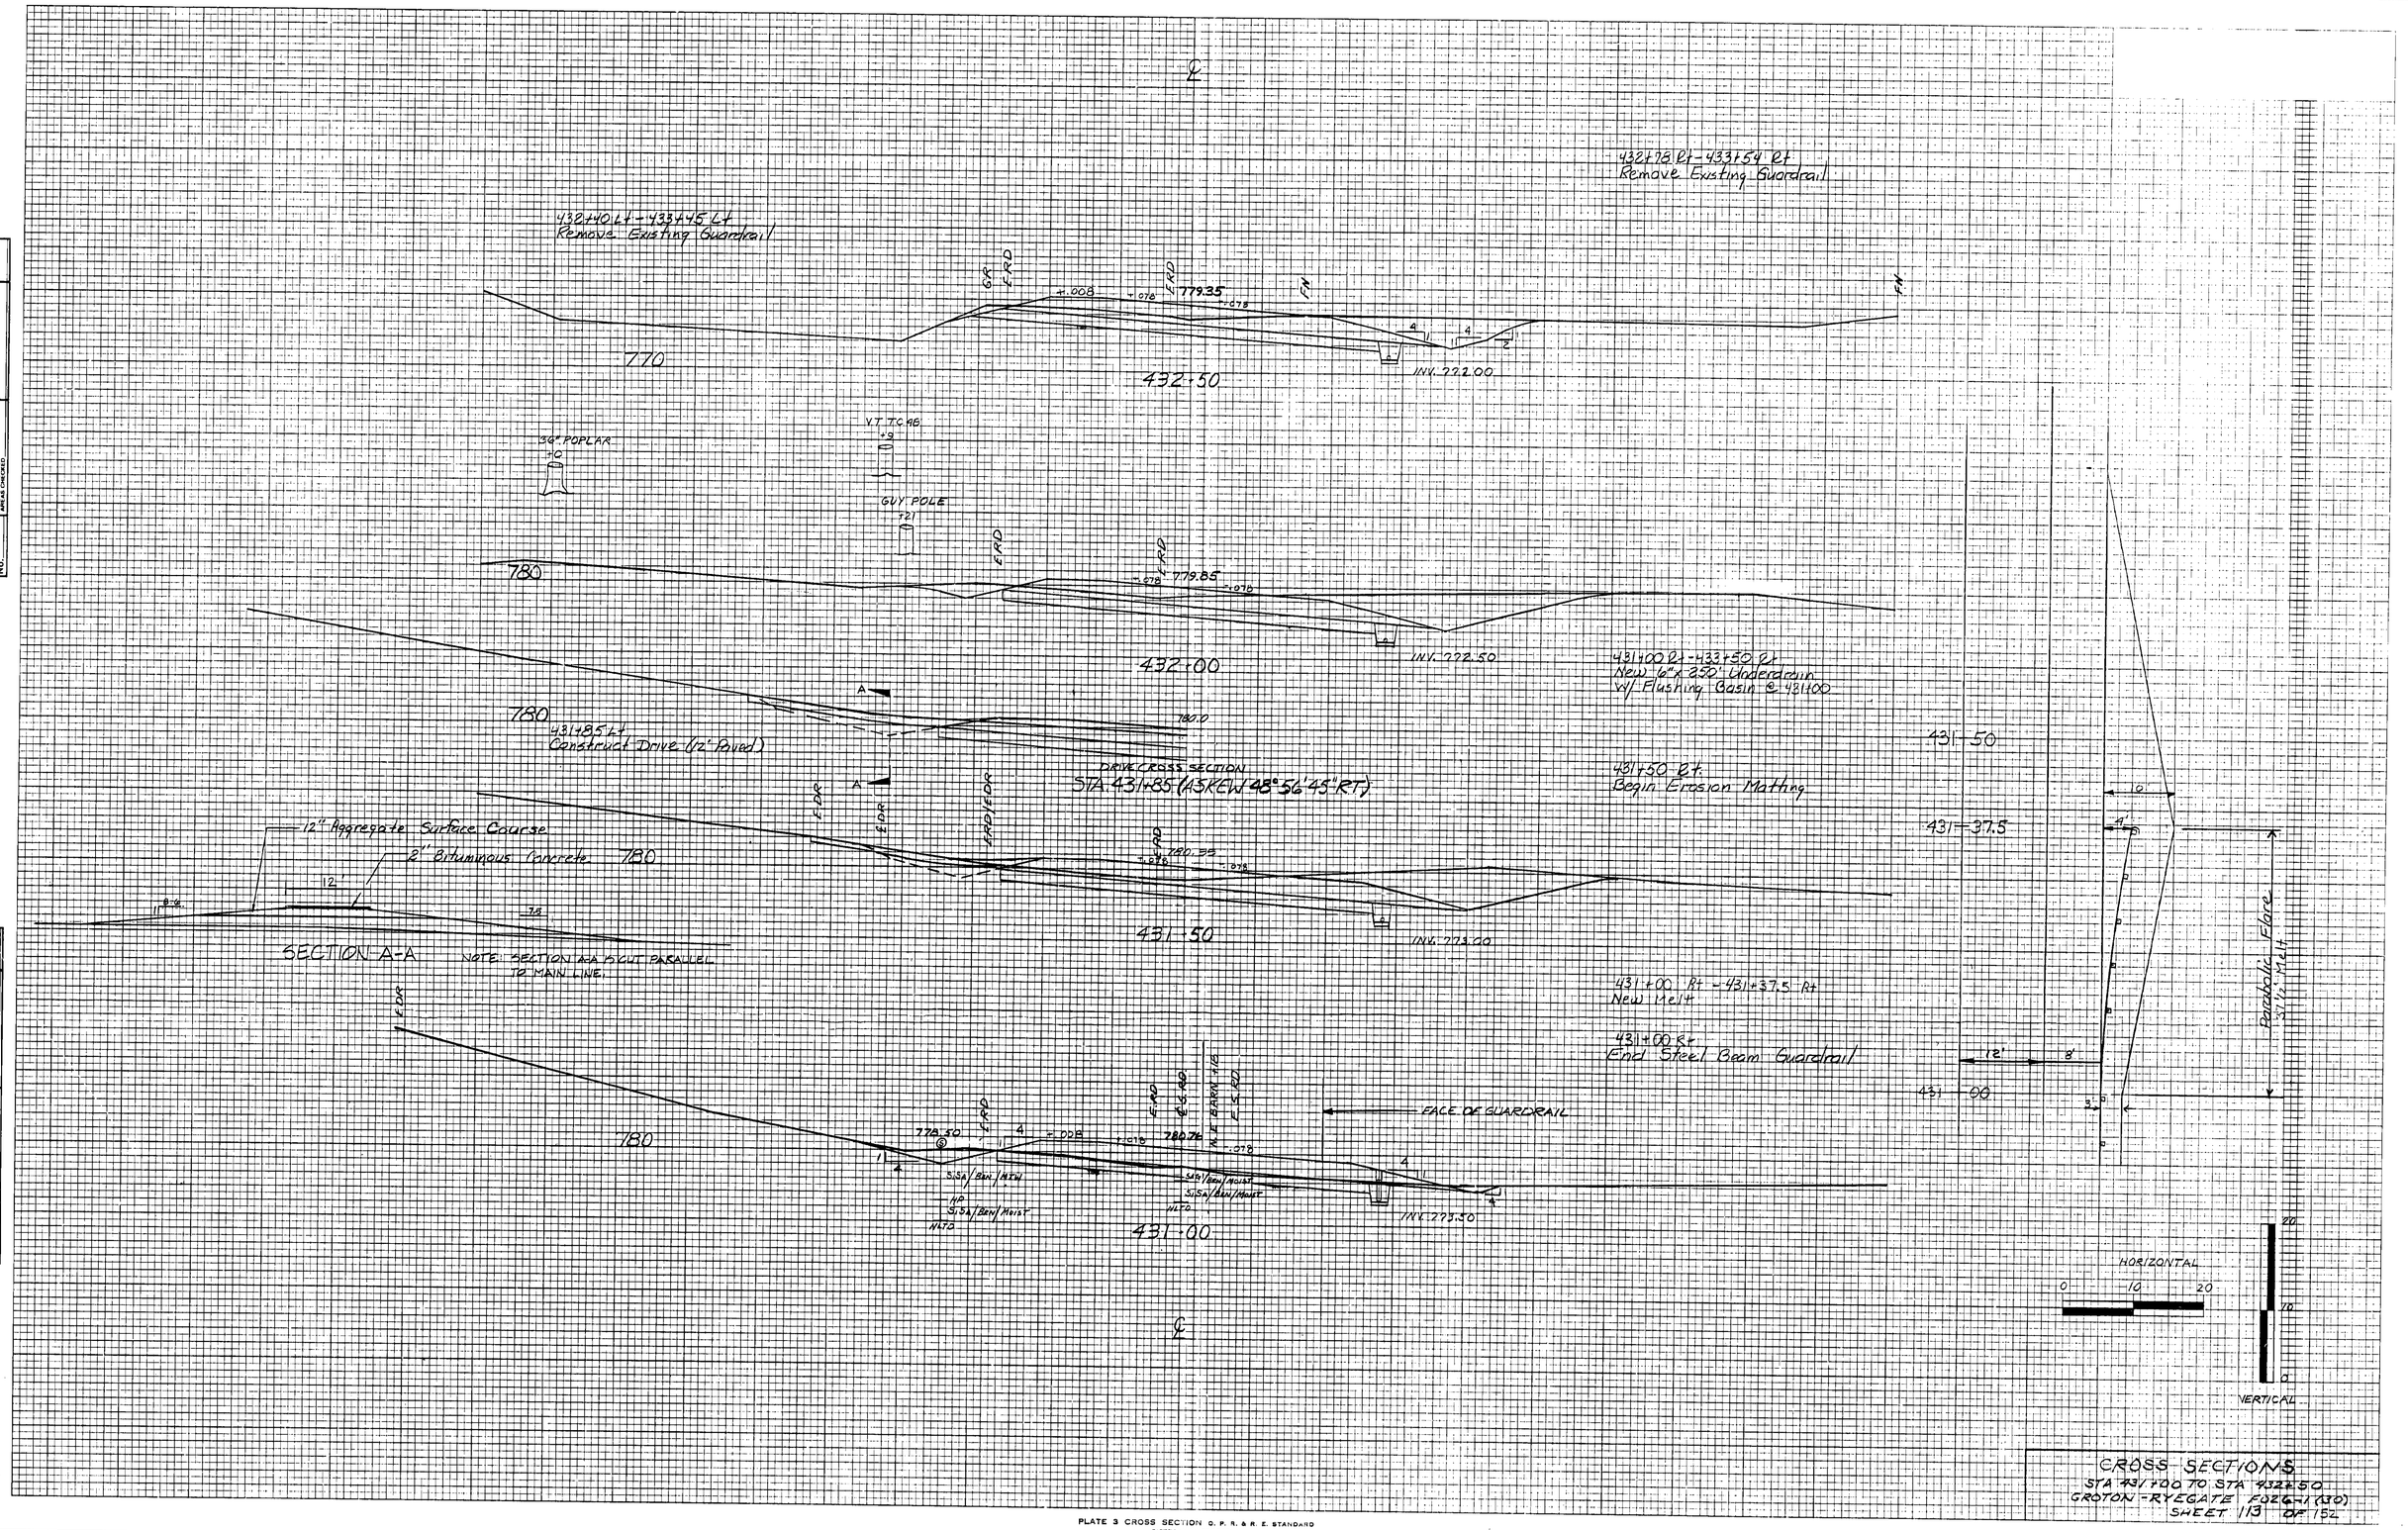

CROSS SECTIONS
STA 431+00 TO STA 432+50
GROTON - RYEGATE F029-1 (30)
SHEET 113 OF 152

FINAL SURVEY				
NOTE BOOK NO.	SURVEYED		BY	DATE
	PLOTTED			
	TEMPLATE			
	AREAS			
	AREAS CHECKED			

ORIGINAL SURVEY		BY	DATE
NOTE BOOK NO. 670,637	SURVEYED	ECS, RCB, GPF	DEC. 86
	PLOTTED	GPF, FNJB	MAR. 87
	TEMPLATE	GPF	AUG. 87
	AREAS	KMJ	MAR. 90
	AREAS CHECKED	SJS	SEPT. 90

PLATE 3 CROSS SECTION O. P. R. & R. E. STANDARD
DIETZGEN CORPORATION