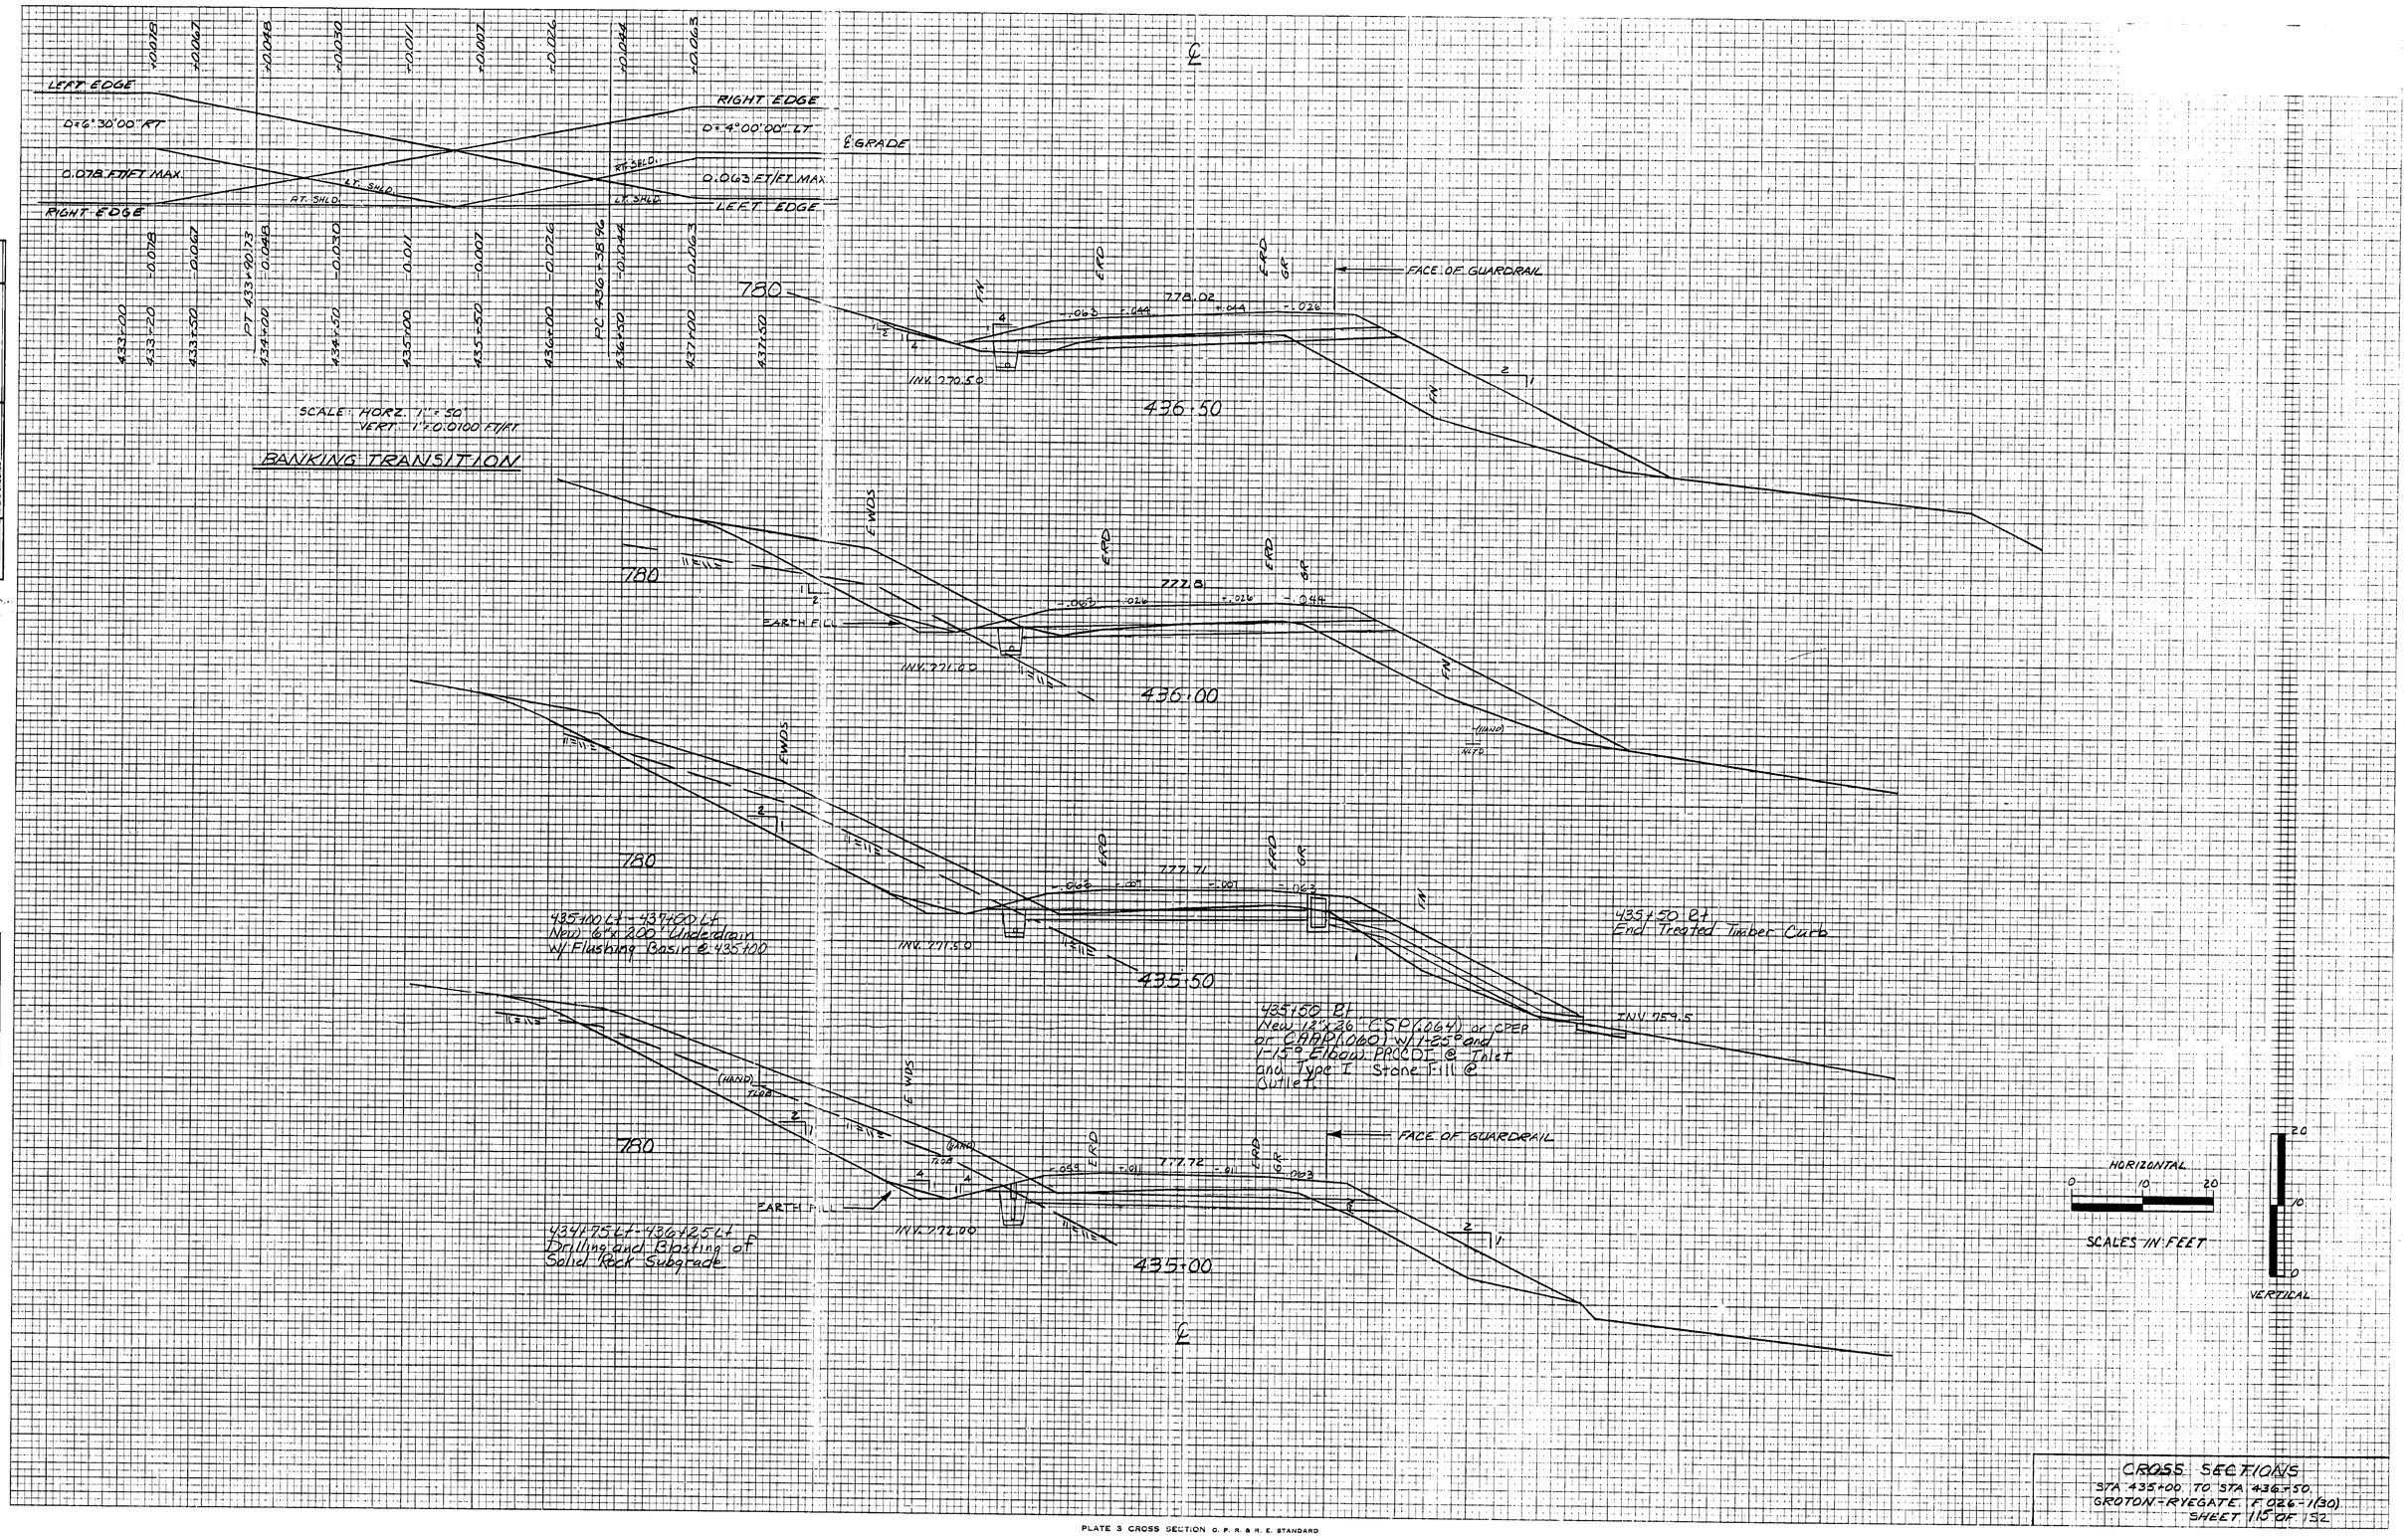

FINAL SURVEY		BY	DATE
NOTE BOOK No.	SURVEYED		
	PLOTTED		
	TEMPLATE		
	AREAS		
	AREAS CHECKED		

ORIGINAL SURVEY		BY	DATE
NOTE BOOK No. 1	SURVEYED	ES, RJB & PF	FEB. 87
	PLOTTED	GPE, RJB	APR. 87
	TEMPLATE	GPE	APR. 87
	AREAS	RJW	JUL. 90
	AREAS CHECKED	SJS	SEPT. 90

CROSS SECTIONS
STA 435+00 TO STA 436+50
GROTON-RYEGATE F 026-1(30)
SHEET 115 OF 152