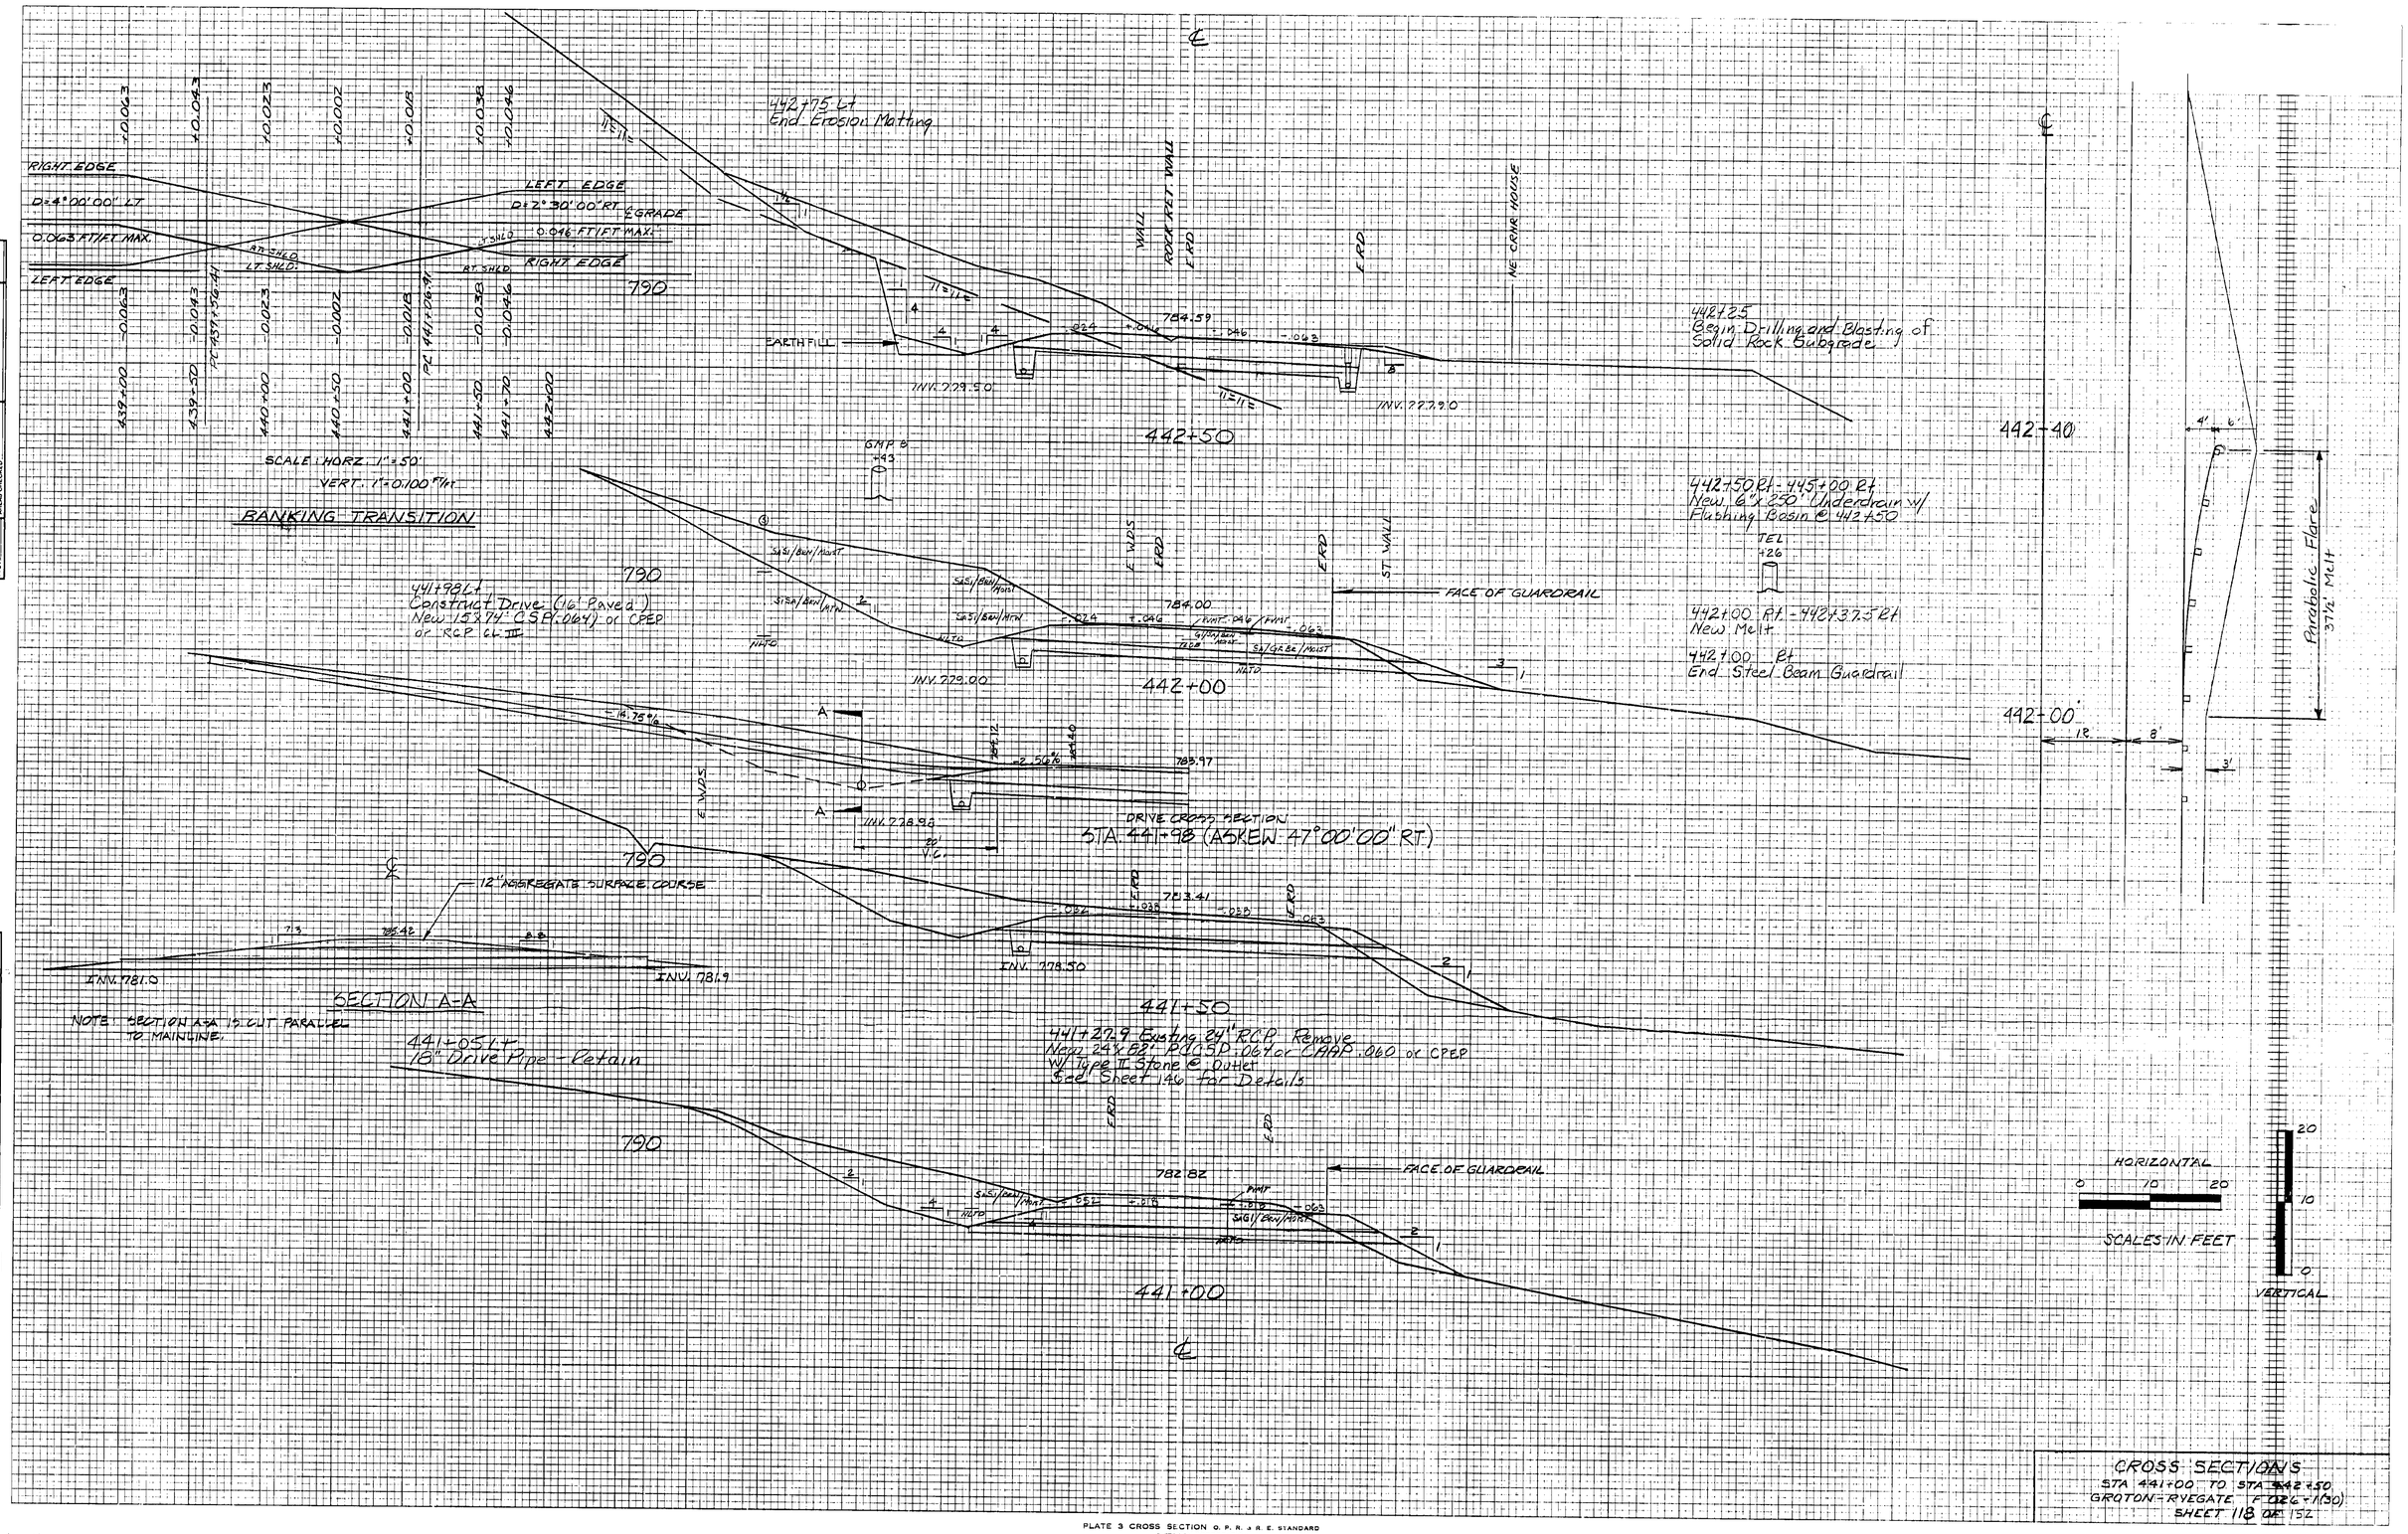

FINAL SURVEY	SURVEYED		BY	DATE
	PLOTTED			
NOTE BOOK	TEMPLATE			
No.	AREAS			
	AREAS CHECKED			

ORIGINAL SURVEY			DATE
	SURVEYED		DEC. 87
	PLOTTED	R.E.B. GFF	DEC. 87
	TEMPLATE	G.P.E. K.W.B.	MAR. 87
NOTE BOOK	AREAS	G.P.E.	APR. 87
No. 540-545	AREAS CHECKED	K.W.B.	MAY 90
		S.S.S.	SEPT. 90

PLATE 3 CROSS SECTION O. P. R. & R. E. STANDARD
DIETZGEN CORPORATION