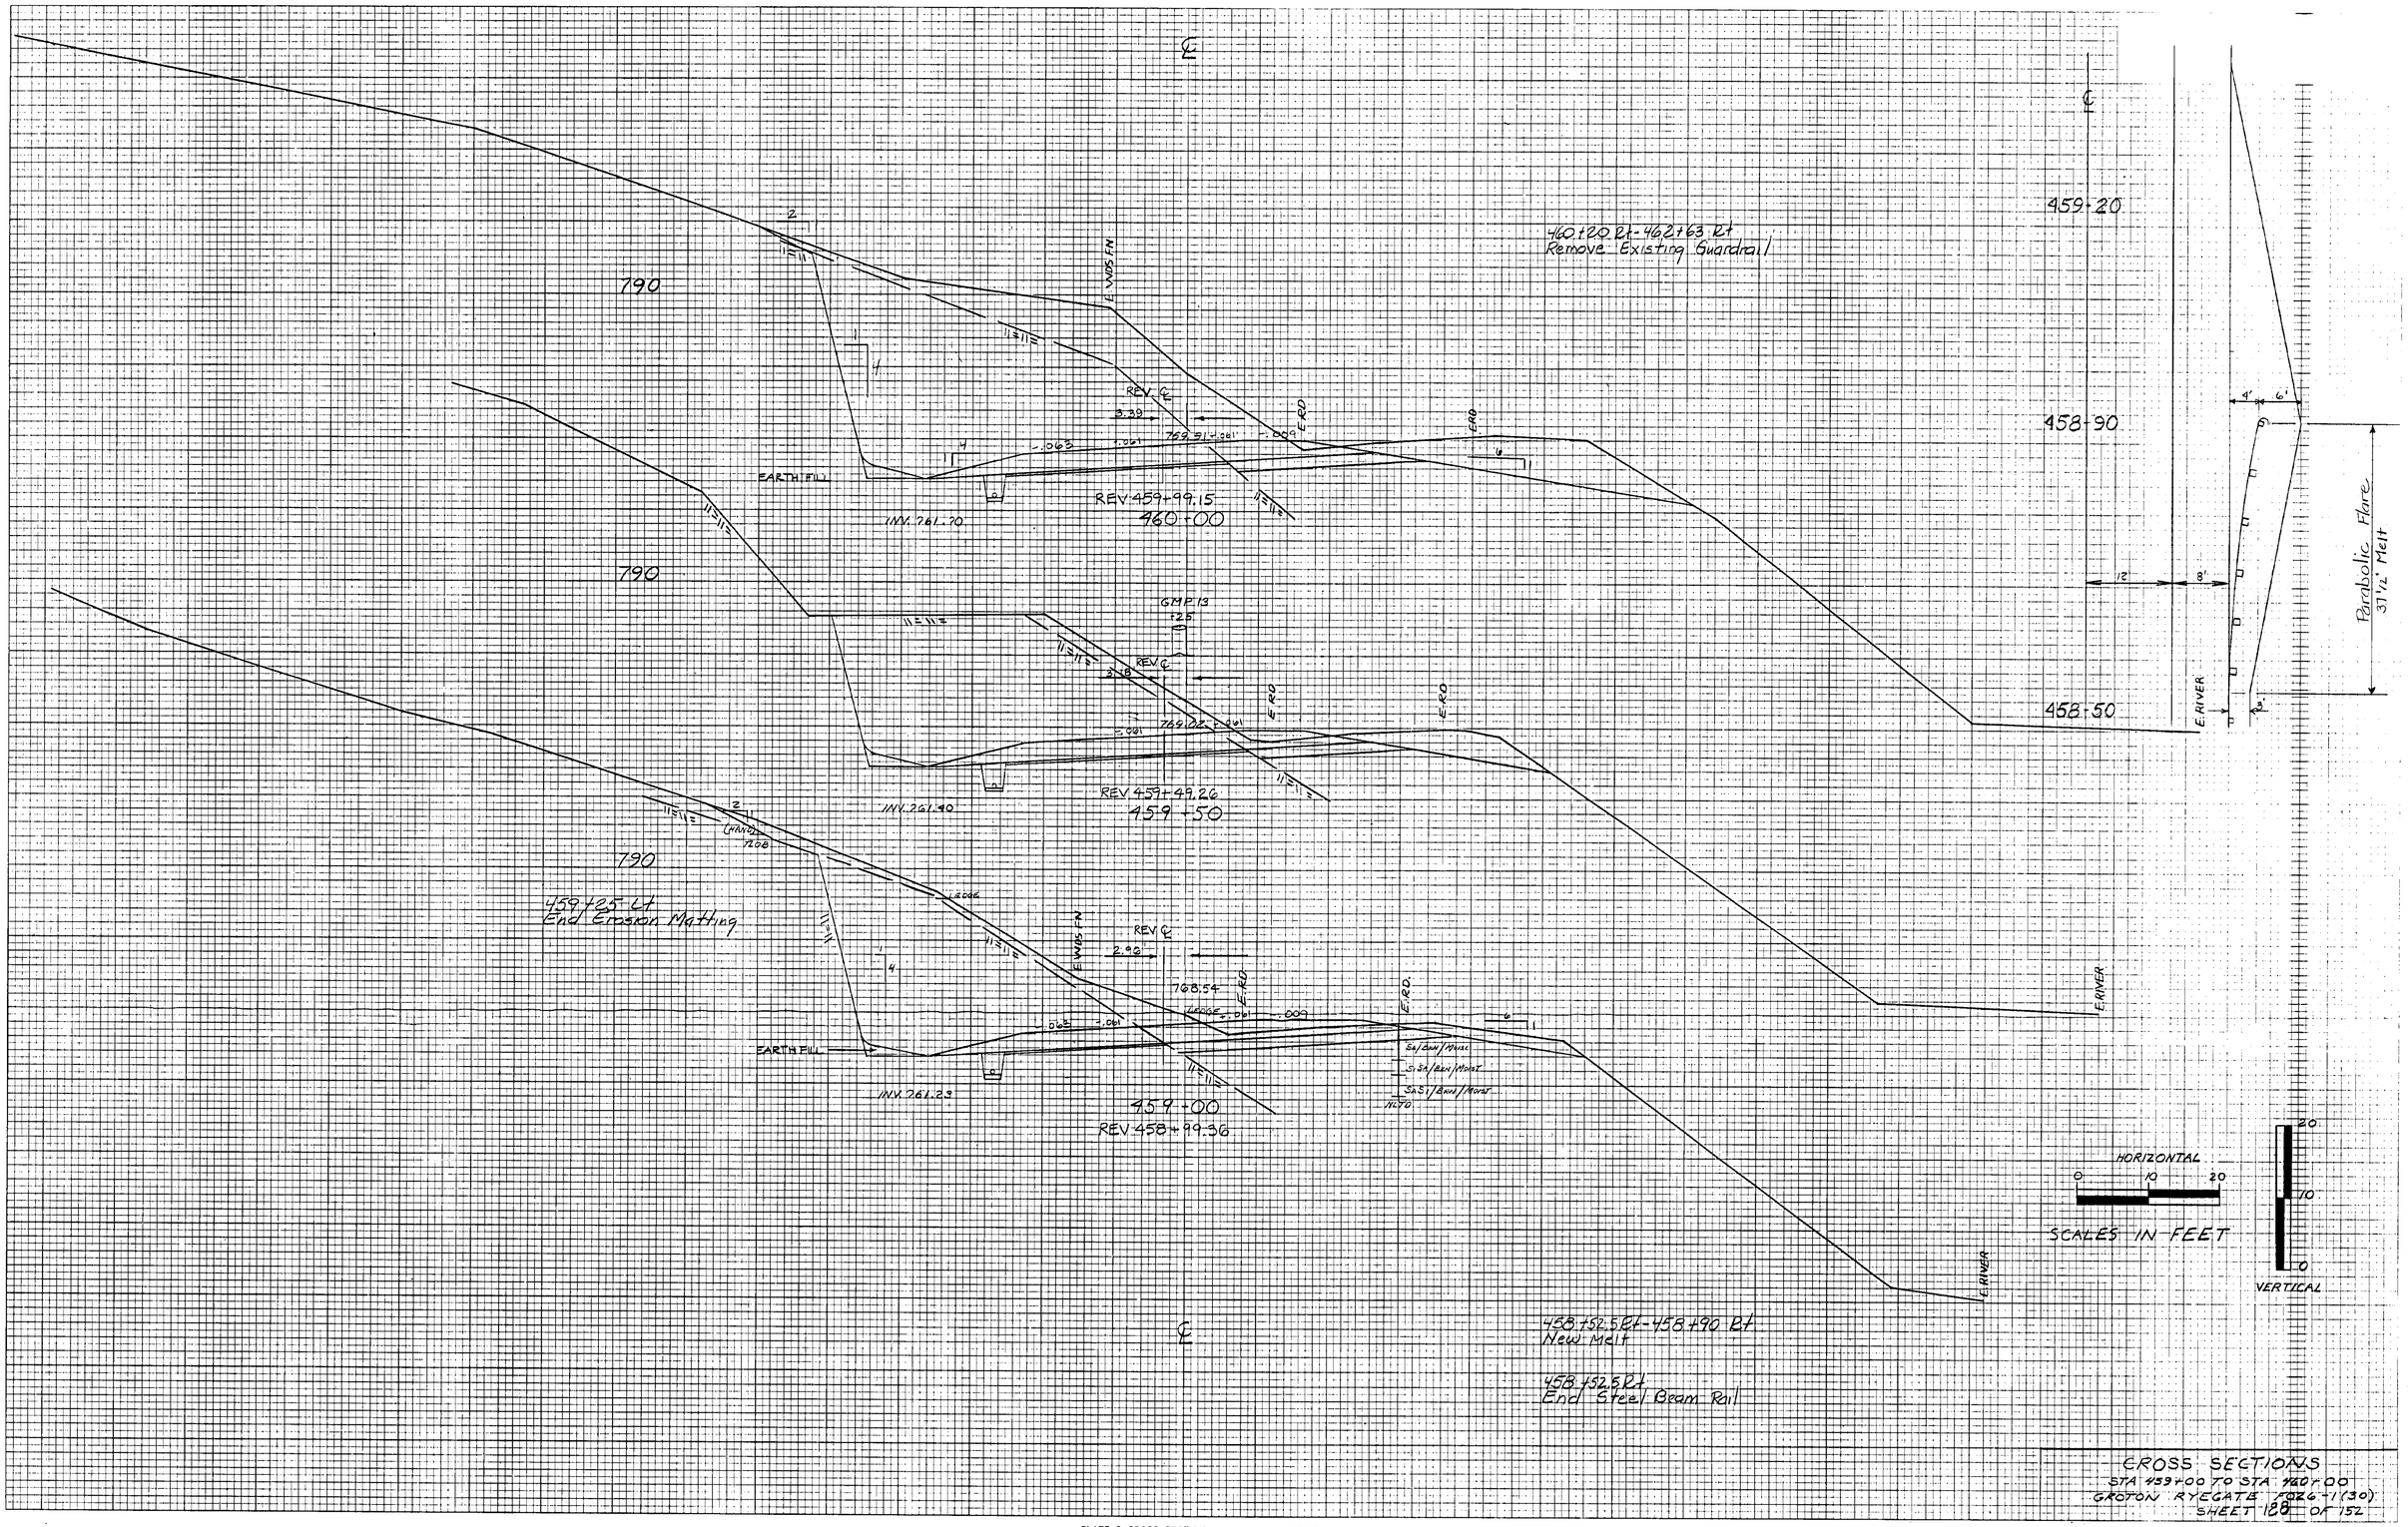

FINAL SURVEY		BY	DATE
NOTE BOOK No.	SURVEYED		
	PLOTTED		
	TEMPLATE		
	AREAS		
	AREAS CHECKED		

ORIGINAL SURVEY		BY	DATE
NOTE BOOK 286, 40-44 No. 675, 689	SURVEYED	ES, RG, GFF	DEC. 86
	PLOTTED	GFF, RWB	MAR. 87
	TEMPLATE	GFF	APR. 87
	AREAS	RAM	JAN. 90
	AREAS CHECKED	SJS	SEPT. 90

PLATE 3 CROSS SECTION O. P. R. & R. E. STANDARD
DIETZGEN CORPORATION