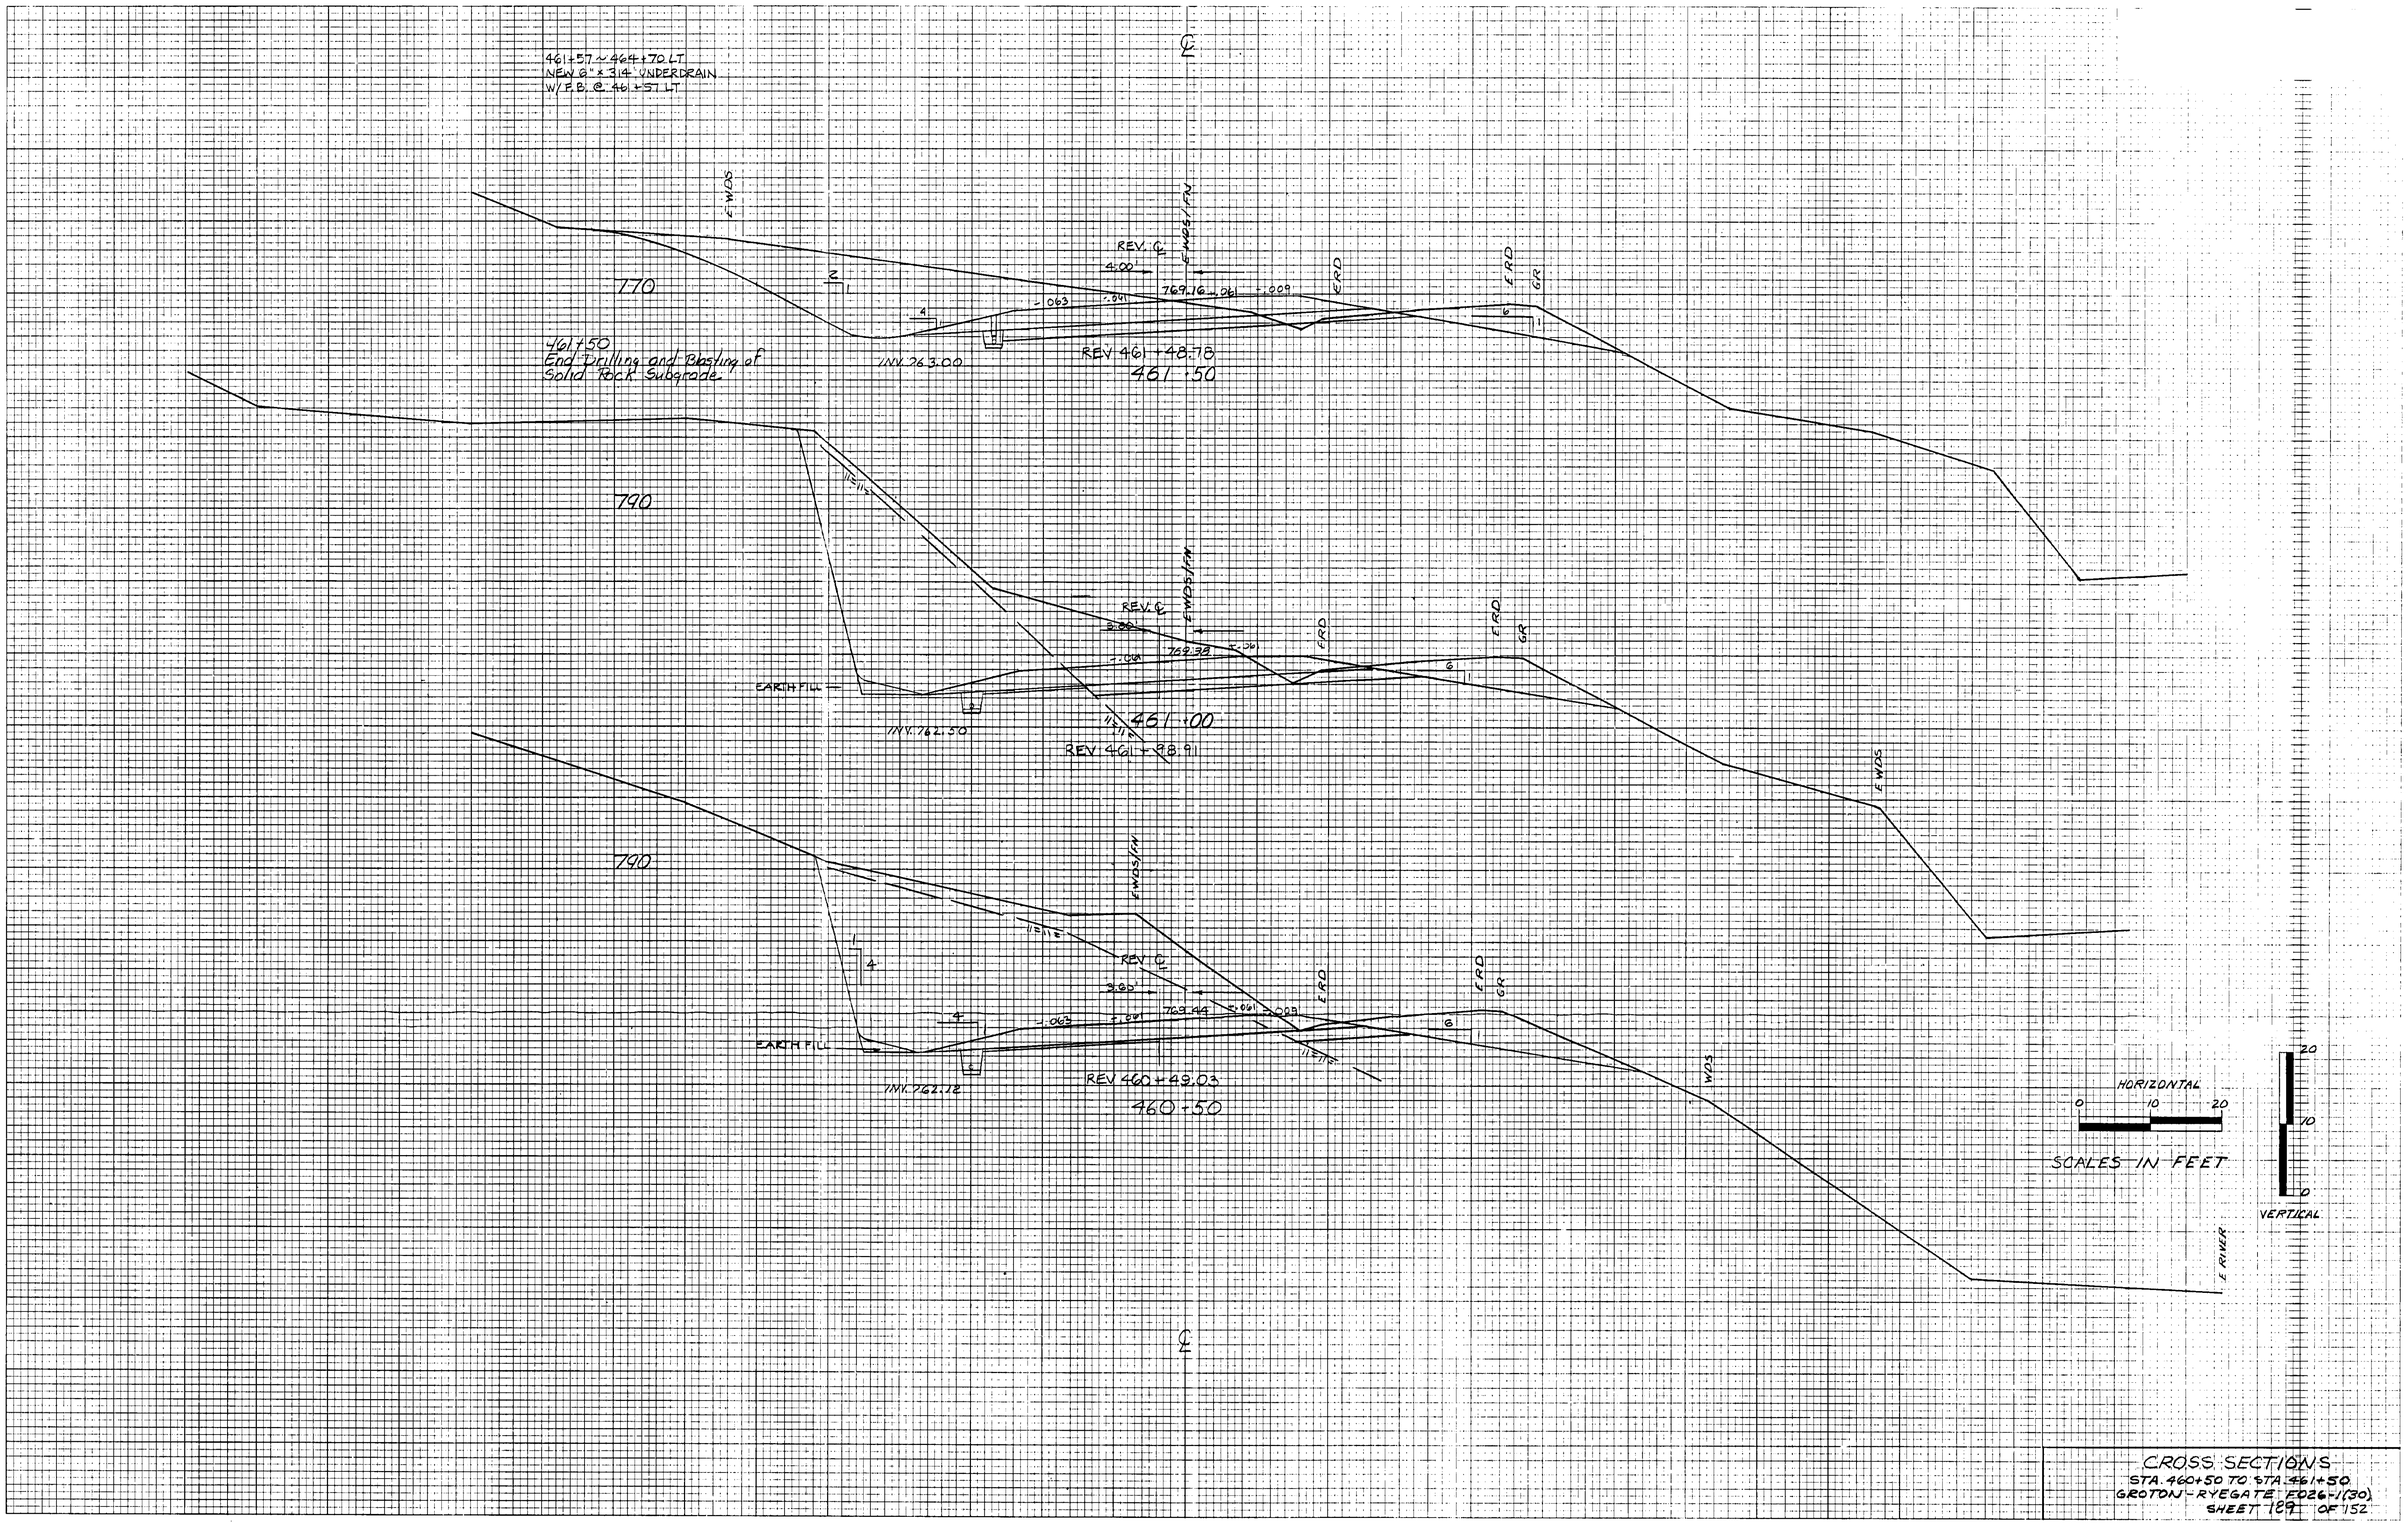

FINAL SURVEY			BY	DATE
NOTE BOOK No.	SURVEYED			
	PLOTTED			
	TEMPLATE			
	AREAS			
	AREAS CHECKED			

ORIGINAL SURVEY		BY	DATE
NOTE BOOK No. 6,7,8,9,10	SURVEYED	G.S., R.B., G.P.F.	OCT. 86
	PLOTTED	G.P.F. + R.W.B.	MAR. 87
	TEMPLATE	G.P.F.	APR. 87
	AREAS	R.W.B.	JUN. 90
	AREAS CHECKED	S.V.S.	SEPT. 90

CROSS SECTIONS
STA. 460+50 TO STA. 461+50
GROTON - RYEGATE F026-1(30)
SHEET 129 OF 152