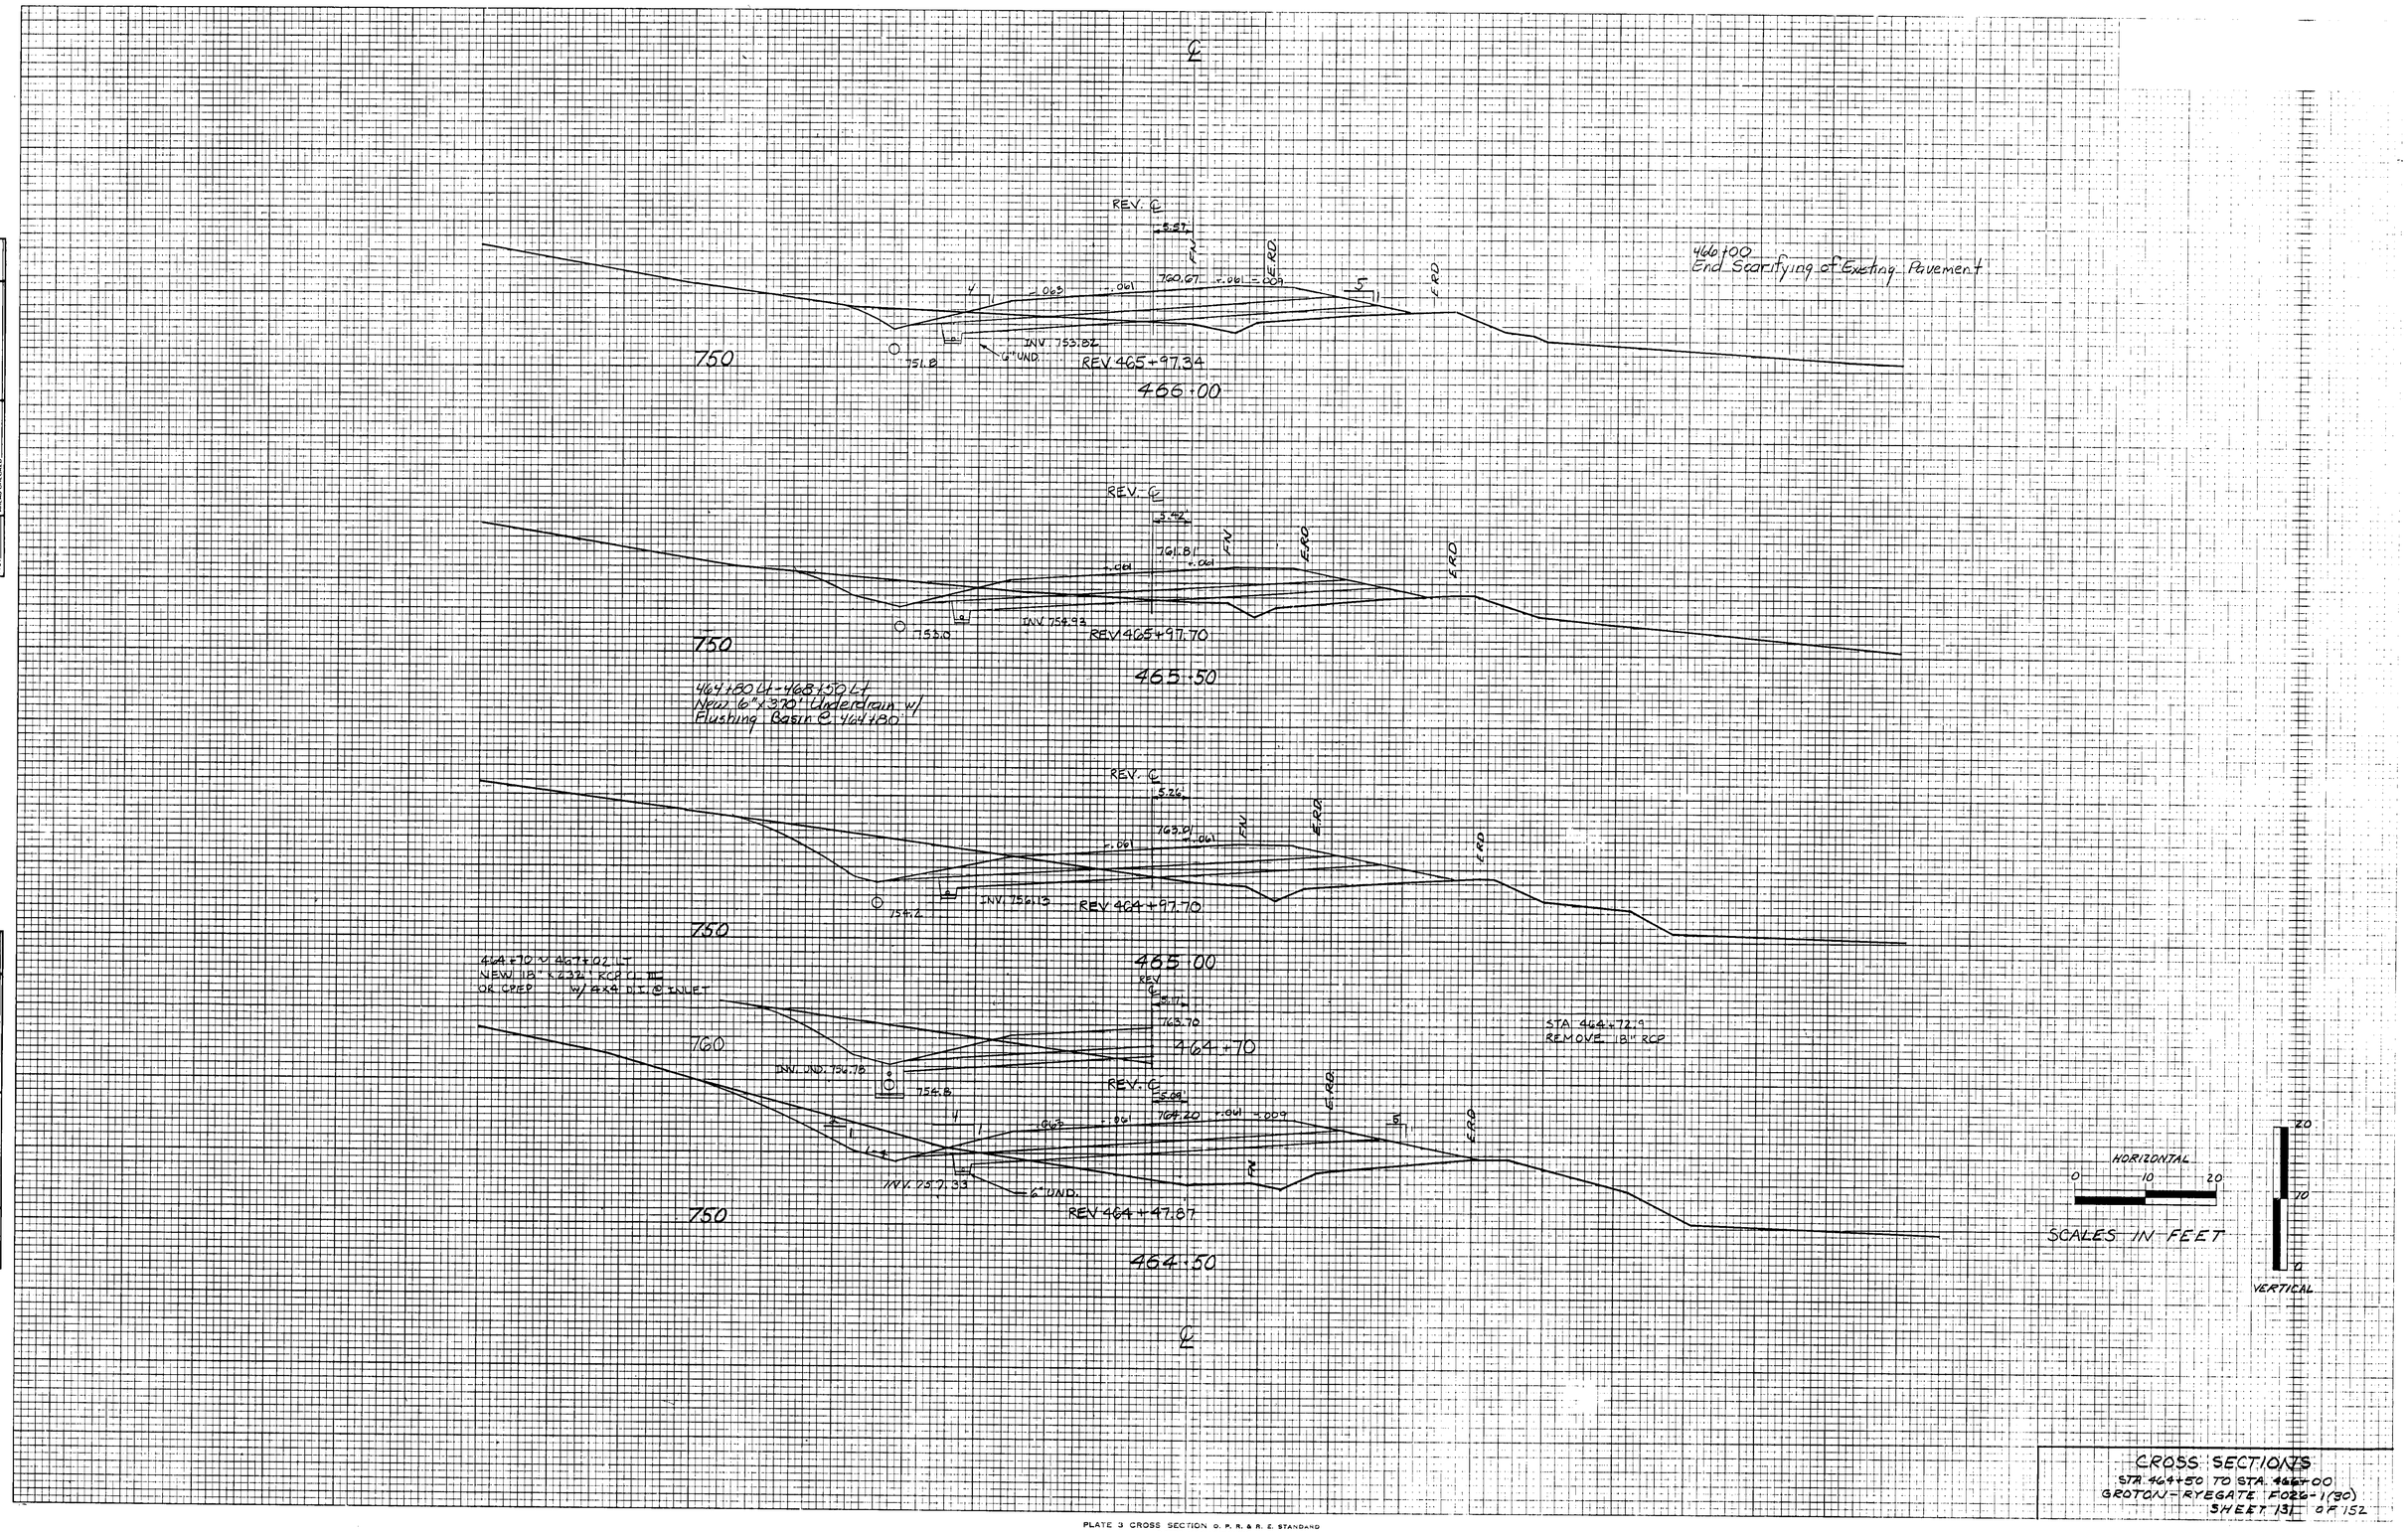

FINAL SURVEY	SURVEYED	DATE
NOTE BOOK	PLOTTED	BY
No.	TEMPLATE	
	AREAS	
	AREAS CHECKED	

ORIGINAL SURVEY	SURVEYED	BY	DATE
NOTE BOOK	PLOTTED	ECS, RCB, GPF	DEC. 86
No. 479, 525	TEMPLATE	GPF, RJB	MAR. 87
	AREAS	GPF	APR. 87
	AREAS CHECKED	RJB	MAY 1990
		SJS	SEPT. 90

CROSS SECTIONS
STA. 464+50 TO STA. 466+00
GROTON - RYEGATE F026-1(30)
SHEET 131 OF 152

PLATE 3 CROSS SECTION O. P. R. & R. E. STANDARD
DETZOLN CORPORATION