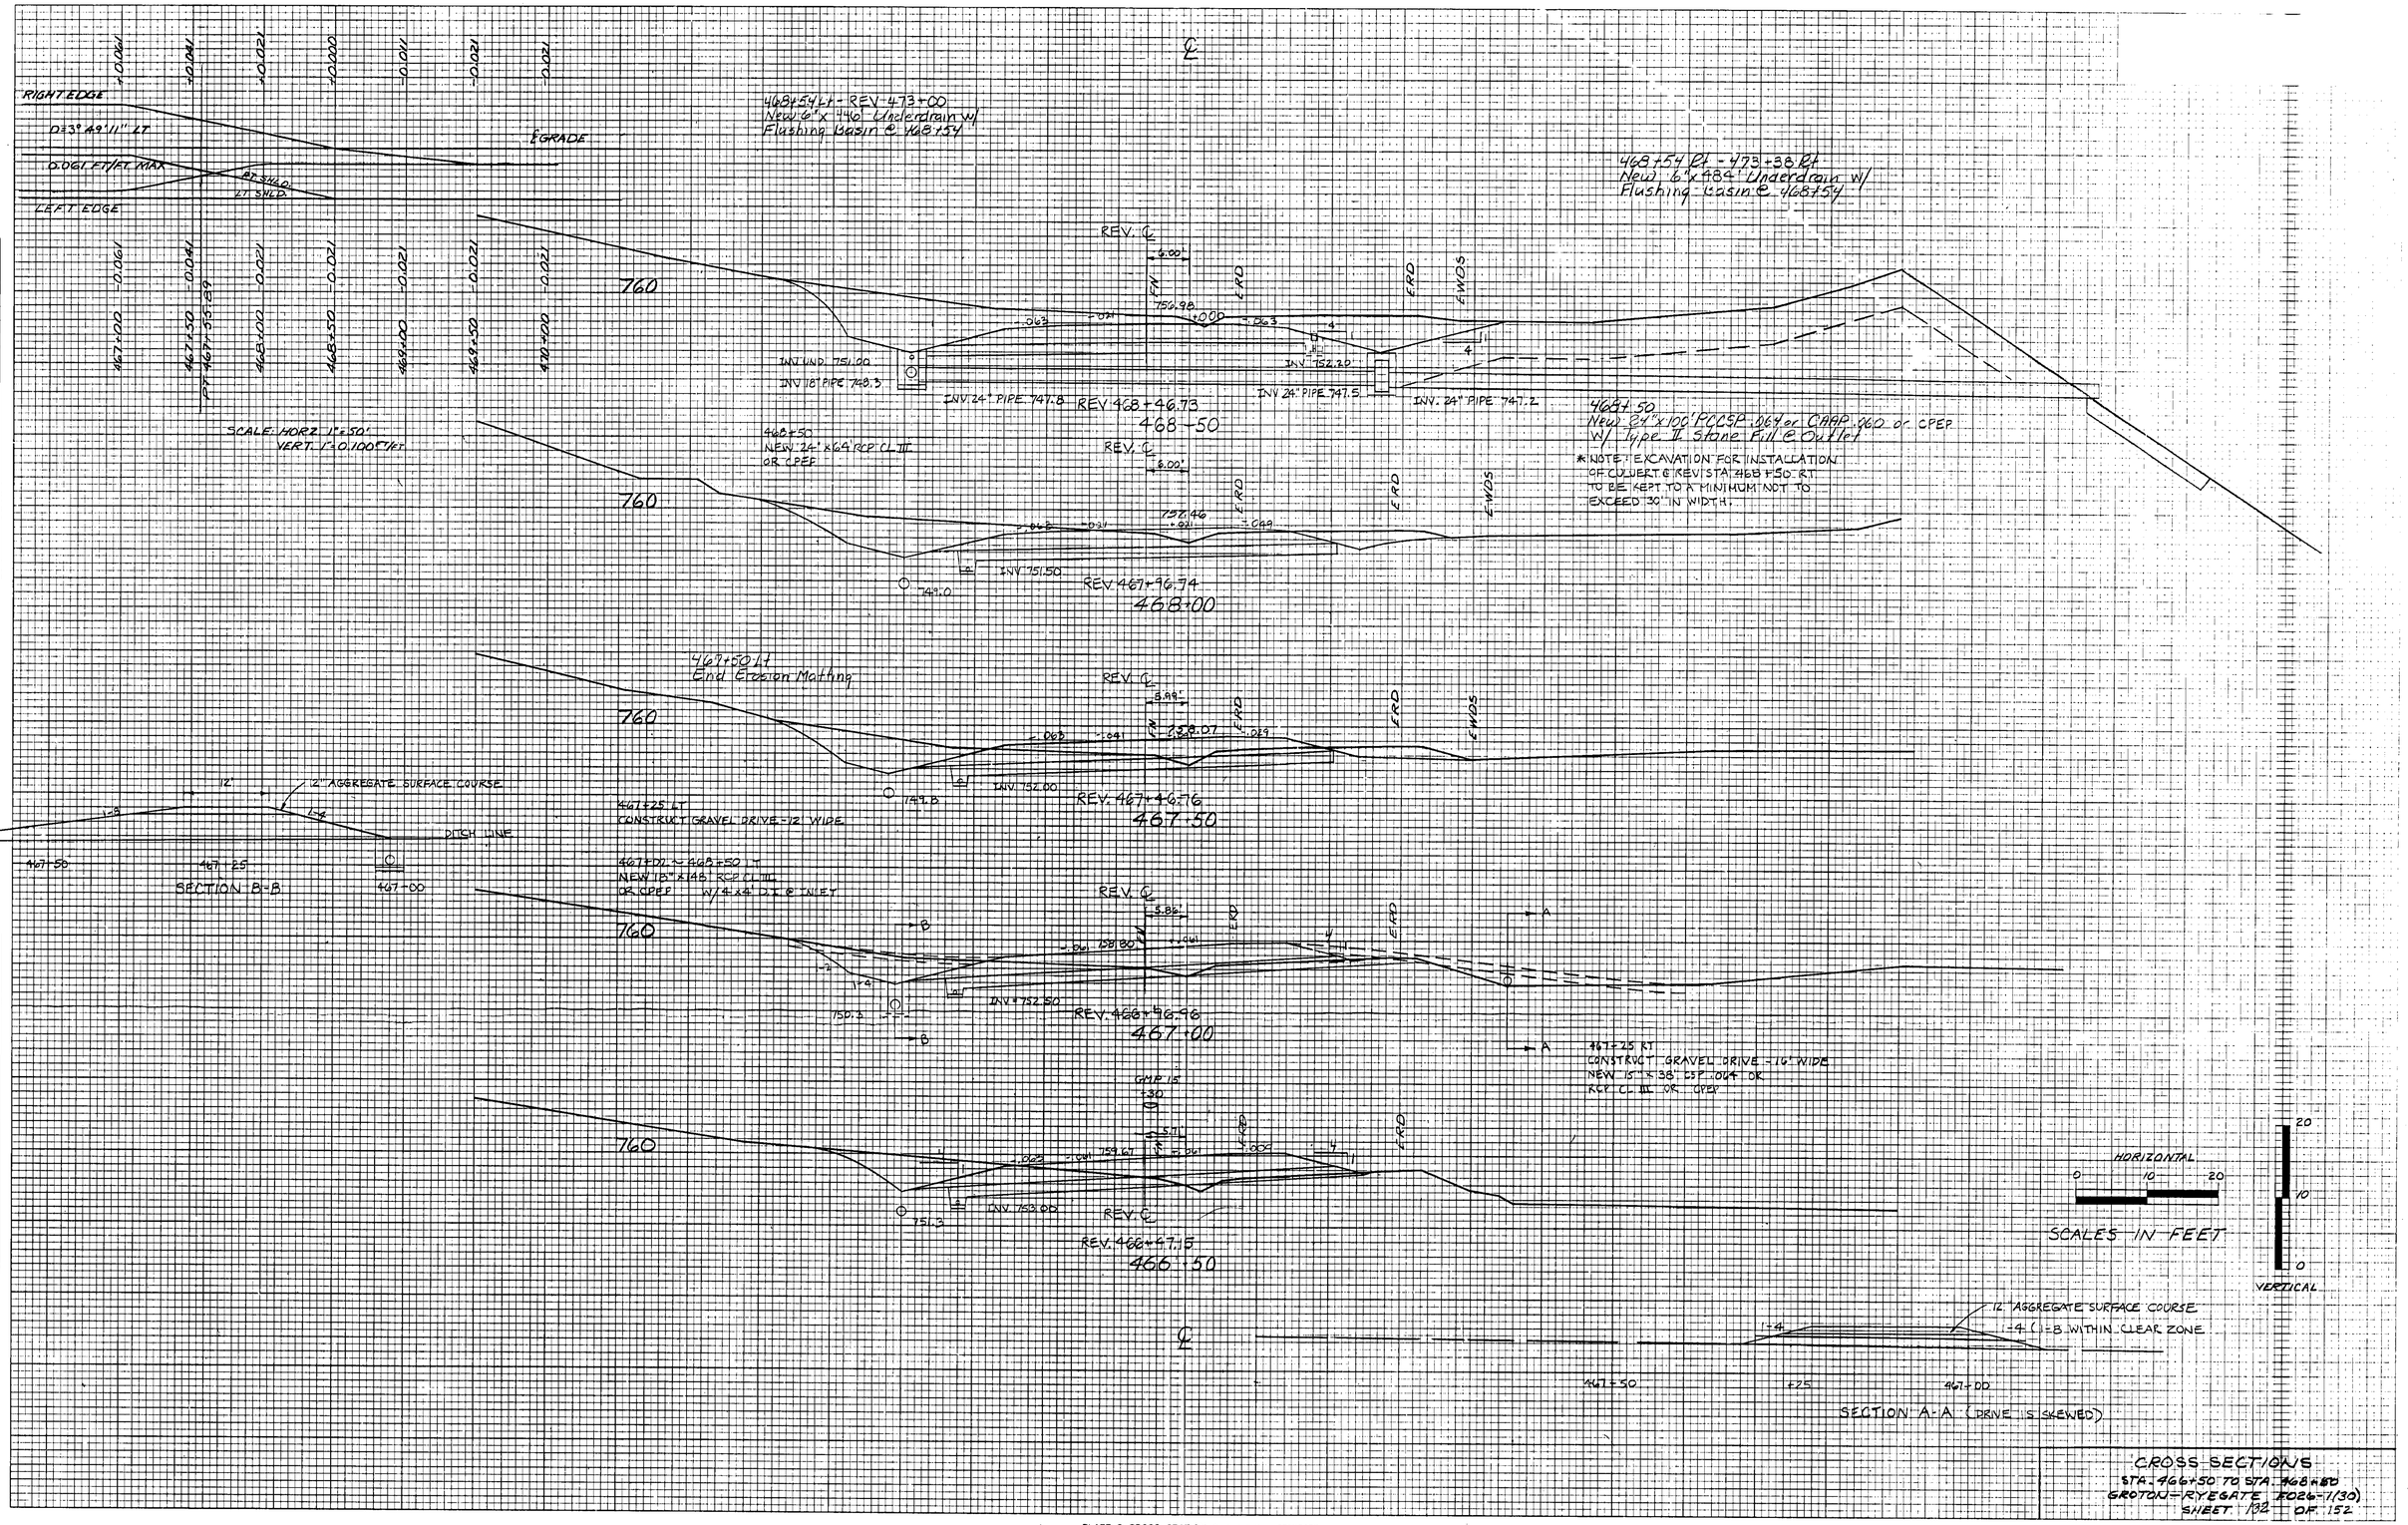

CROSS SECTIONS
STA. 466+50 TO STA. 468+50
GROTON-RYEGATE R026-1(30)
SHEET 132 OF 152

FINAL SURVEY			
NOTE BOOK No.	SURVEYED		DATE
	PLOTTED		BY
	TEMPLATE		
	AREAS		
	AREAS CHECKED		

ORIGINAL SURVEY			
NOTE BOOK No. 1,4,5,10, 11,14,15,22	SURVEYED	FCS, RGB, GPE	DATE JAN. 96
	PLOTTED	GPE, RWR	MAR. 97
	TEMPLATE	GPE	APR. 97
	AREAS	KBM	MAY 96
	AREAS CHECKED	SSD	SEPT. 96

PLATE 3 CROSS SECTION O. P. R. & R. E. STANDARD
DIETZGEN CORPORATION