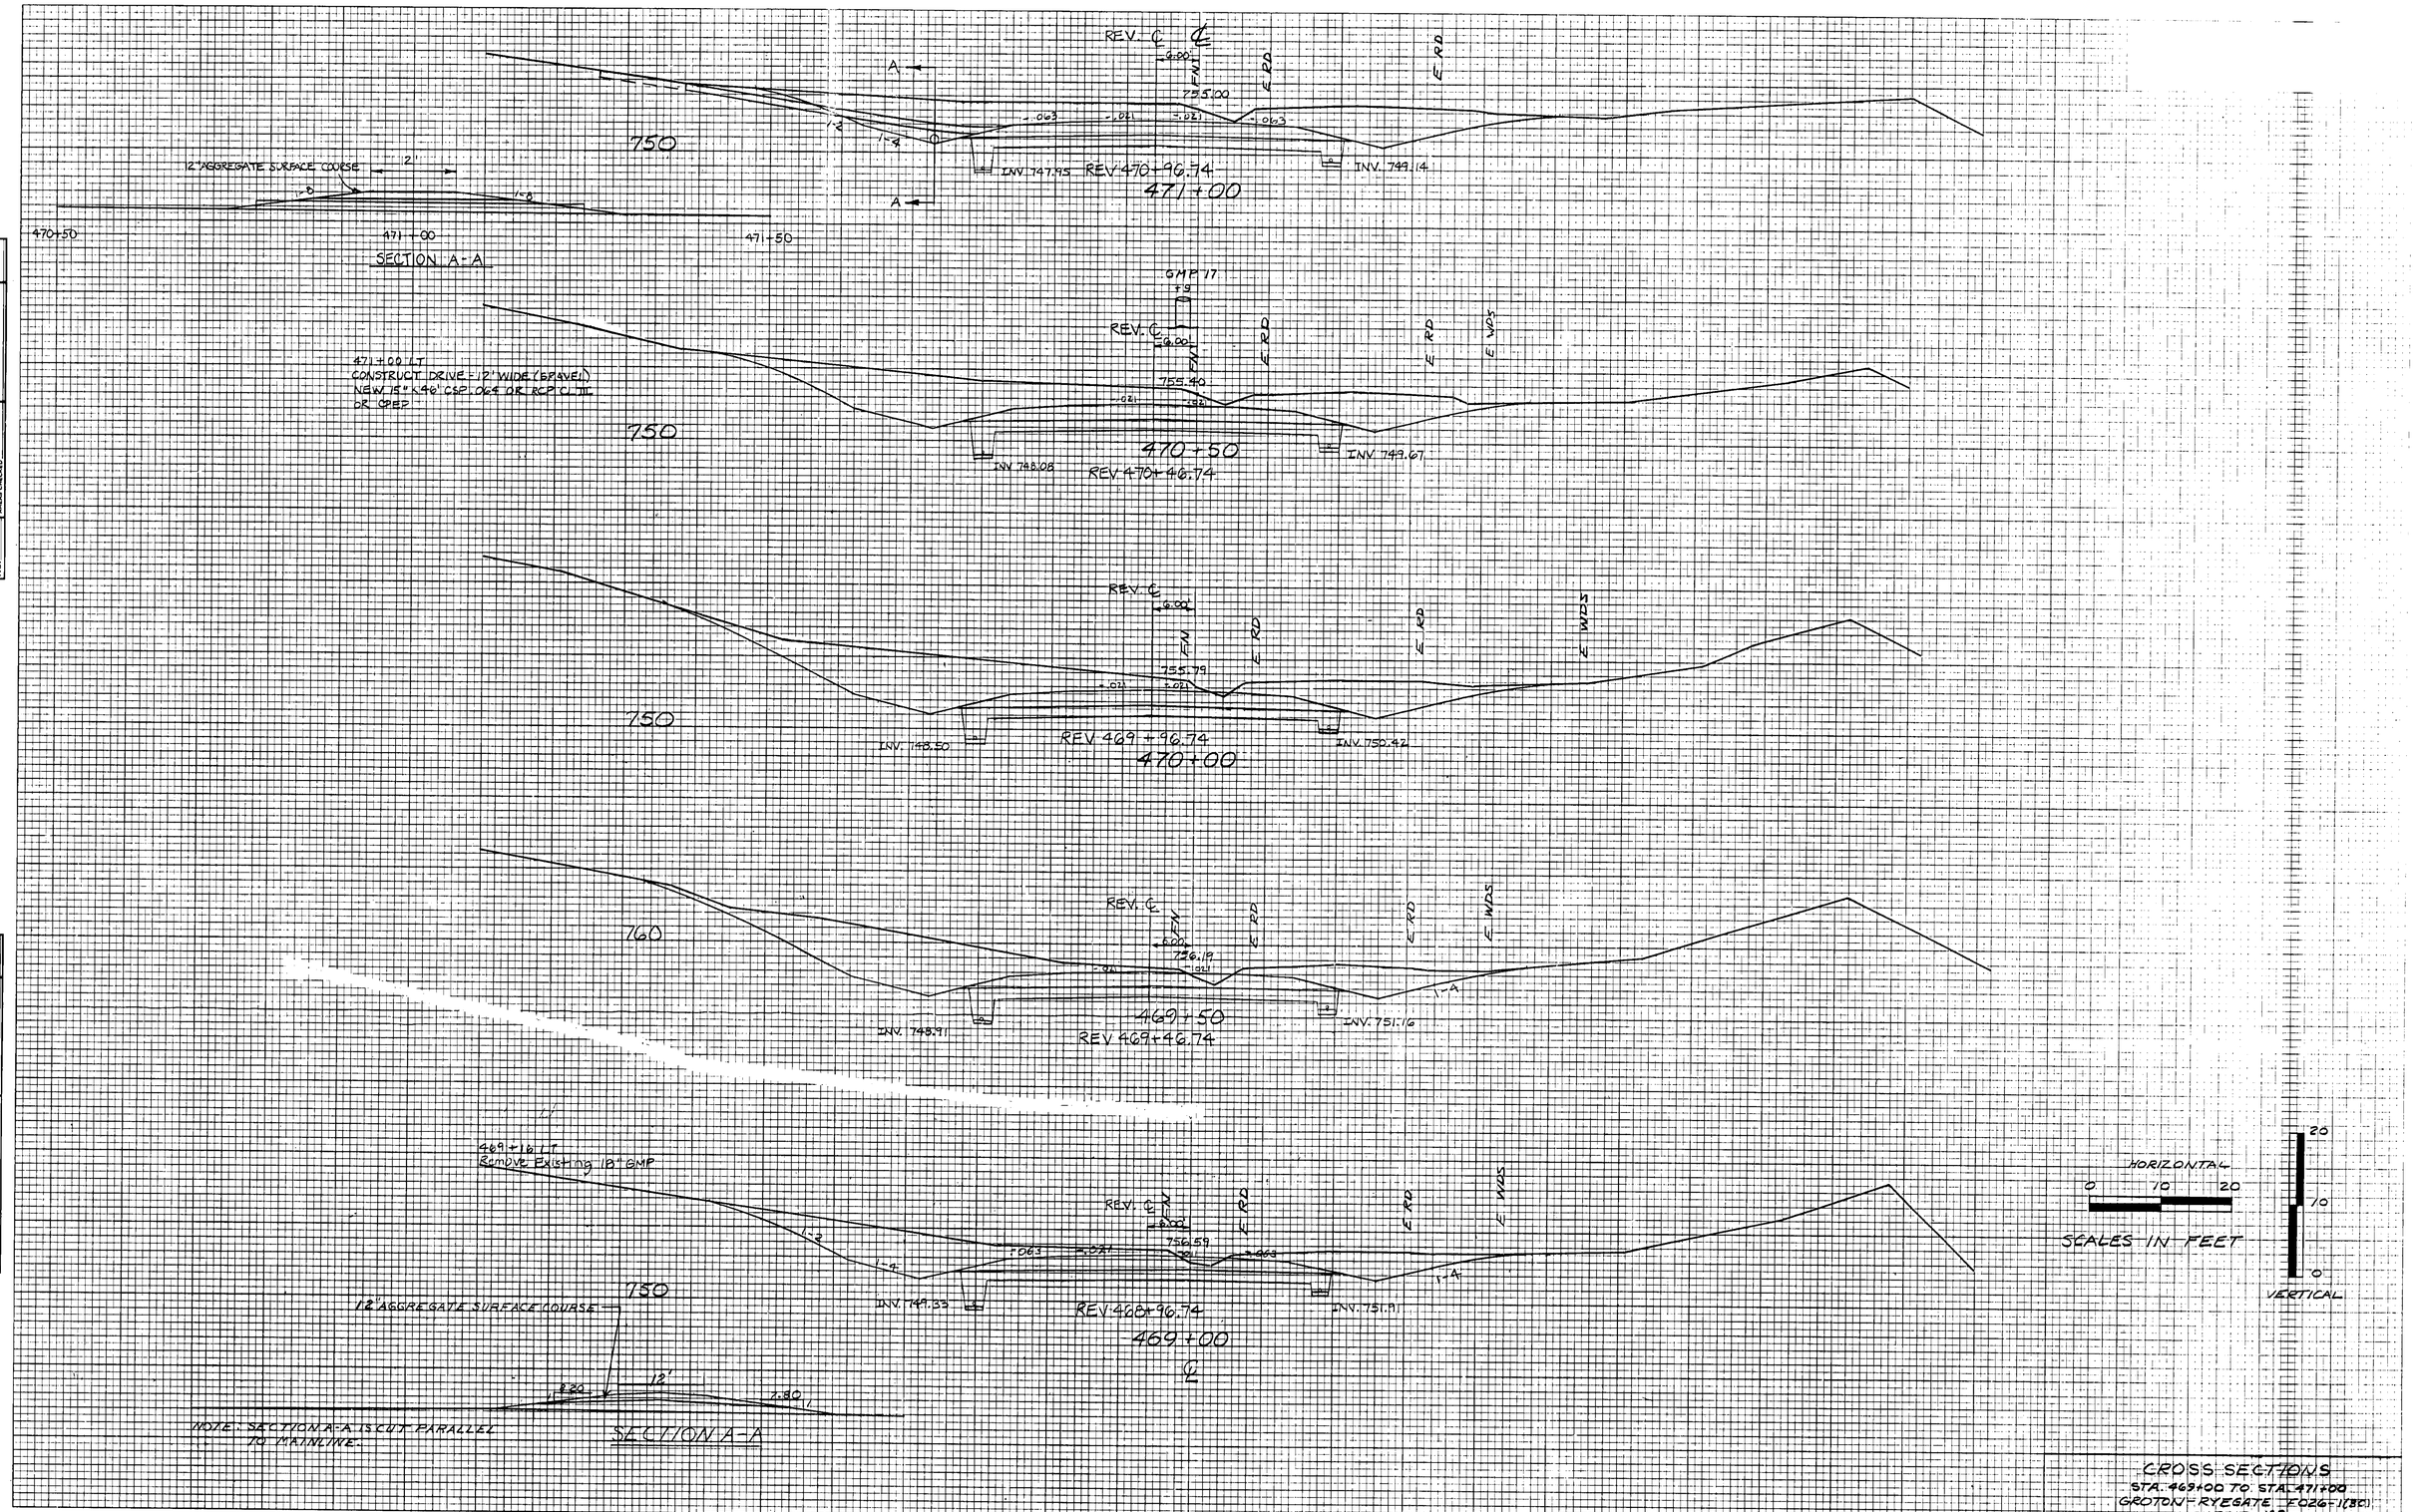

FINAL SURVEY			
NOTE BOOK	SURVEYED		
	PLOTTED		
	TEMPLATE		
	AREAS		
No.	AREAS CHECKED		

ORIGINAL SURVEY		BY	DATE
NOTE BOOK	SURVEYED	R.G.S.	DEC. 86
1006	PLOTTED	G.P.F.	MAR. 87
No. 6/6/87	TEMPLATE	R.W.B.	MAR. 87
	AREAS	G.P.F.	APR. 87
	AREAS CHECKED	R.W.	MAY 87
		S.V.S.	SEPT. 90

CROSS SECTIONS
STA. 469+00 TO STA. 471+00
GROTON - RYEGATE F-026-1(80)
SHEET 133 OF 152