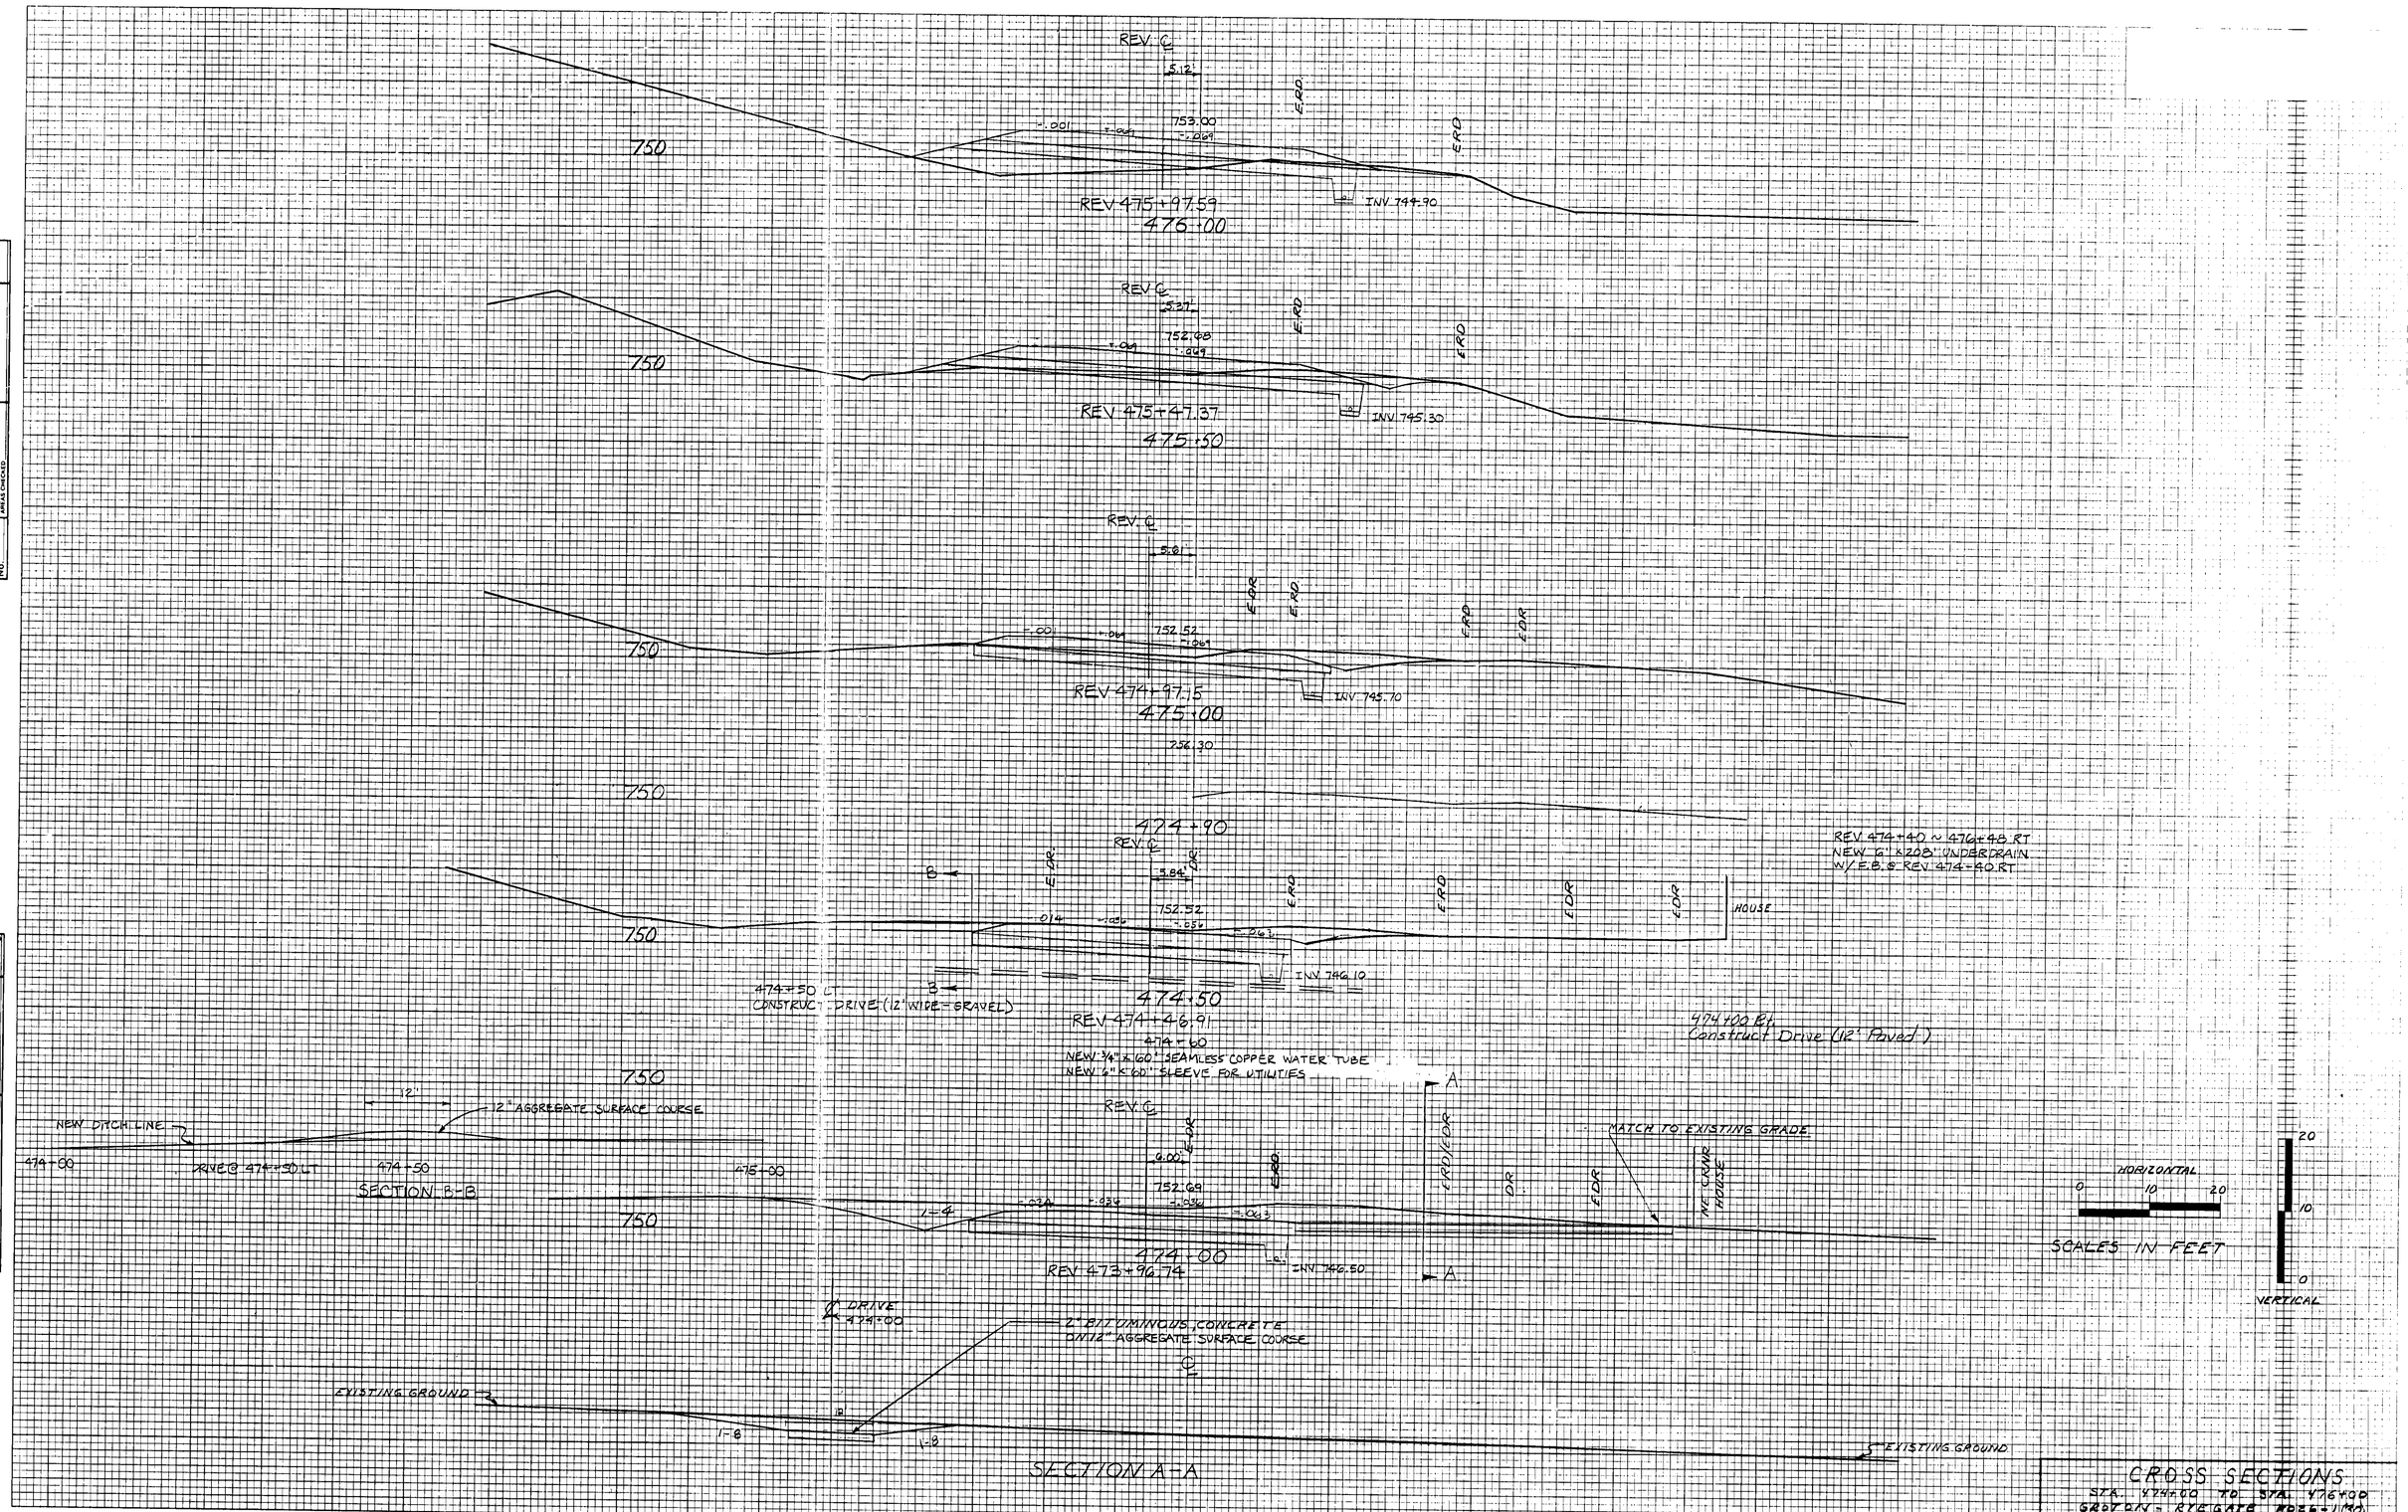

FINAL SURVEY			BY	DATE
NOTE BOOK No.	SURVEYED			
	PLOTTED			
	TEMPLATE			
	AREAS			
	AREAS CHECKED			

ORIGINAL SURVEY			BY	DATE
NOTE BOOK No. 598, 600, 627, 637	SURVEYED	E.C.S., E.G.B., G.F.E.		DEC. 80
	PLOTTED	G.F.E., R.L.B.		MAR. 81
	TEMPLATE			APR. 81
	AREAS	E.F.E.		JUL. 80
	AREAS CHECKED	RAN		SEPT. 80
		SJS		

CROSS SECTIONS

STA. 474+00 TO STA. 476+00

GROUNDS - RYE GATE ROAD (30)

SHEET 135 OF 152