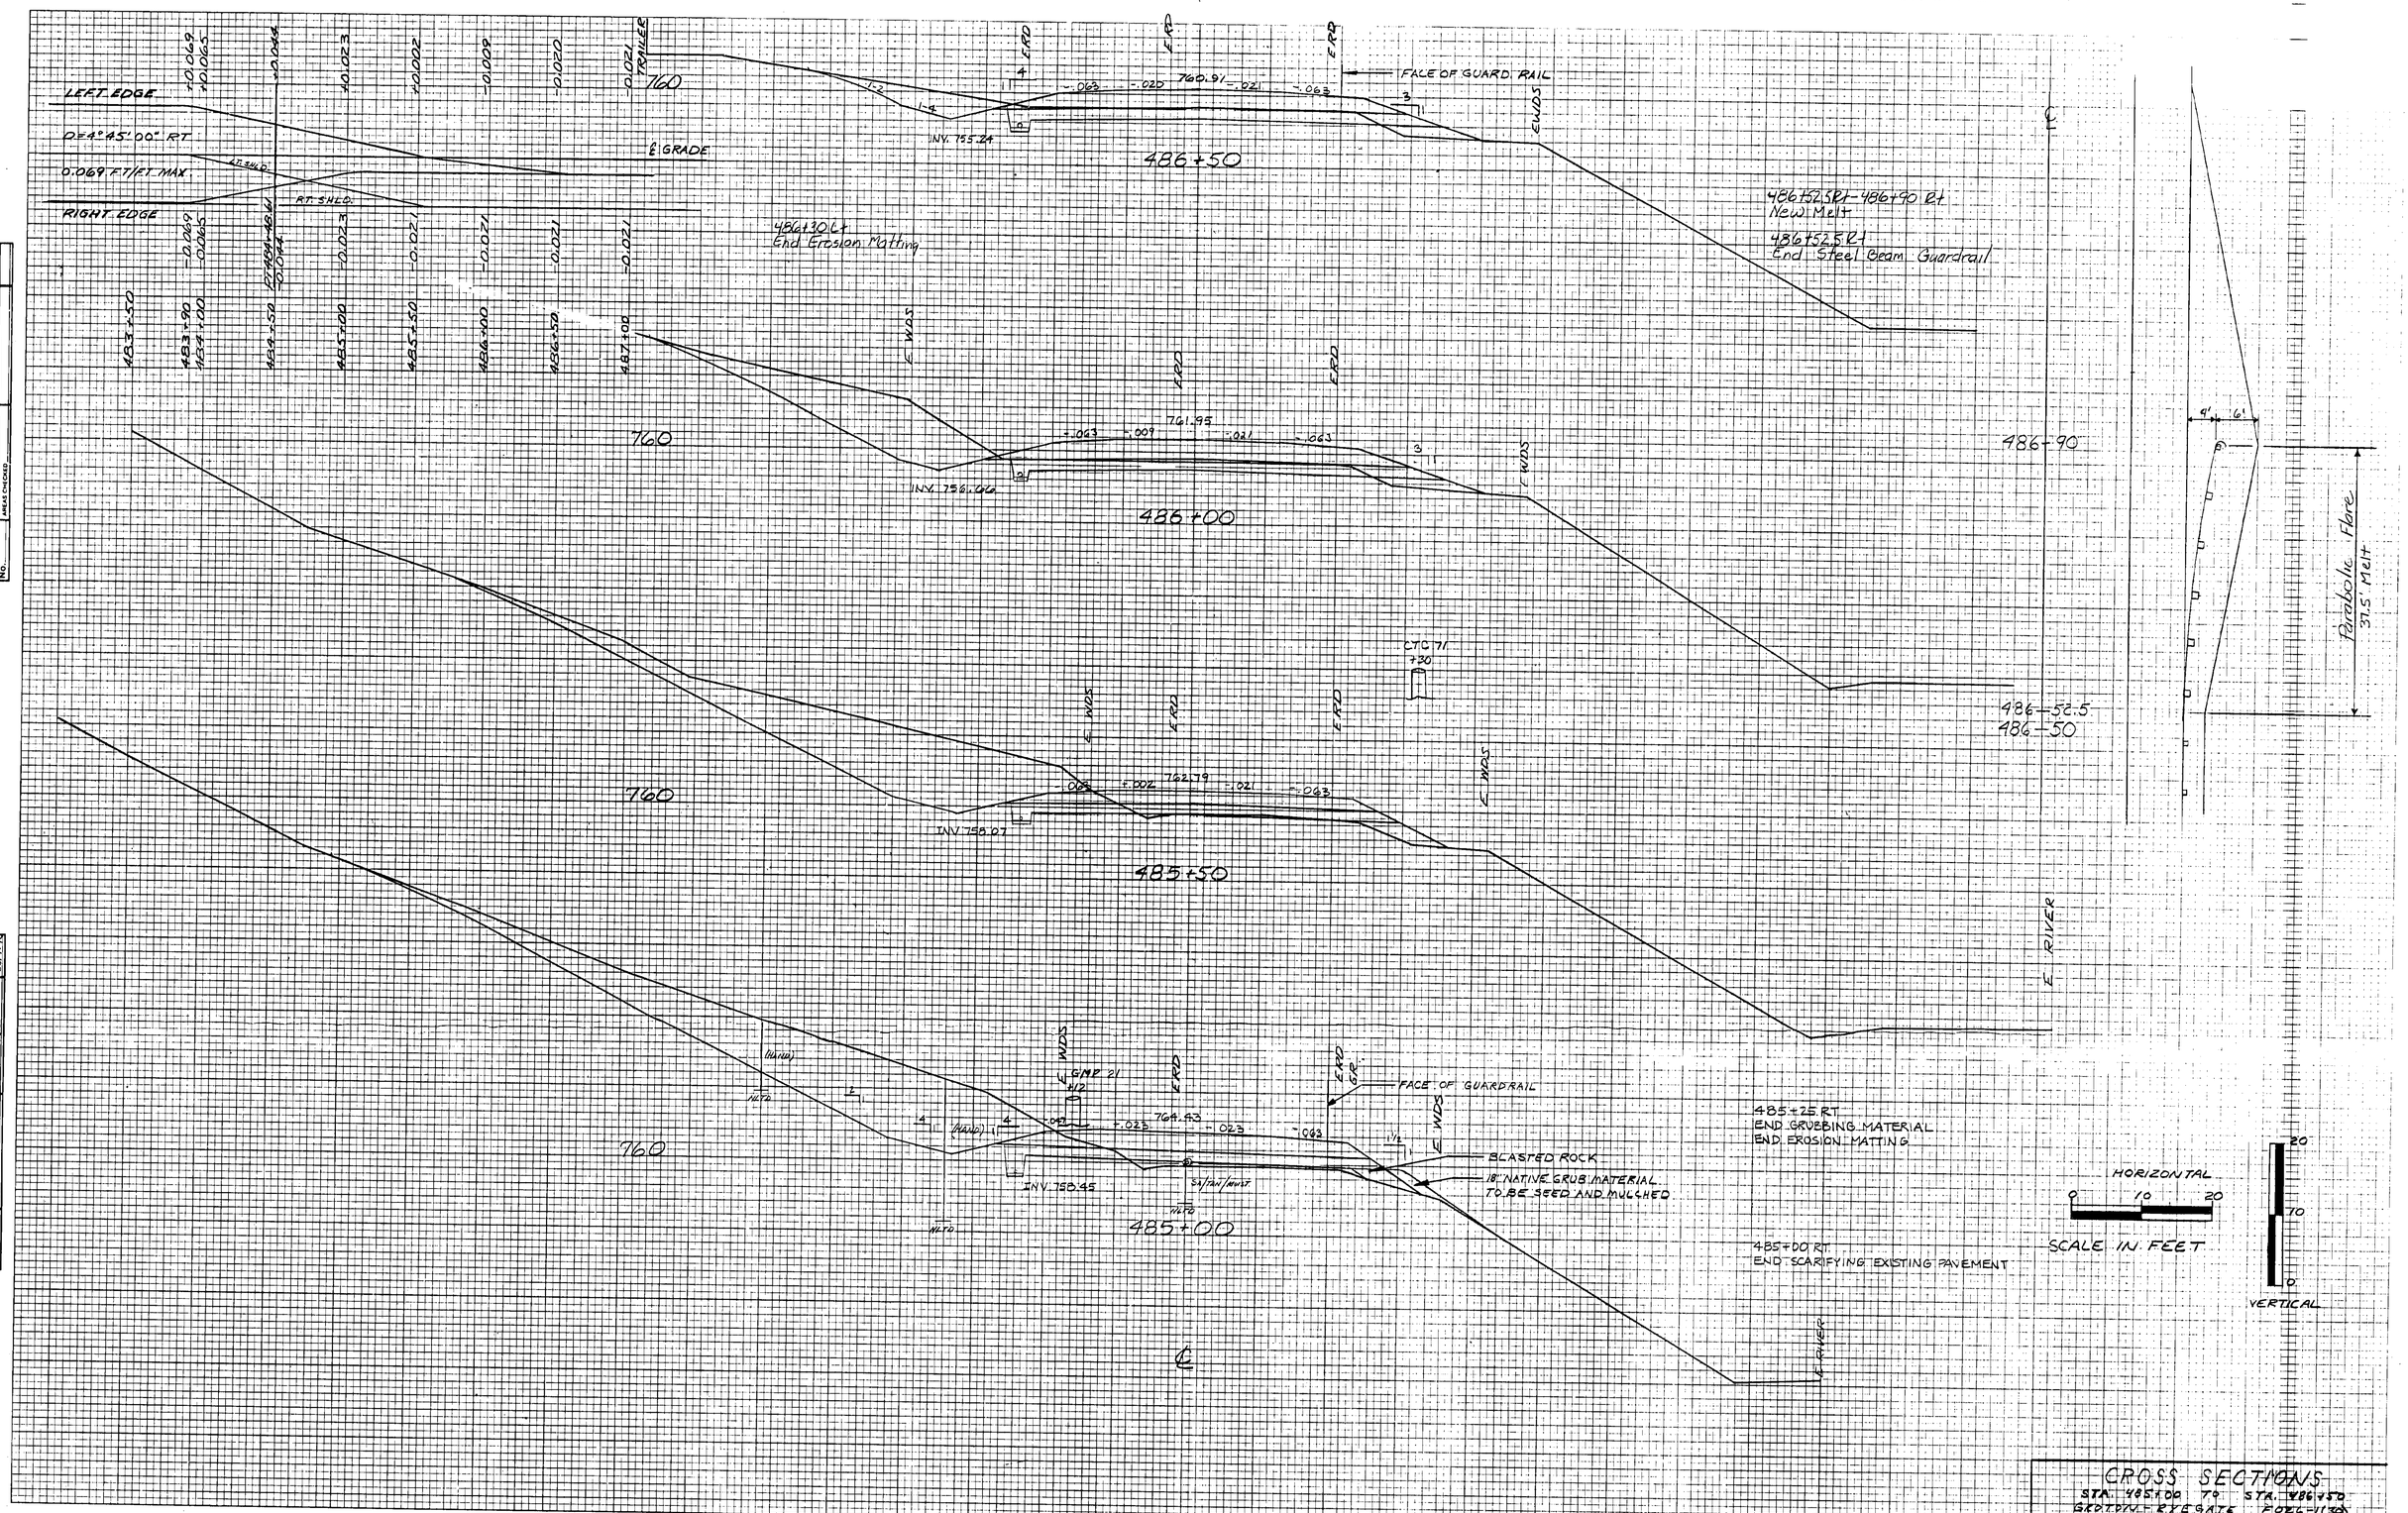

FINAL SURVEY		BY	DATE
NOTE BOOK	SURVEYED	RCP, RG, GFF	DEC. 86
	PLOTTED	GFF, RJB	APR. 87
	TEMPLATE	GFF	APR. 87
	AREAS	RAJ	JAN. 90
No.	AREAS CHECKED	SSS	SEPT. 90

ORIGINAL SURVEY		BY	DATE
NOTE BOOK	SURVEYED		
	PLOTTED		
	TEMPLATE		
	AREAS		
No.	AREAS CHECKED		

CROSS SECTIONS
STA. 485+00 TO STA. 486+50
SKOTPW-RYE GATE P026-1(30)
SHEET 140 OF 152