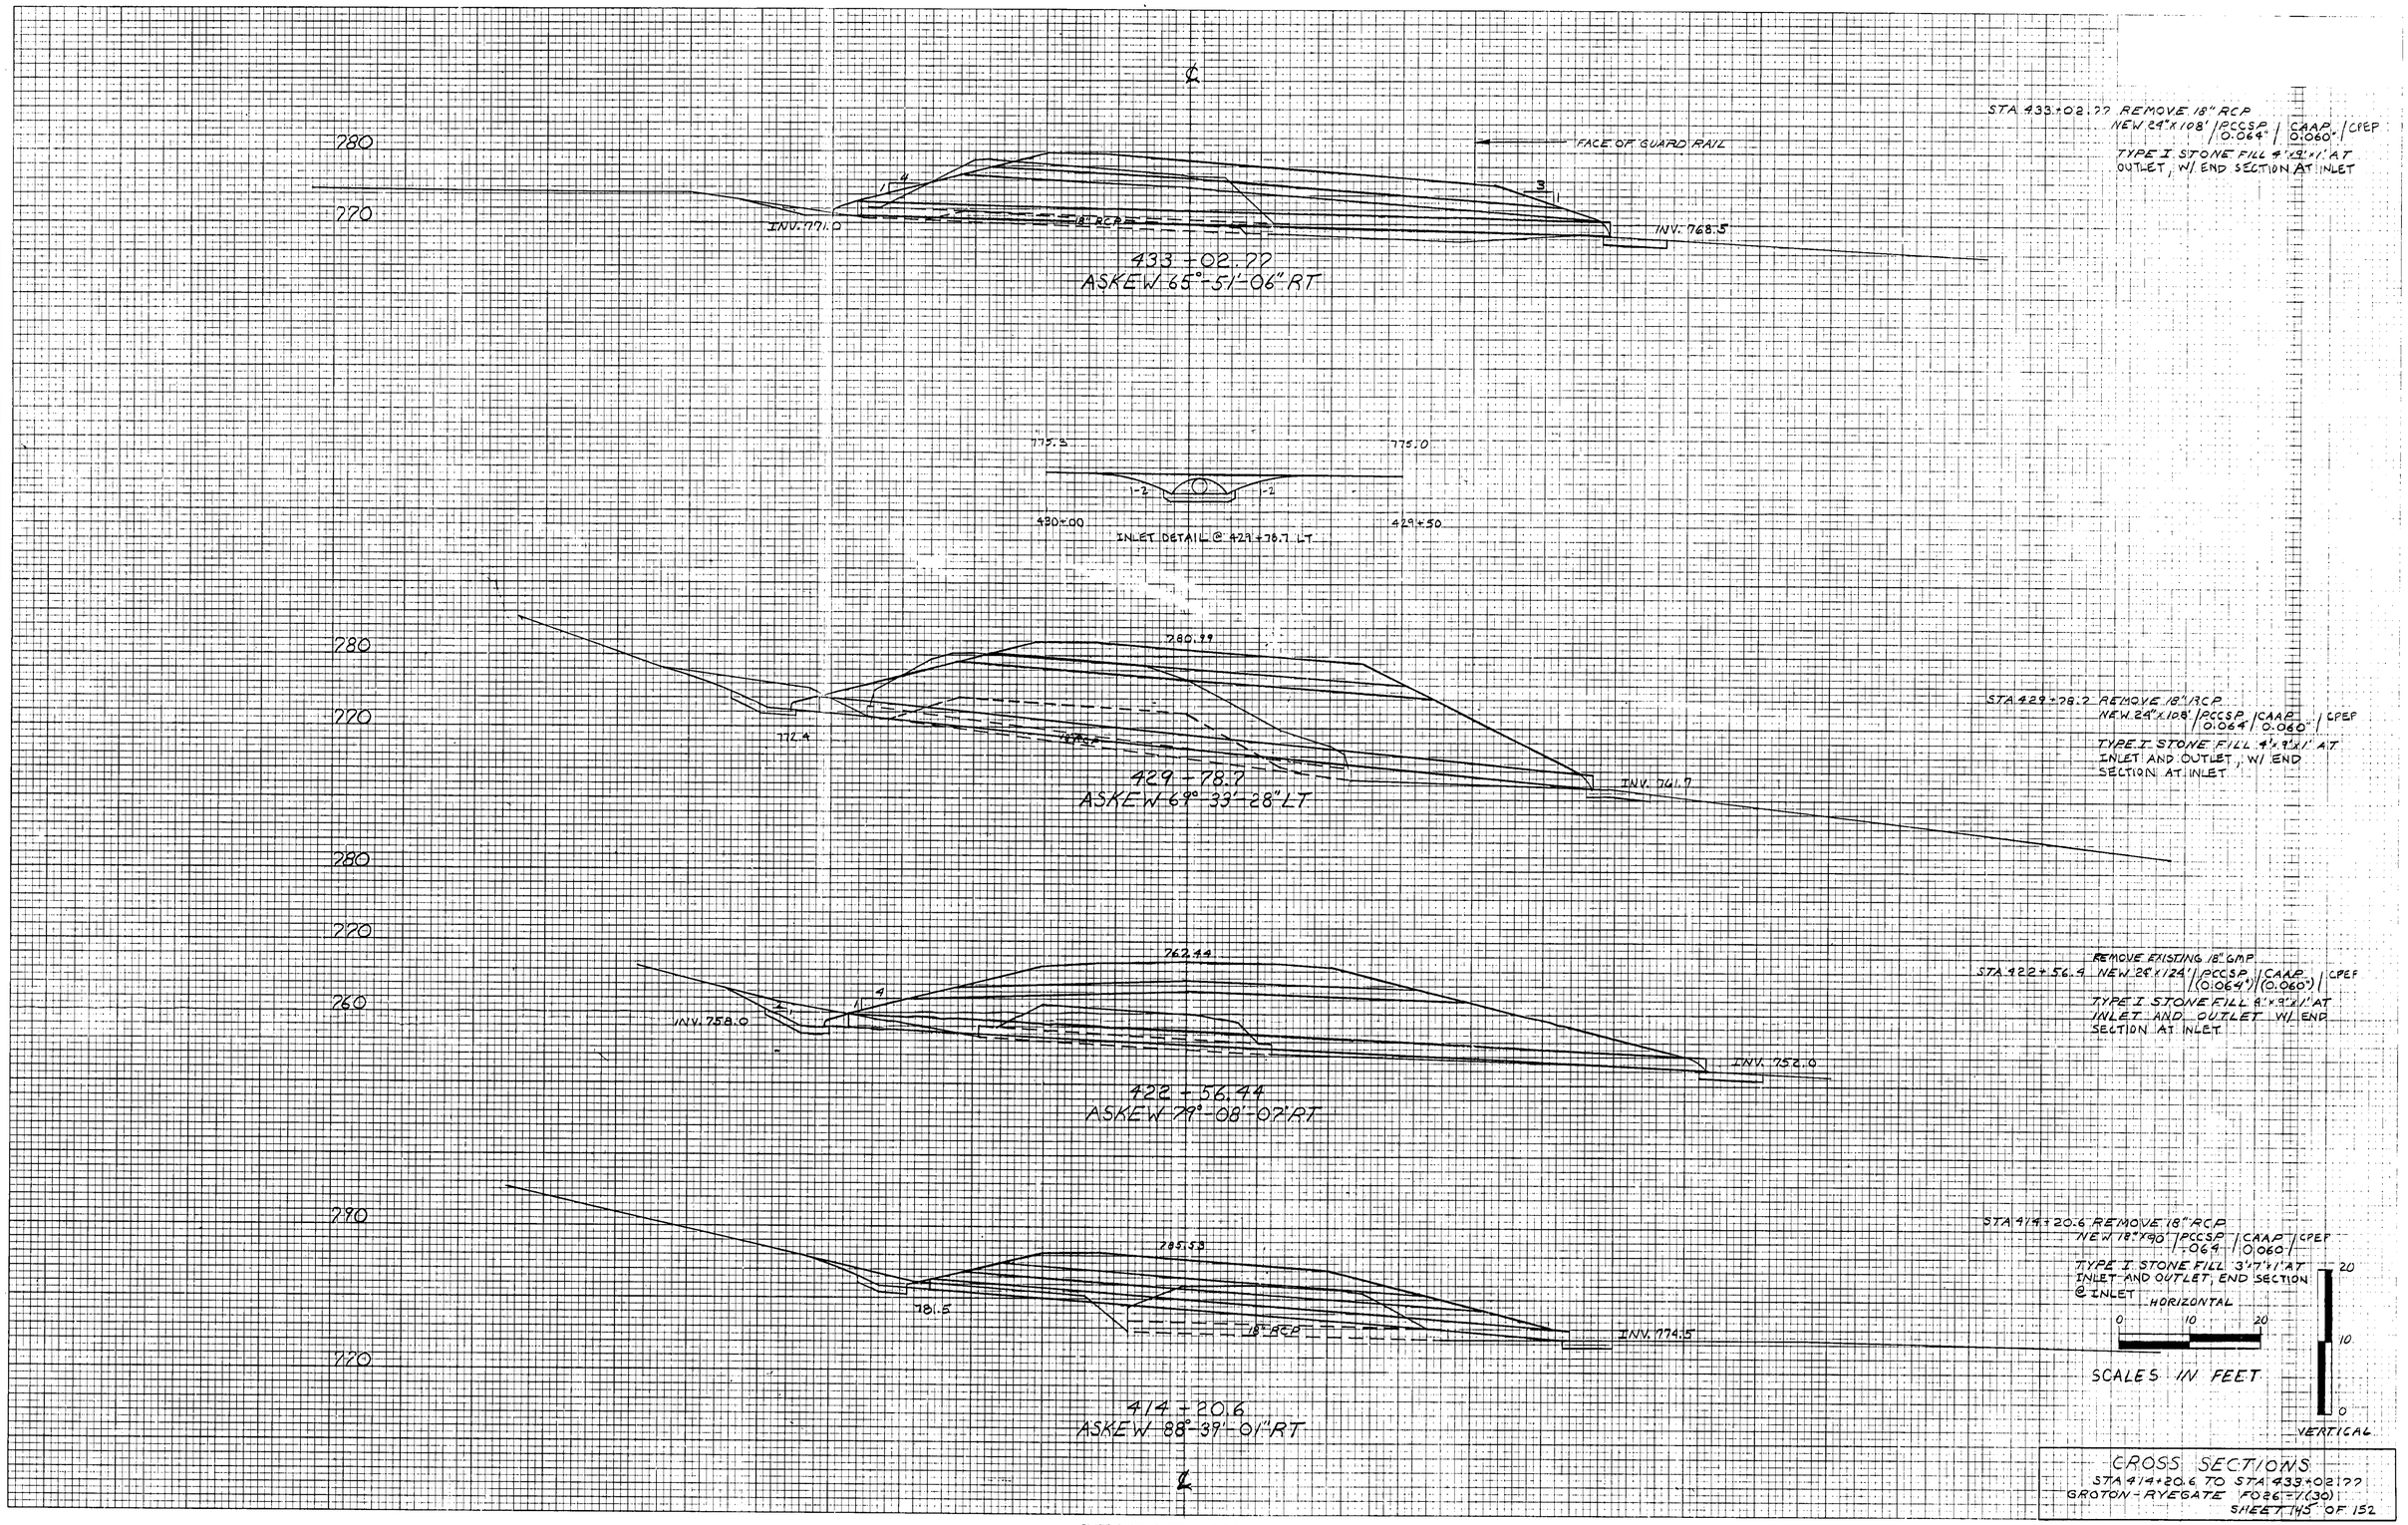

CROSS SECTIONS
STA 414+20.6 TO STA 433+02.77
GROTON - RYEGATE F026-7(30)
SHEET 145 OF 152

FINAL SURVEY	SURVEYED	BY	DATE
NOTE BOOK	PLOTTED	REF. FBS	MAY 1986
	TEMPLATE	RAU	FEB. 1988
	AREAS	RAU	FEB. 1988
No.	AREAS CHECKED	RAU	FEB. 1988
		RAU	SEP. 1990
		SJS	SEP. 1990

ORIGINAL SURVEY	SURVEYED	BY	DATE
NOTE BOOK	PLOTTED	REF. FBS	MAY 1986
	TEMPLATE	RAU	FEB. 1988
No. 651	AREAS	RAU	FEB. 1988
	AREAS CHECKED	SJS	SEP. 1990