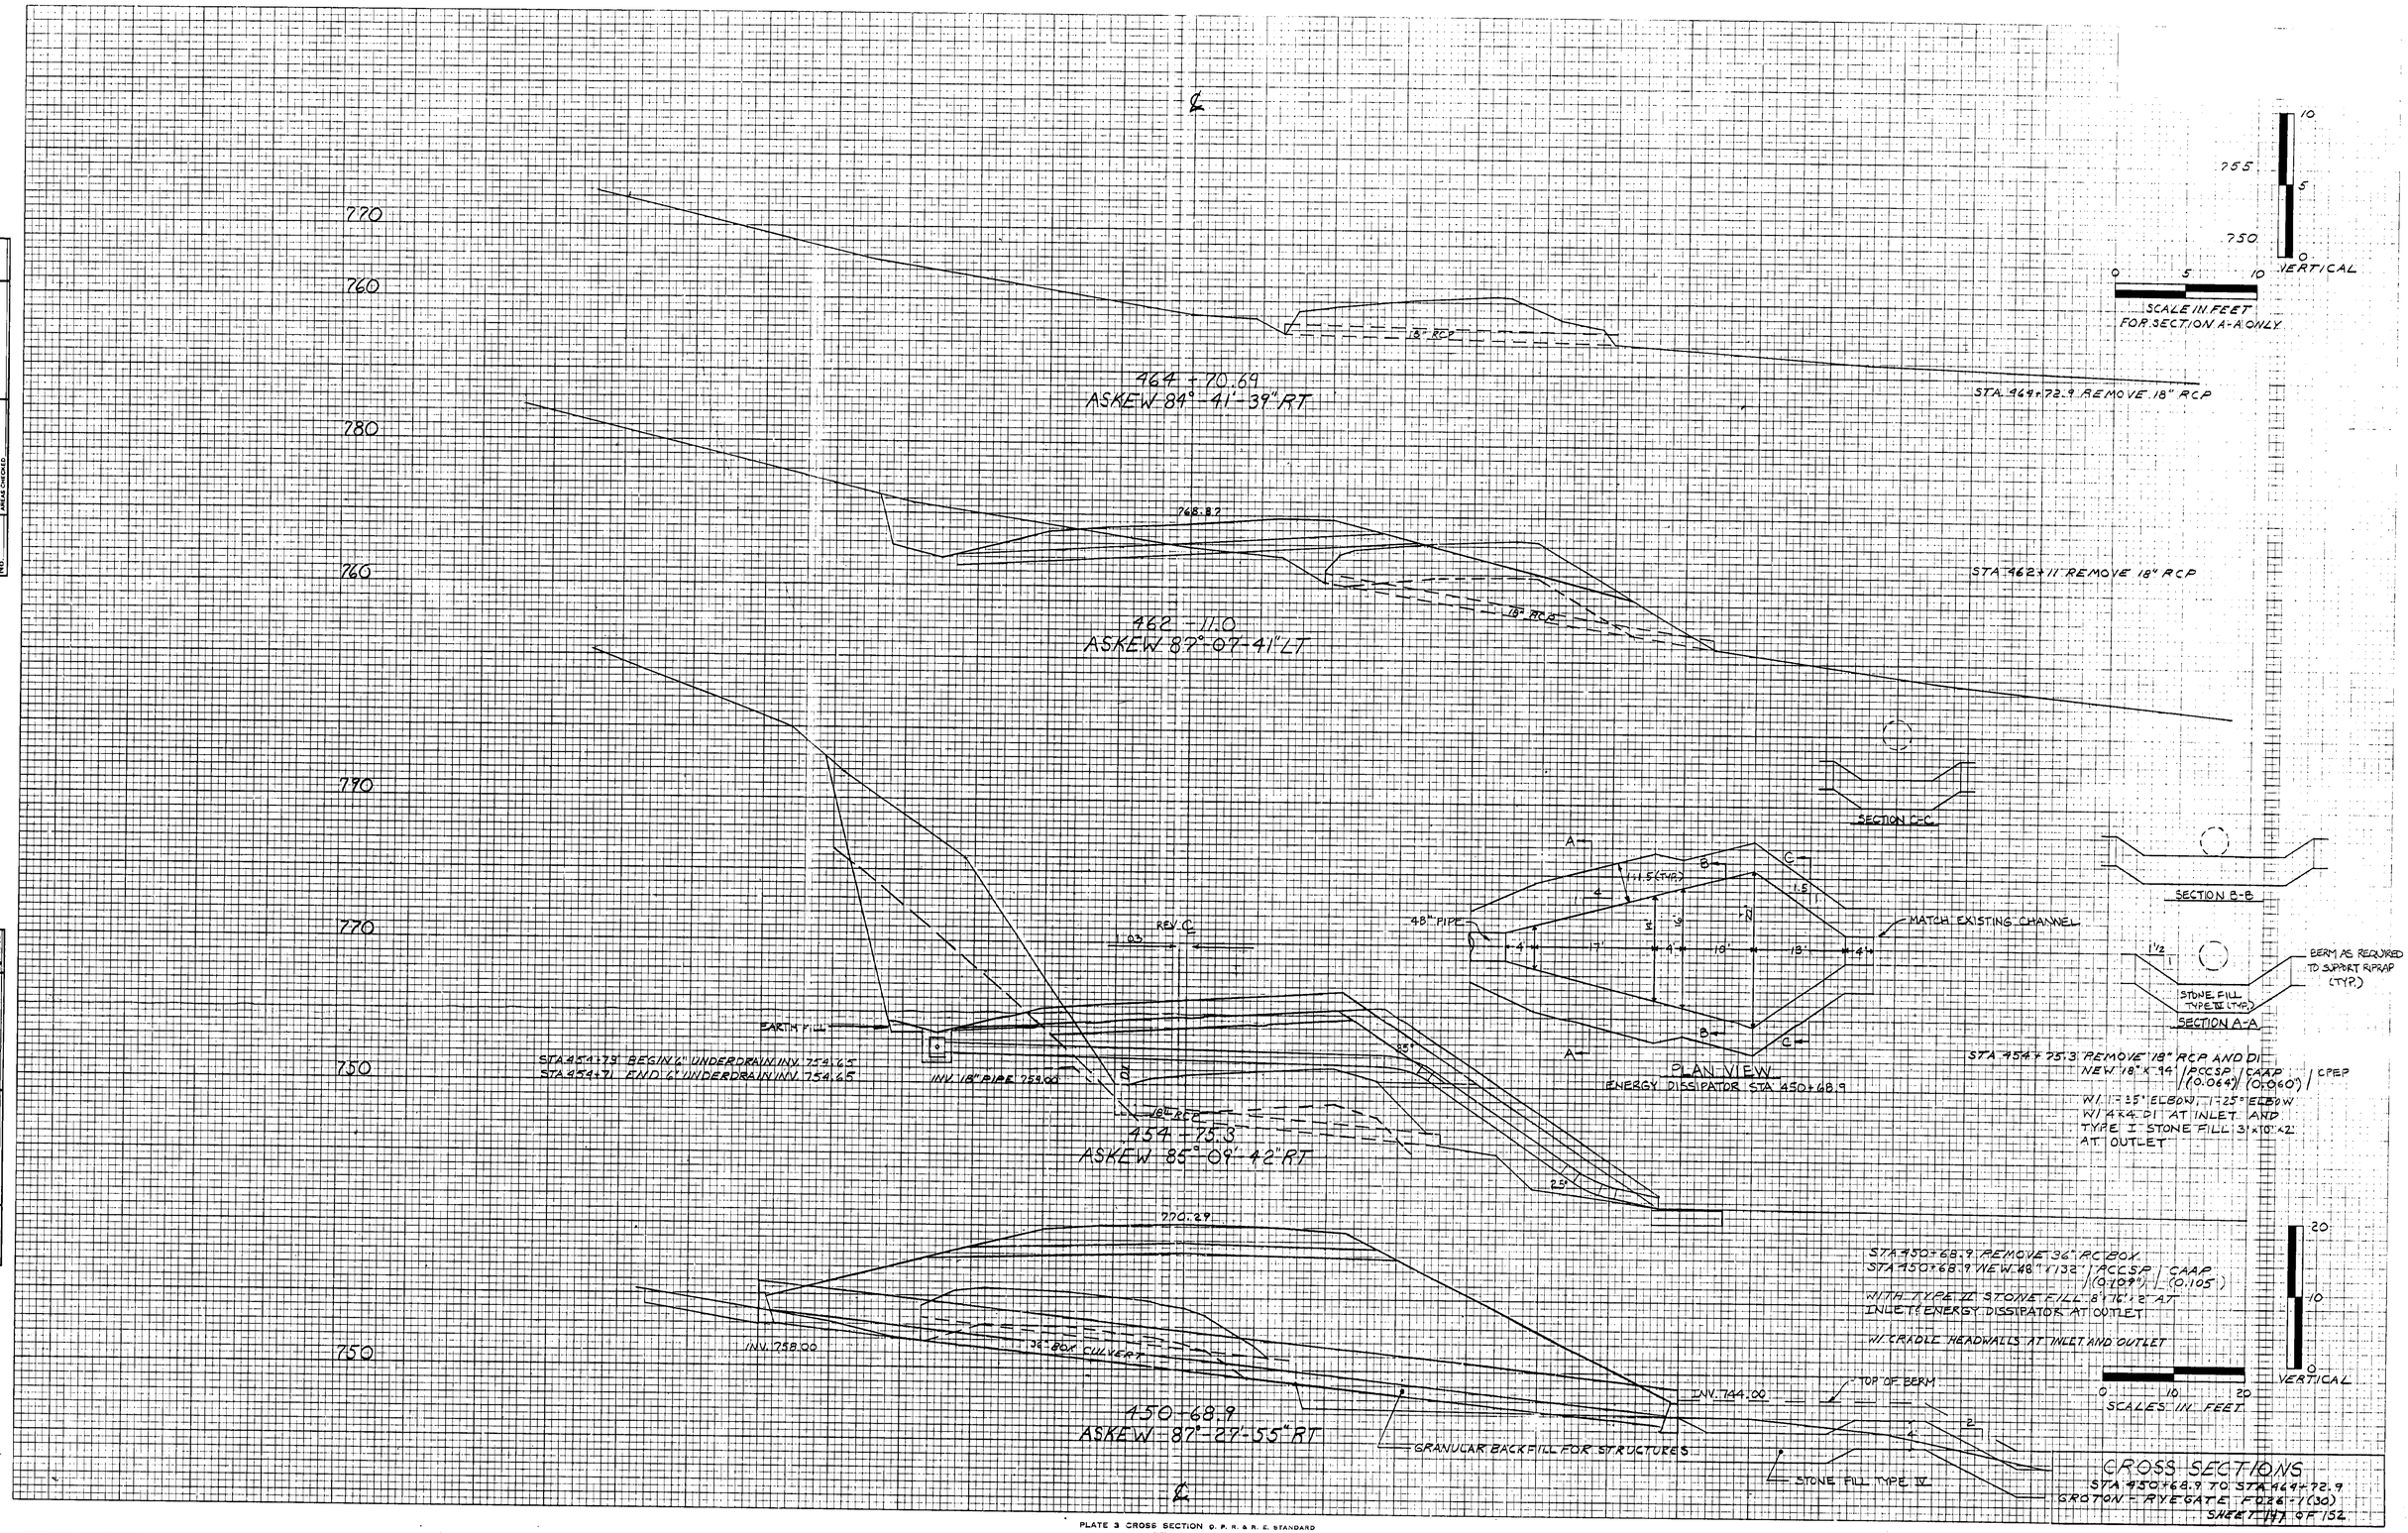

FINAL SURVEY			BY	DATE
NOTE BOOK	SURVEYED			
	PLOTTED			
	TEMPLATE			
	AREAS			
No.	AREAS CHECKED			

ORIGINAL SURVEY		BY	DATE
NOTE BOOK No. 657	SURVEYED	RCP, CBS	MAR. 88
	PLOTTED	GFP, RWB	MAR. 87
	TEMPLATE	GFP	MAR. 87
	AREAS	RWJ	JAN. 90
	AREAS CHECKED	SJS	SEPT. 90

PLATE 3 CROSS SECTION D. P. R. & R. E. STANDARD
DIETZGEN CORPORATION