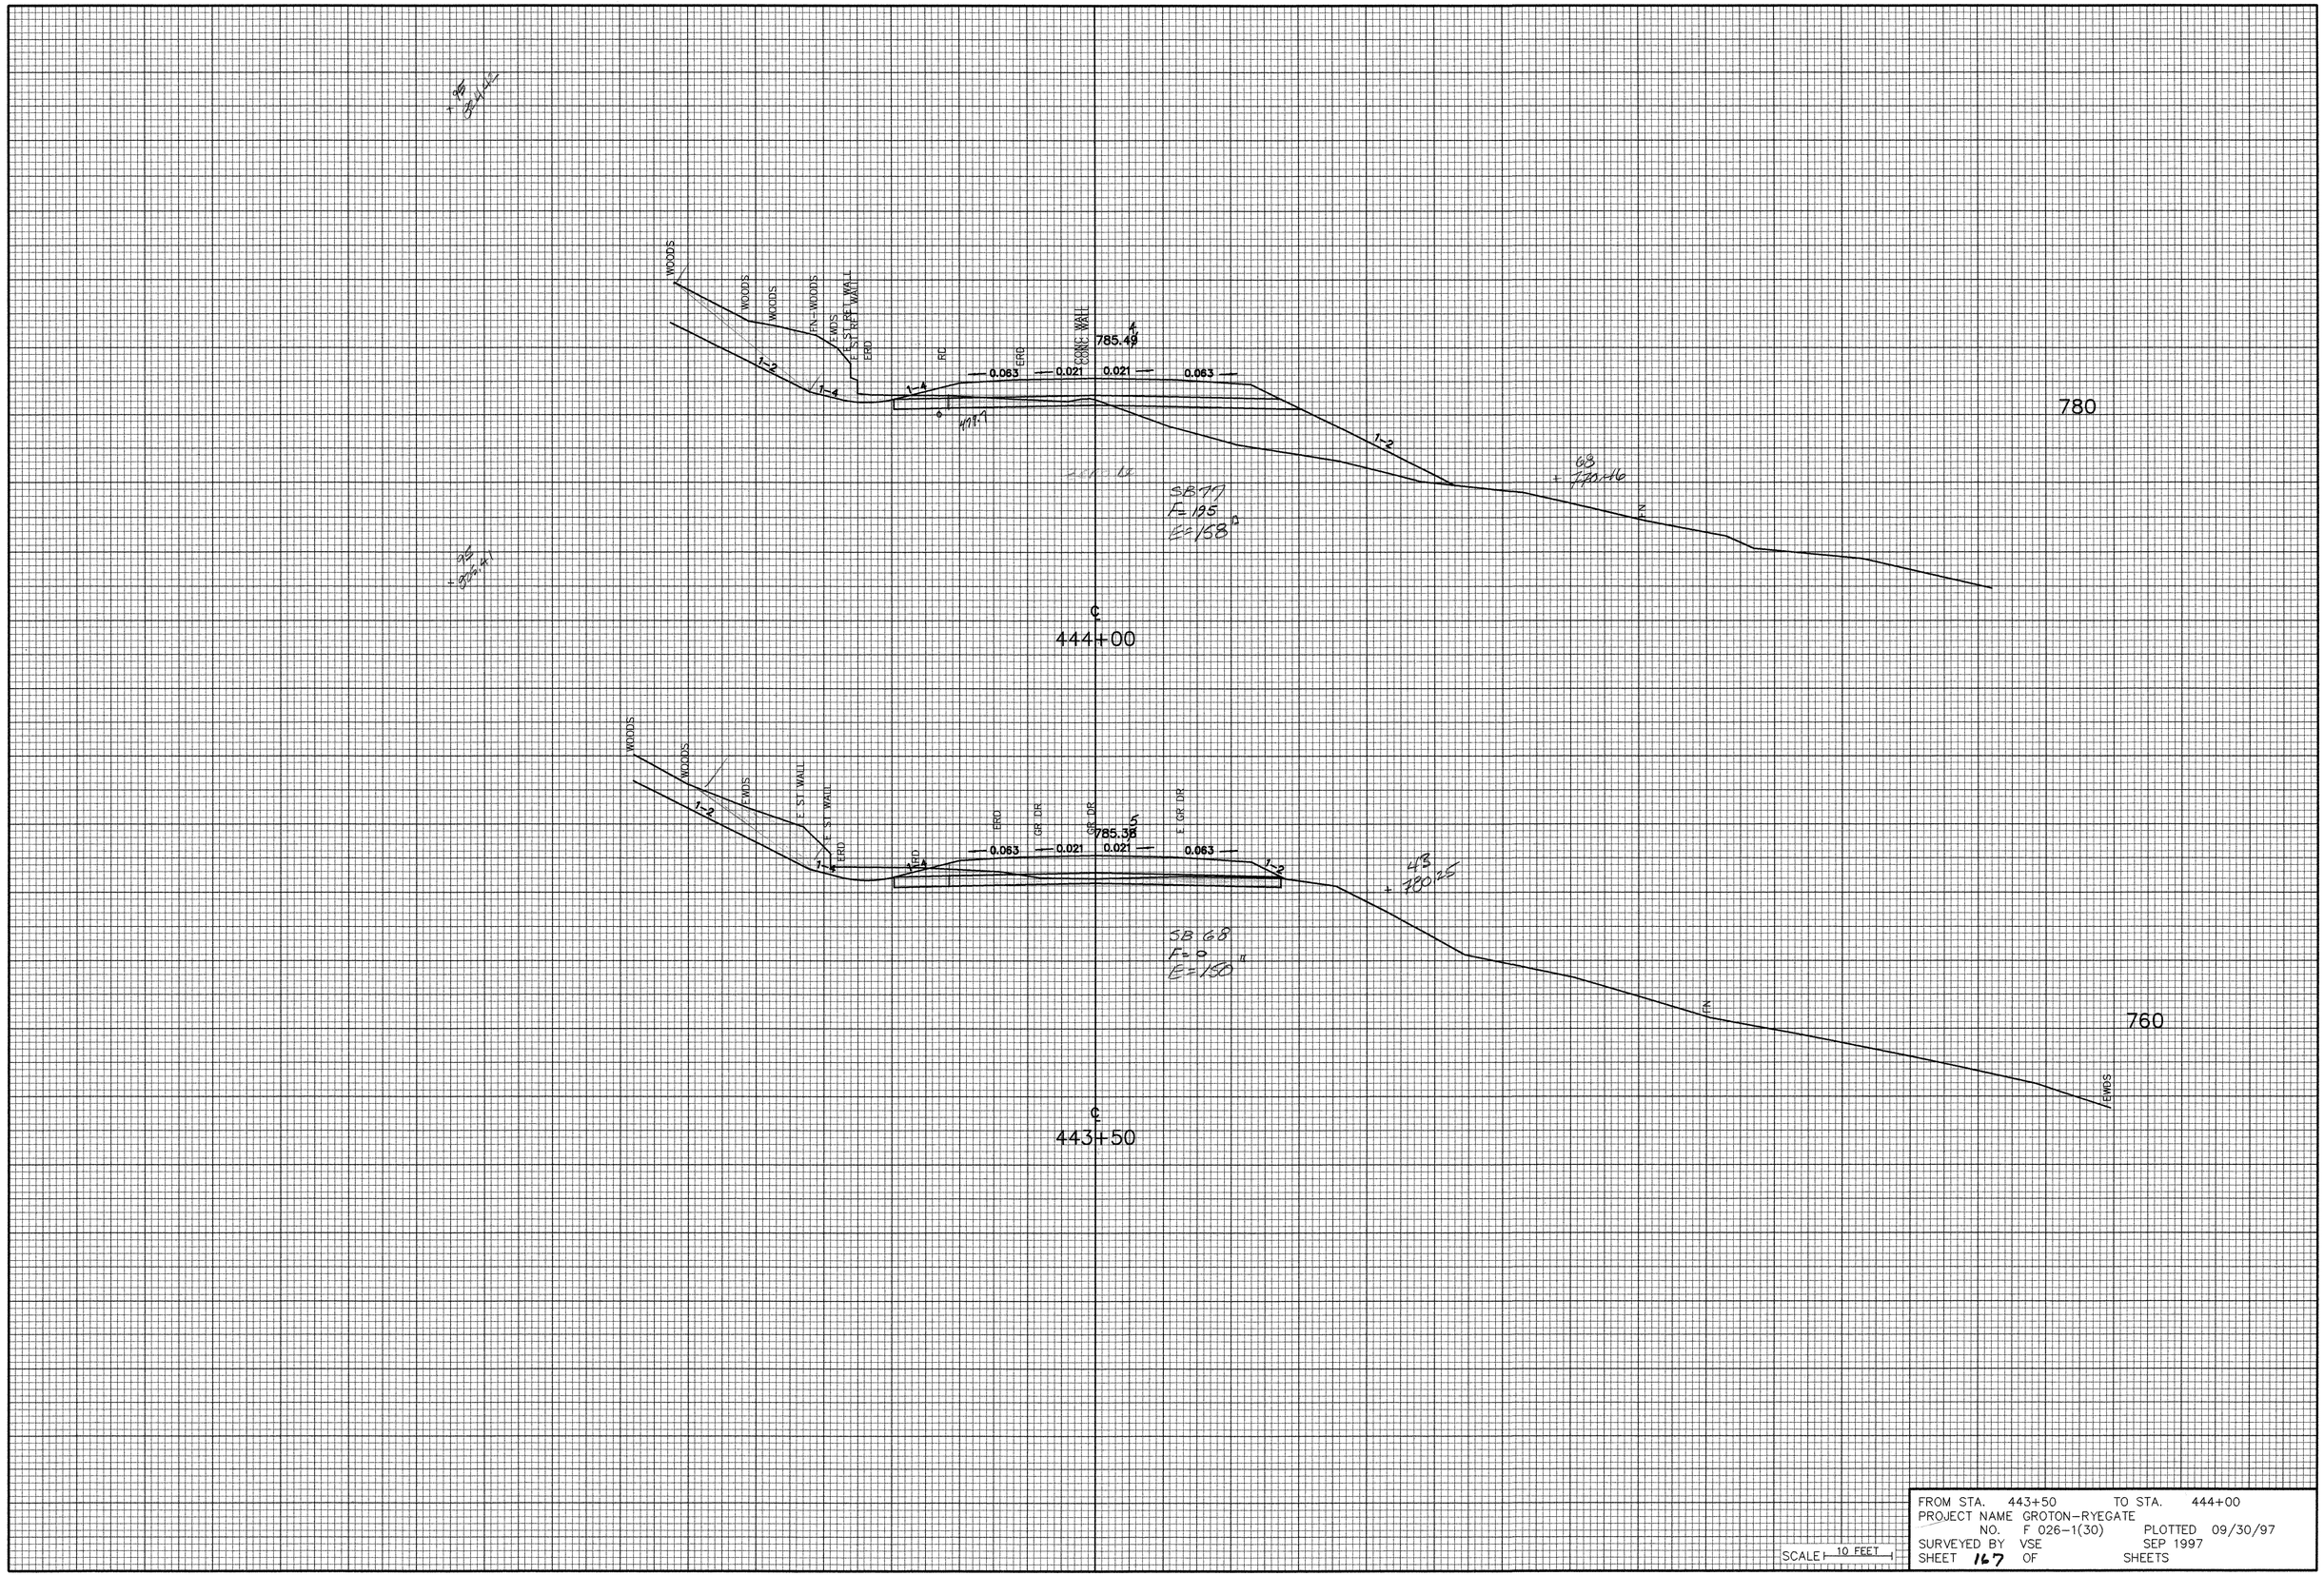

FROM STA. 443+50 TO STA. 444+00
PROJECT NAME GROTON-RYEGATE
NO. F 026-1(30) PLOTTED 09/30/97
SURVEYED BY VSE SEP 1997
SHEET 167 OF SHEETS

SCALE 10 FEET