448+00 6/98 DOT

TE 5° OF	36" x 0.5 x 1.5 x 1/27 =	1.0'
TE 0-5 OF	36" x 5.0 x 1/27 =	6.7'
TE 0-5 PIPE	100 x 3.6 x 1/27 =	13.6'
TE 0-5; SF @ OUTLET	6x12x2x1/27	7.11'
		28.4 SKI 28.4 TOTAL
SF TYPE E @ OUTLET	6x12x2 x 1/27	7.11'
GEOTEX FAB Under S	10 x 18 x 1/9	20 SY

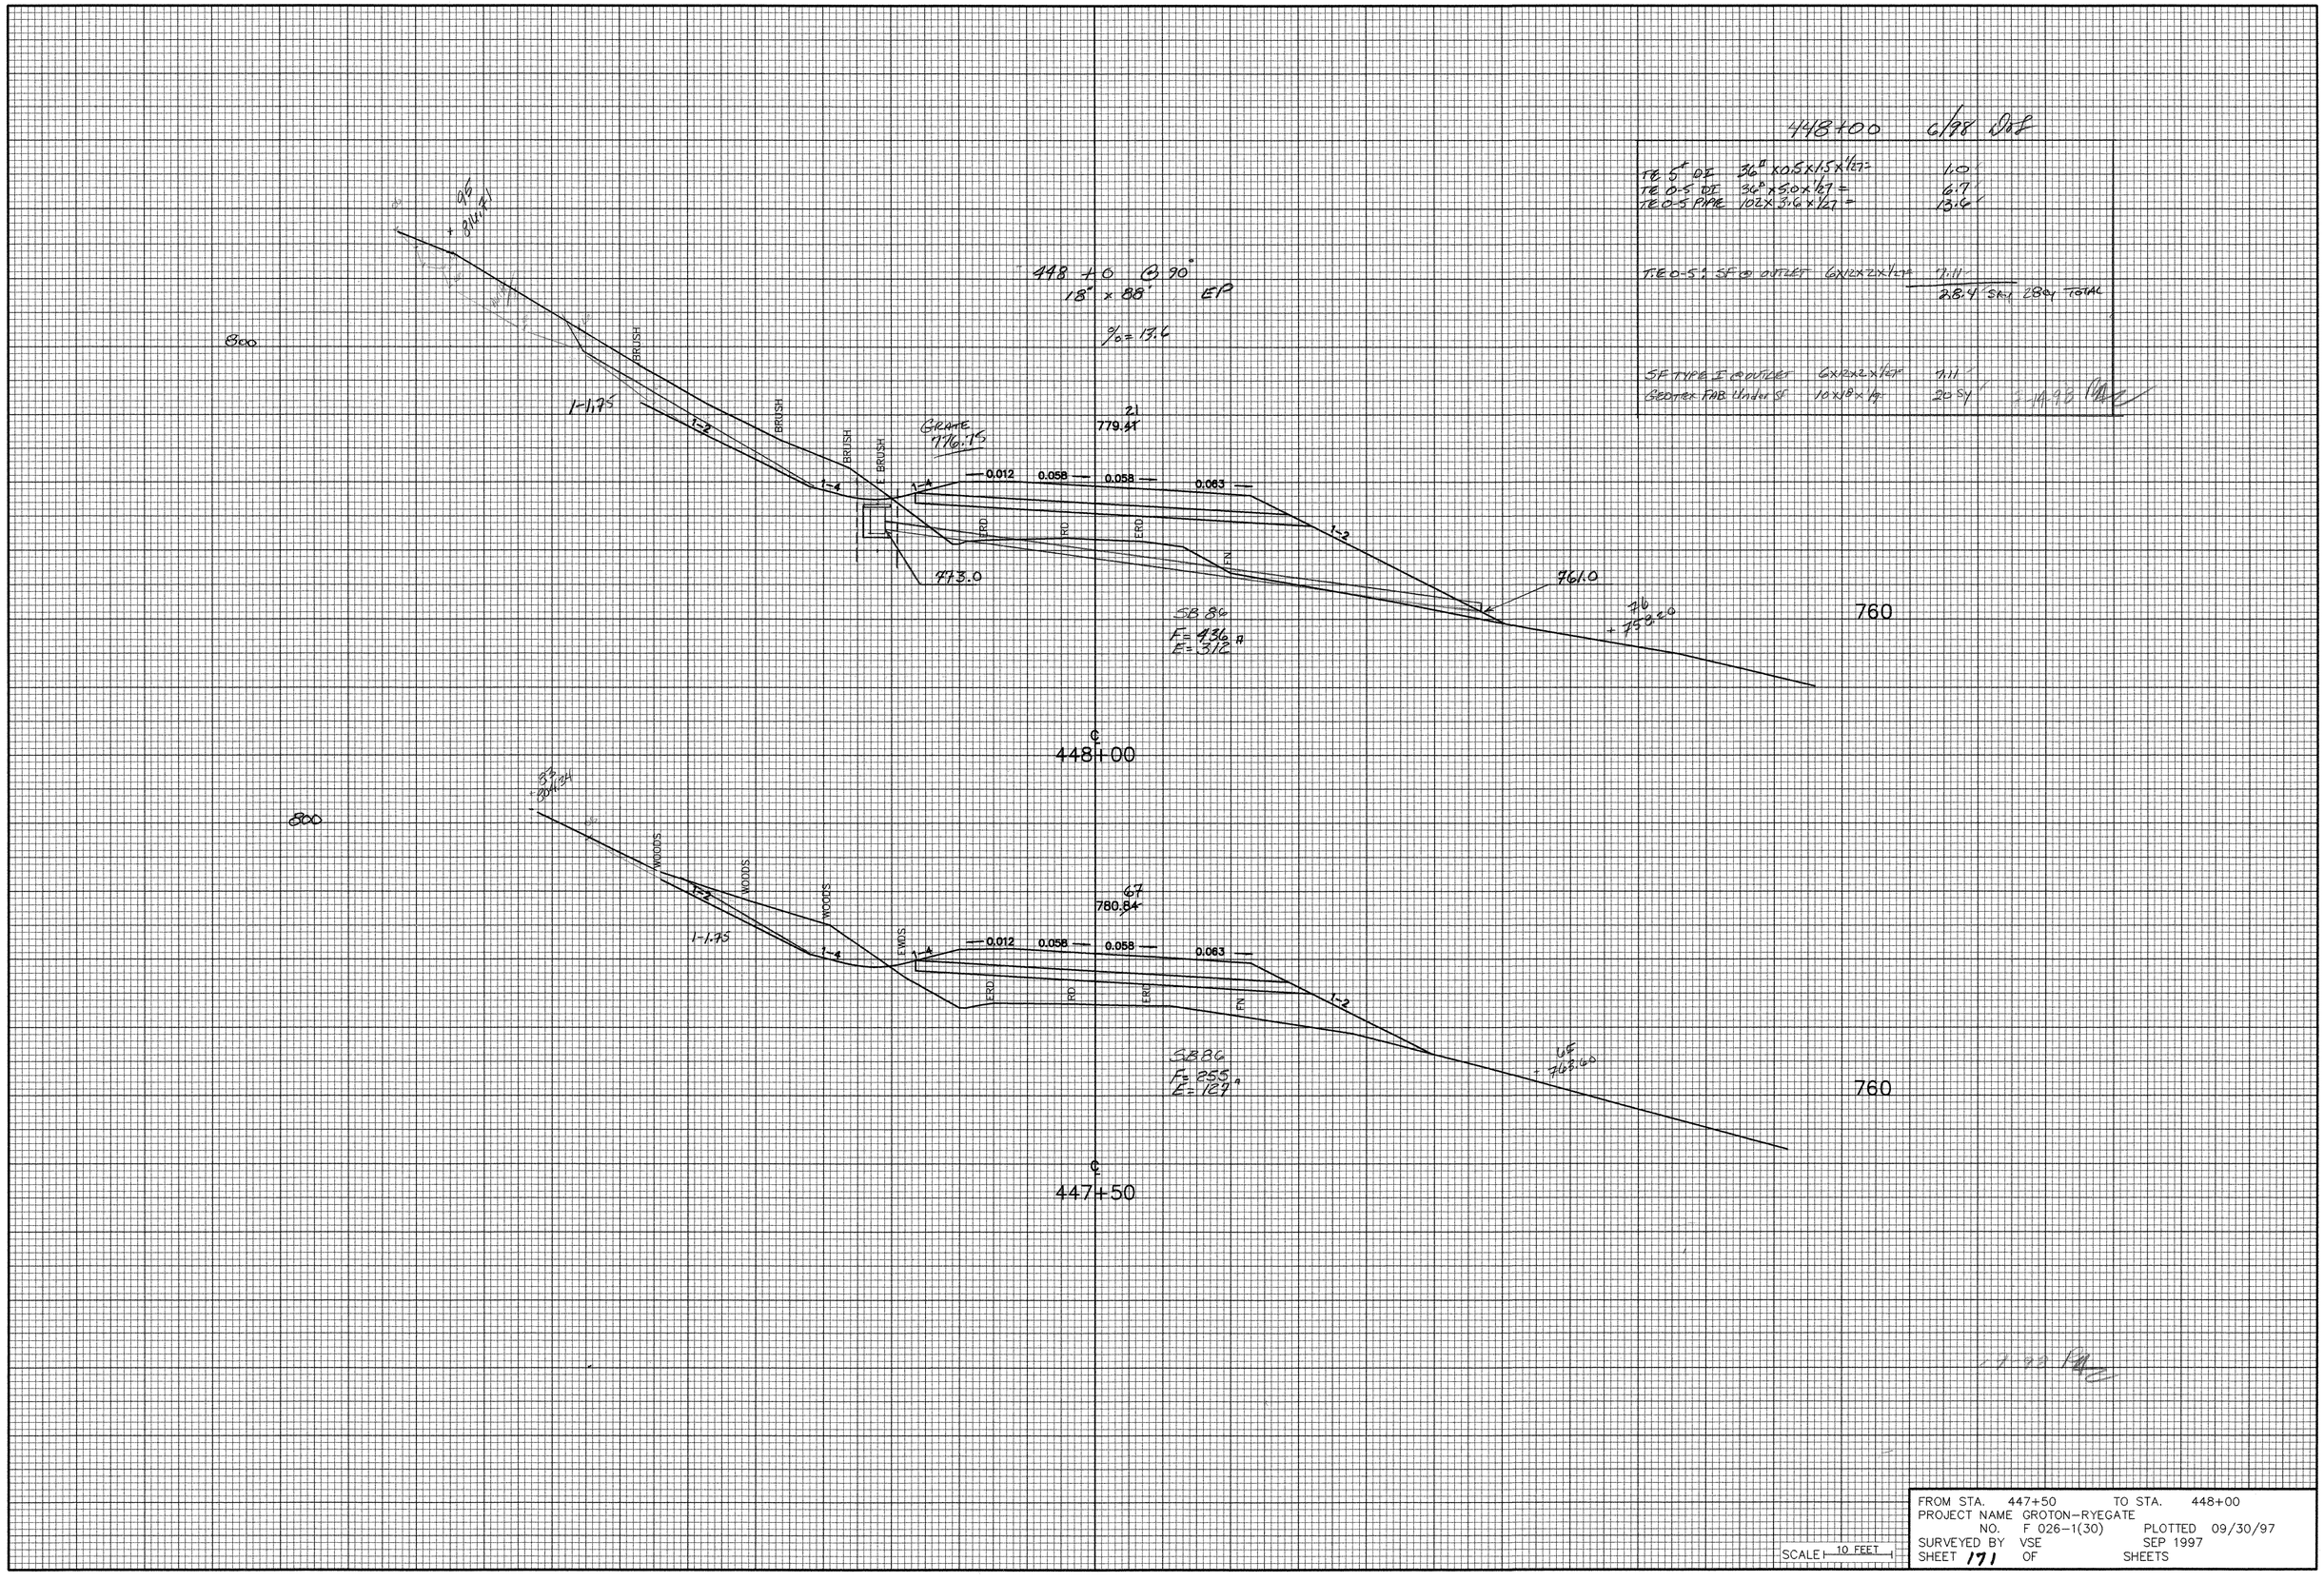

FROM STA. 447+50 TO STA. 448+00
PROJECT NAME GROTON-RYEGATE
NO. F 026-1(30) PLOTTED 09/30/97
SURVEYED BY VSE SEP 1997
SHEET 171 OF SHEETS

SCALE 10 FEET