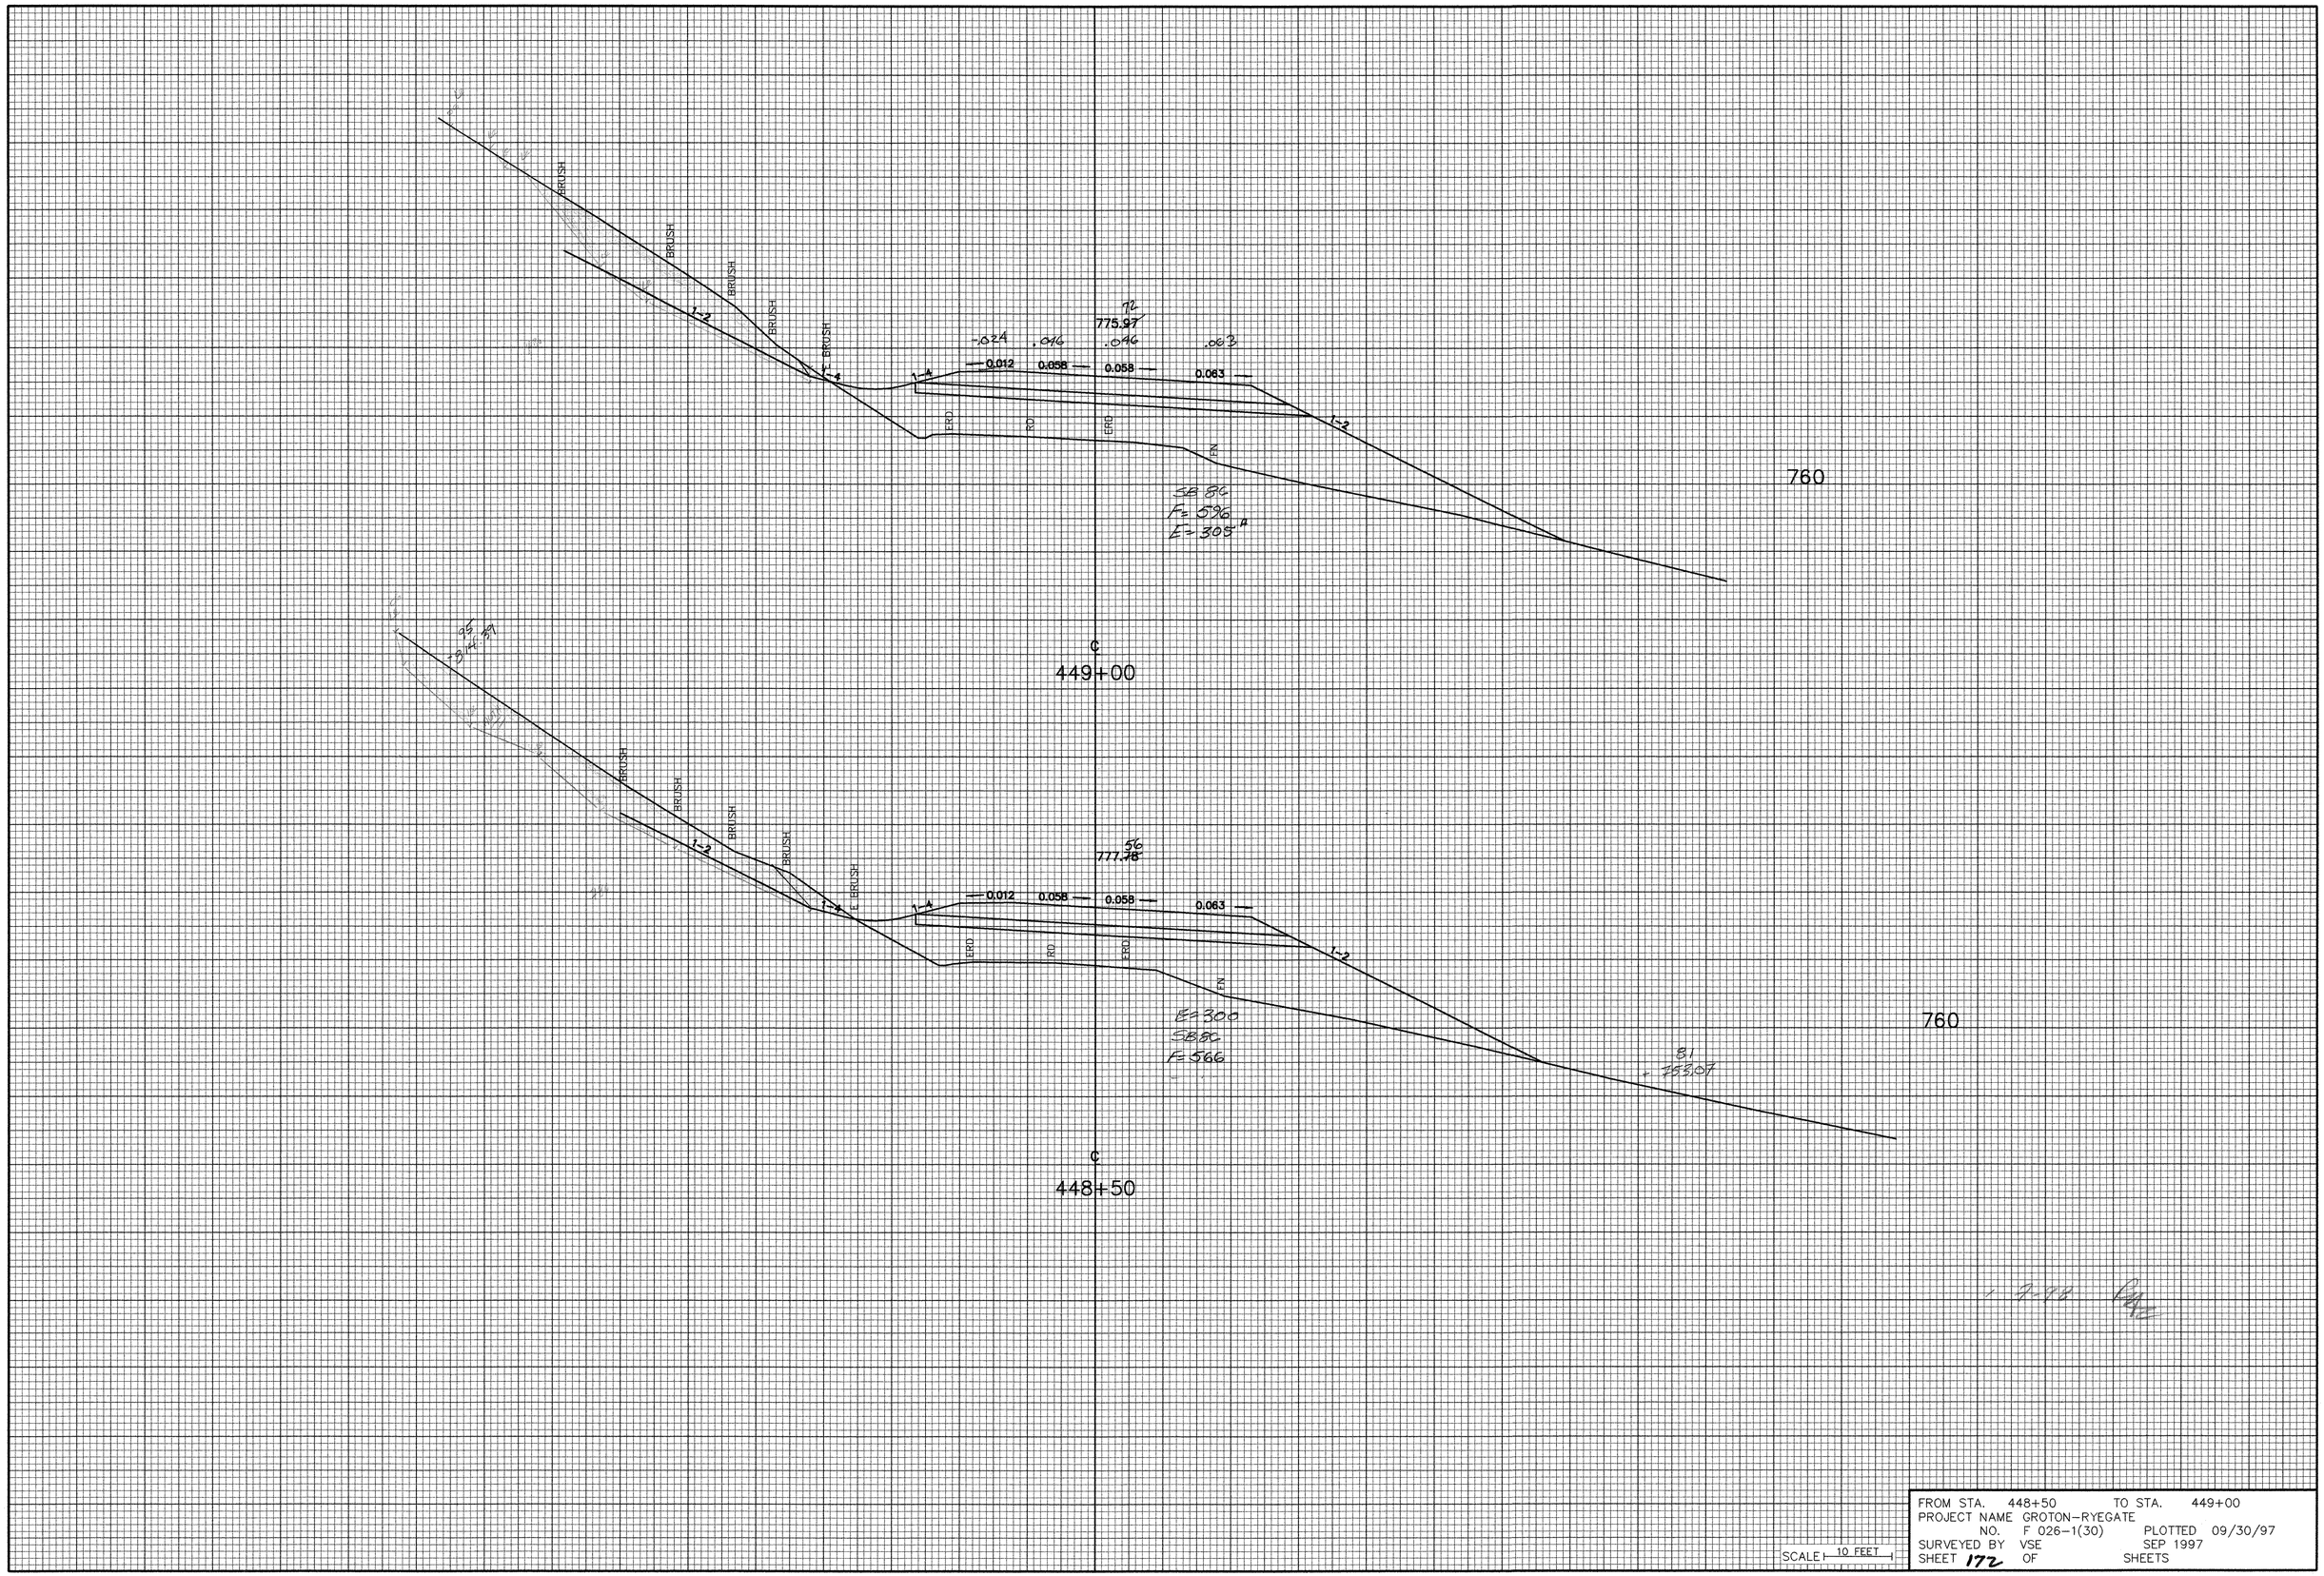

FROM STA. 448+50		TO STA. 449+00	
PROJECT NAME GROTON–RYEGATE			
NO. F 026–1(30)		PLOTTED 09/30/97	
SURVEYED BY VSE		SEP 1997	
SHEET 172	OF	SHEETS	

SCALE 10 FEET