


DATE	
BY	
REVISIONS	
NO.	
DATE	
BY	
REVISIONS	
NO.	
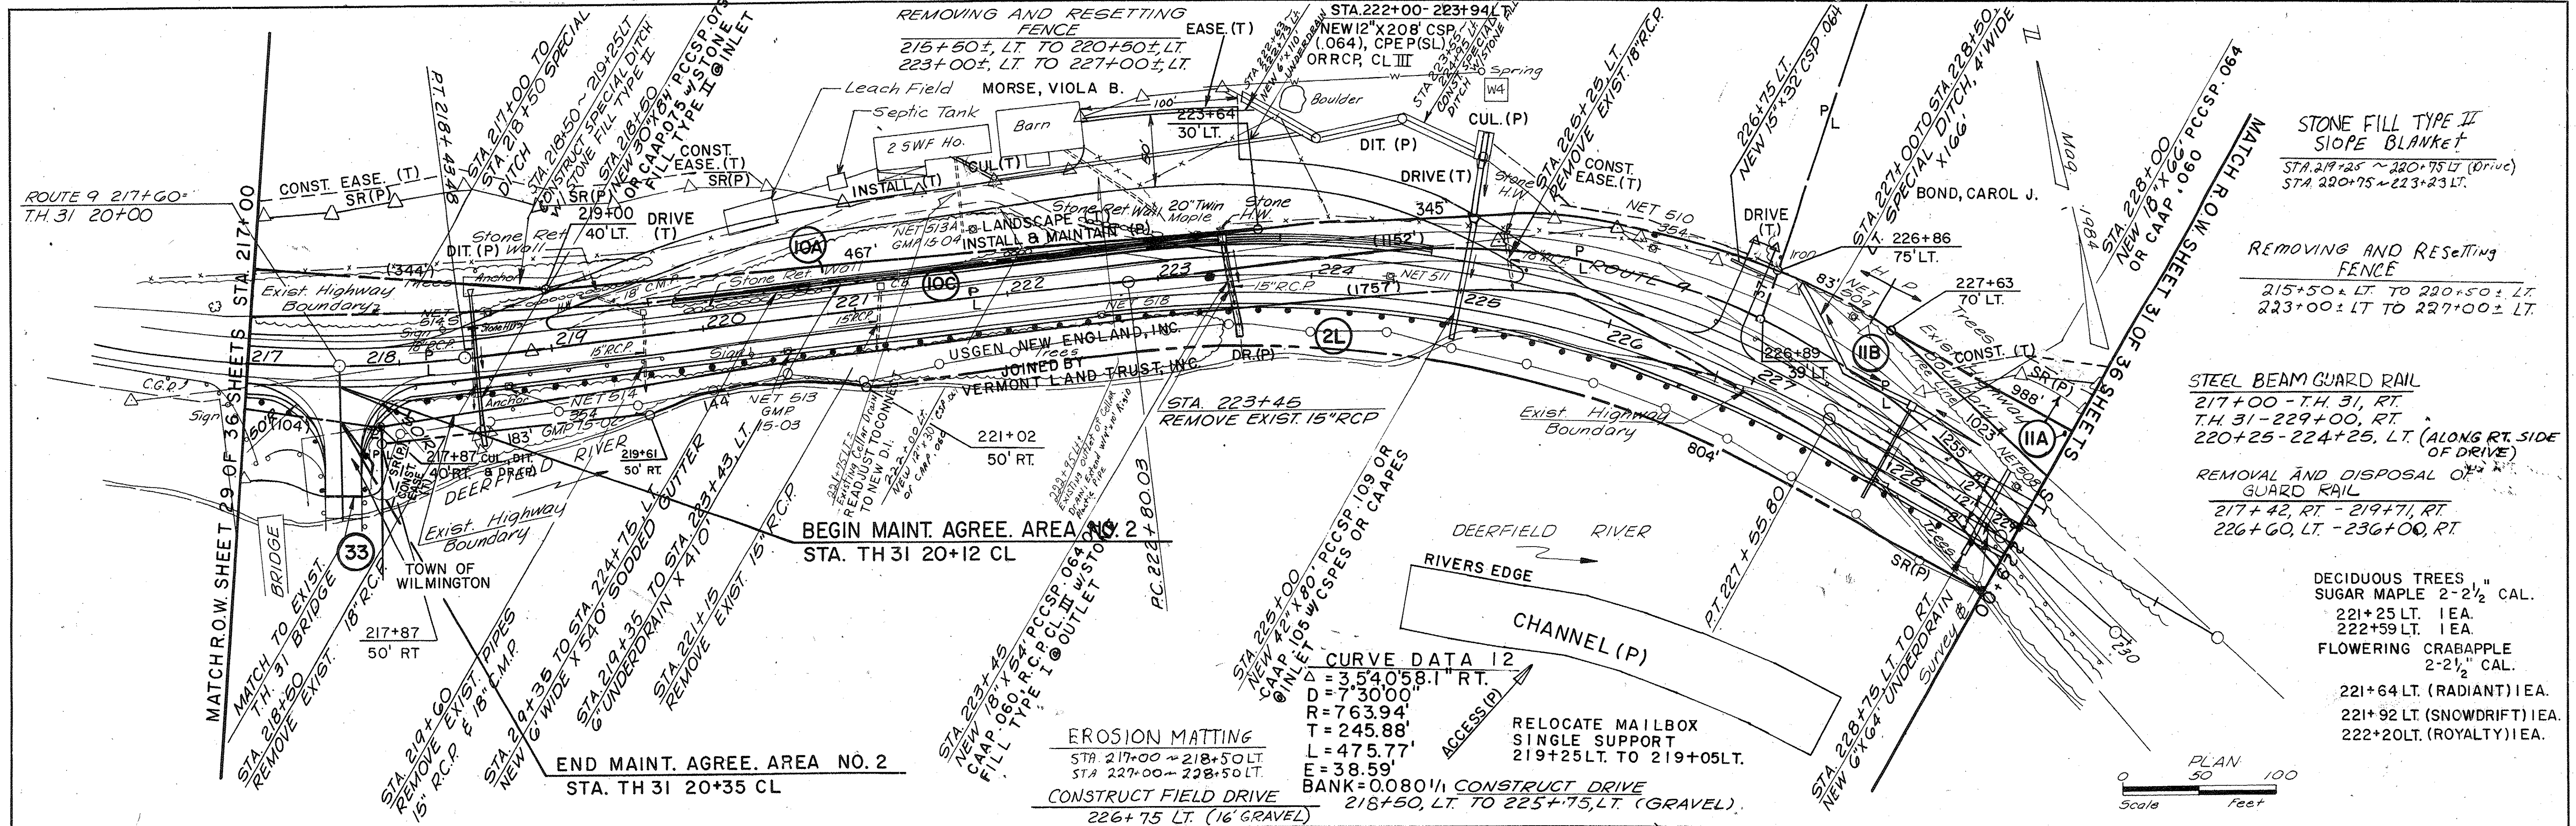

STONE FILL TYPE II
SLOPE BLANKET
STA 219+25 ~ 220+75 LT (DRIVE)
STA 220+75 ~ 223+23 LT.

REMOVING AND RESETTING
FENCE
215+50 ± LT TO 220+50 ± LT
223+00 ± LT TO 227+00 ± LT



STEEL BEAM GUARD RAIL
217+00 - T.H. 31, RT.
T.H. 31 - 229+00, RT.
220+25 - 224+25, LT. (ALONG RT. SIDE
OF DRIVE)

REMOVAL AND DISPOSAL OF
GUARD RAIL
217+42, RT. - 219+71, RT.
226+60, LT. - 236+00, RT.

DECIDUOUS TREES
SUGAR MAPLE 2-2 1/2" CAL.
221+25 LT. IEA
222+59 LT. IEA
FLOWERING CRABAPPLE
2-2 1/2" CAL.
221+64 LT. (RADIANT) IEA
221+92 LT. (SNOWDRIFT) IEA
222+20 LT. (ROYALTY) IEA

CURVE DATA 12
Δ = 354058.1" RT.
D = 73000'
R = 76394'
T = 245.88'
L = 475.77'
E = 38.59'
BANK = 0.080 1/4 CONSTRUCT DRIVE
218+50, LT. TO 225+75, LT. (GRAVEL).

EROSION MATTING
STA 217+00 ~ 218+50 LT
STA 227+00 ~ 228+50 LT
CONSTRUCT FIELD DRIVE
226+75 LT. (16" GRAVEL)

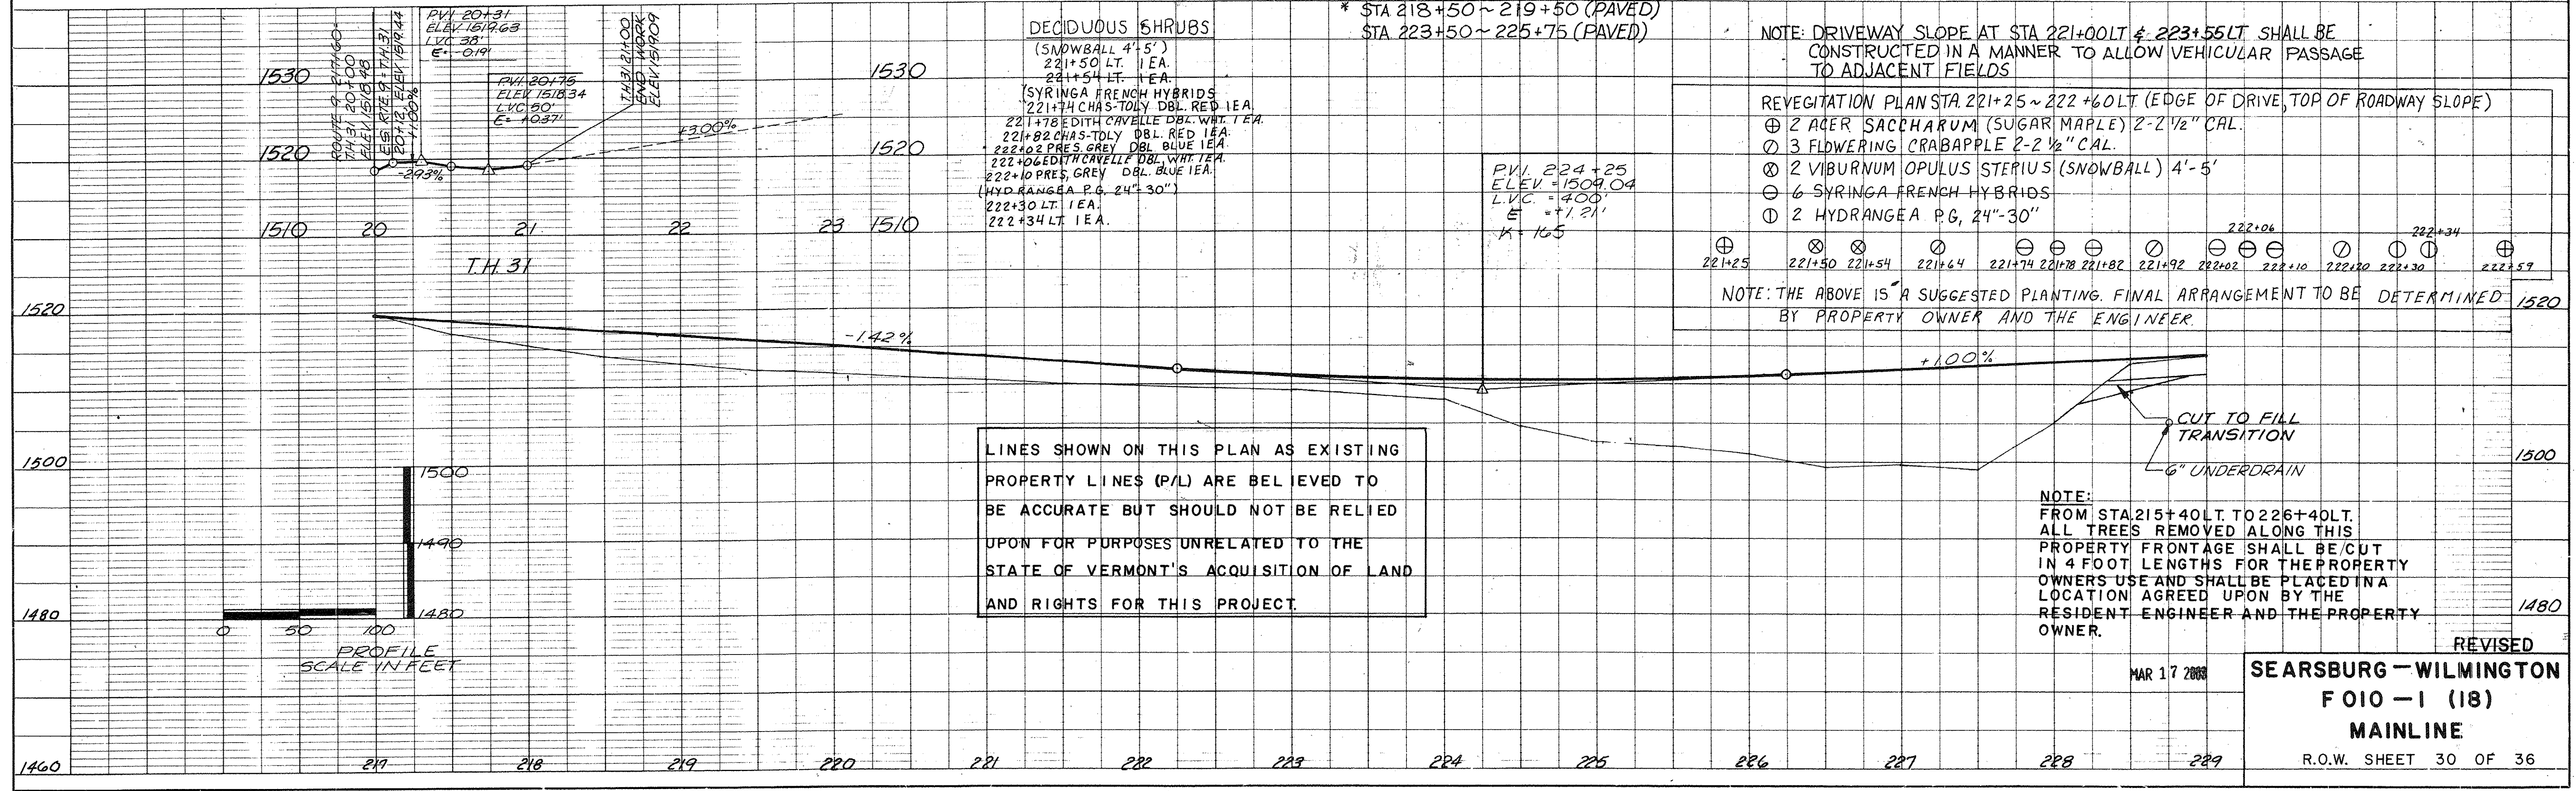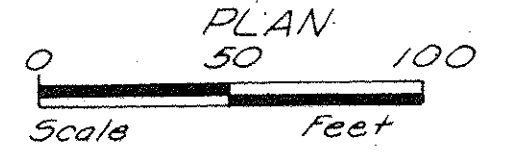

LINES SHOWN ON THIS PLAN AS EXISTING
PROPERTY LINES (P/L) ARE BELIEVED TO
BE ACCURATE BUT SHOULD NOT BE RELIED
UPON FOR PURPOSES UNRELATED TO THE
STATE OF VERMONT'S ACQUISITION OF LAND
AND RIGHTS FOR THIS PROJECT.

NOTE: DRIVEWAY SLOPE AT STA 221+00 LT & 223+55 LT SHALL BE
CONSTRUCTED IN A MANNER TO ALLOW VEHICULAR PASSAGE
TO ADJACENT FIELDS

REVEGETATION PLAN STA 221+25 ~ 222+60 LT (EDGE OF DRIVE, TOP OF ROADWAY SLOPE)

- ⊕ 2 ACER SACCHARUM (SUGAR MAPLE) 2-2 1/2" CAL.
- ⊗ 3 FLOWERING CRABAPPLE 2-2 1/2" CAL.
- ⊙ 2 VIBURNUM OPULUS STERILIS (SNOWBALL) 4'-5'
- ⊖ 6 SYRINGA FRENCH HYBRIDS
- ⊕ 2 HYDRANGEA P.G. 24"-30"

NOTE: THE ABOVE IS A SUGGESTED PLANTING. FINAL ARRANGEMENT TO BE DETERMINED
BY PROPERTY OWNER AND THE ENGINEER.

NOTE:
FROM STA 215+40 LT. TO 226+40 LT.
ALL TREES REMOVED ALONG THIS
PROPERTY FRONTAGE SHALL BE CUT
IN 4 FOOT LENGTHS FOR THE PROPERTY
OWNERS USE AND SHALL BE PLACED IN A
LOCATION AGREED UPON BY THE
RESIDENT ENGINEER AND THE PROPERTY
OWNER.

MAR 17 2008

REVISED
SEARSBURG - WILMINGTON
FOIO - 1 (18)
MAINLINE
R.O.W. SHEET 30 OF 36