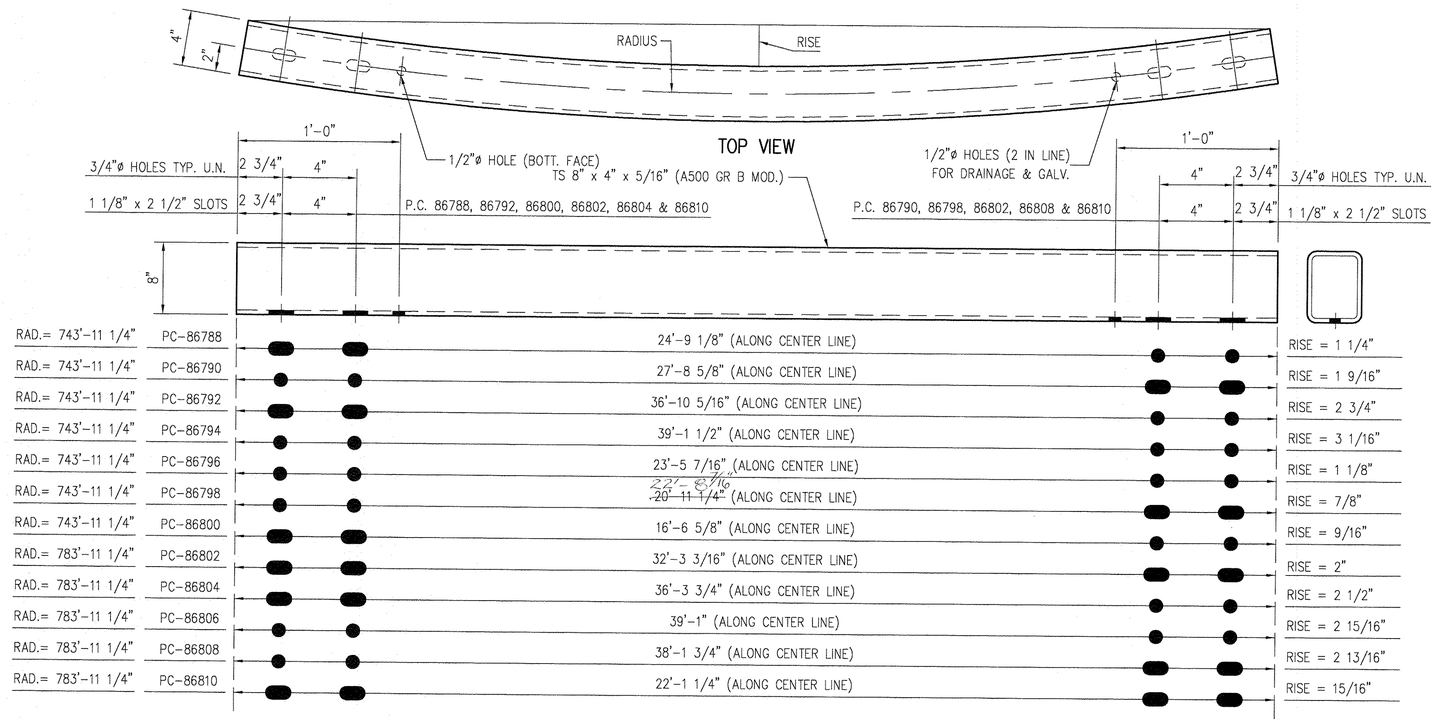

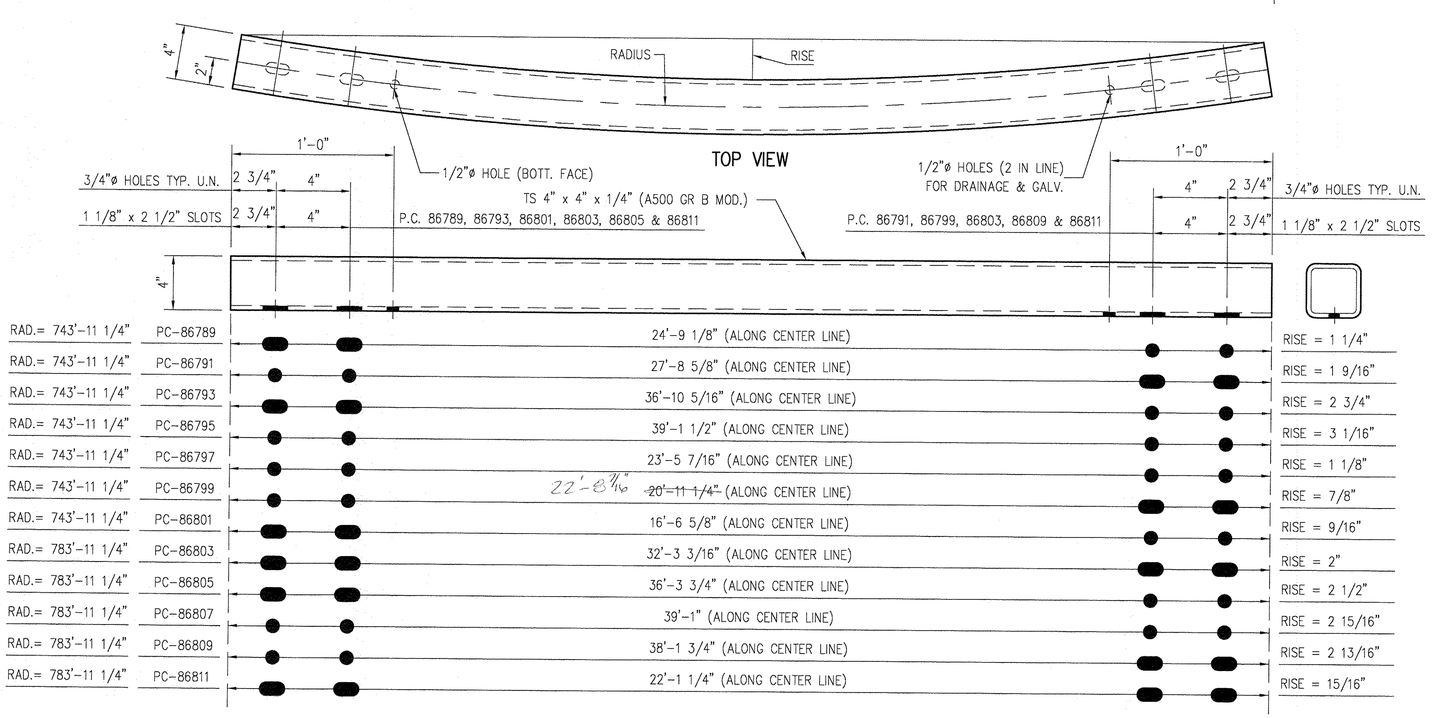

BILL OF MATERIAL

PRODUCT CODE	BRIDGE 25B	DESCRIPTION	WT. EA.	REMARKS
86788G	1	TS 8" x 4" x 5/16" x 24'-9 1/8"	611 #	
86790G	1	TS 8" x 4" x 5/16" x 27'-8 5/8"	684 #	
86792G	1	TS 8" x 4" x 5/16" x 36'-10 5/16"	910 #	
86794G	5	TS 8" x 4" x 5/16" x 39'-1 1/2"	966 #	
86796G	1	TS 8" x 4" x 5/16" x 23'-5 7/16"	579 #	
86798G	1	TS 8" x 4" x 5/16" x ~~20'-11 1/4"~~ 22'-8 11/16"	517 #	
86800G	1	TS 8" x 4" x 5/16" x 16'-6 5/8"	409 #	
86802G	1	TS 8" x 4" x 5/16" x 32'-3 3/16"	803 #	
86804G	1	TS 8" x 4" x 5/16" x 36'-3 3/4"	896 #	
86806G	5	TS 8" x 4" x 5/16" x 39'-1"	965 #	
86808G	1	TS 8" x 4" x 5/16" x 38'-1 3/4"	942 #	
86810G	1	TS 8" x 4" x 5/16" x 22'-1 1/4"	546 #	
86789G	1	TS 4" x 4" x 1/4" x 24'-9 1/8"	319 #	
86791G	1	TS 4" x 4" x 1/4" x 27'-8 5/8"	358 #	
86793G	1	TS 4" x 4" x 1/4" x 36'-10 5/16"	504 #	
86795G	5	TS 4" x 4" x 1/4" x 39'-1 1/2"	505 #	
86797G	1	TS 4" x 4" x 1/4" x 23'-5 7/16"	303 #	
86799G	1	TS 4" x 4" x 1/4" x ~~20'-11 1/4"~~ 22'-8 11/16"	270 #	
86801G	1	TS 4" x 4" x 1/4" x 16'-6 5/8"	214 #	
86803G	1	TS 4" x 4" x 1/4" x 32'-3 3/16"	416 #	
86805G	1	TS 4" x 4" x 1/4" x 36'-3 3/4"	468 #	
86807G	5	TS 4" x 4" x 1/4" x 39'-1"	504 #	
86809G	1	TS 4" x 4" x 1/4" x 38'-1 3/4"	492 #	
86811 G	1	TS 4" x 4" x 1/4" x 22'-1 1/4"	285 #	

GIRARD ENGINEERING DEPT.
ISSUED
JAN 15 2003
TRINITY INDUSTRIES, INC
1170 N. STATE STREET
GIRARD, OHIO 44420

APPROVAL DRAWING

NOTES:

1. FOR GENERAL NOTES REFER TO SHEET D1 OF 4
2. FOR ERECTION DETAILS SEE SHEET E1 OF 4 (22) 1006227
3. FOR RAILING LAYOUT SEE SHEET E4 OF 4 (22) 1006227
4. DETAIL DIMENSION SHOWN ARE ALONG CENTER LINE OF RAIL.

VAOT
RECEIVED
CK'D BY RLW OK'D BY
JAN 29 2003
RESUBMIT APPROVED As Noted
BY RLW DATE 1-30-03

REV.	CHK'D	BY	DATE	REMARKS

PAY ITEM NUMBER 525.33 BR. RAIL 2 BAR NETC

STATE OF VERMONT AGENCY OF TRANSPORTATION
VT. ROUTE 9 – TOWNS OF SEARSBURGH & WILMINGTON
COUNTIES OF BENNINGTON & WINDHAM
STATE PROJECT NO. NHF 010-1(18) BRIDGE No. 25B

CUSTOMER NORTHLAND SPECIALITES P.O. No. VERBAL

TRINITY INDUSTRIES, INC.
HIGHWAY SAFETY PRODUCTS
2525 STEMMONS FREEWAY, DALLAS, TX 75207

DRAWN	SAR
CHECKED	S.H.
SCALE:	N.T.S.
DATE	11/14/02
ENG. FILE #	22-1006227-D4
SHT.No.	D4 OF 4
TRINITY SALES ORDER NO.	(22) 1006227
REV.	0

This drawing and the information shown thereon is the sole property of TRINITY INDUSTRIES, INC. Neither the drawing nor such information is to be used for any purpose other than that for which it was specifically furnished by TRINITY INDUSTRIES, INC., nor is any reproduction authorized without written permission.

F:\RA\Share\Engineering\WIP\VT1006227\22-1006227-D4.dwg 1/14/03 16:39:04