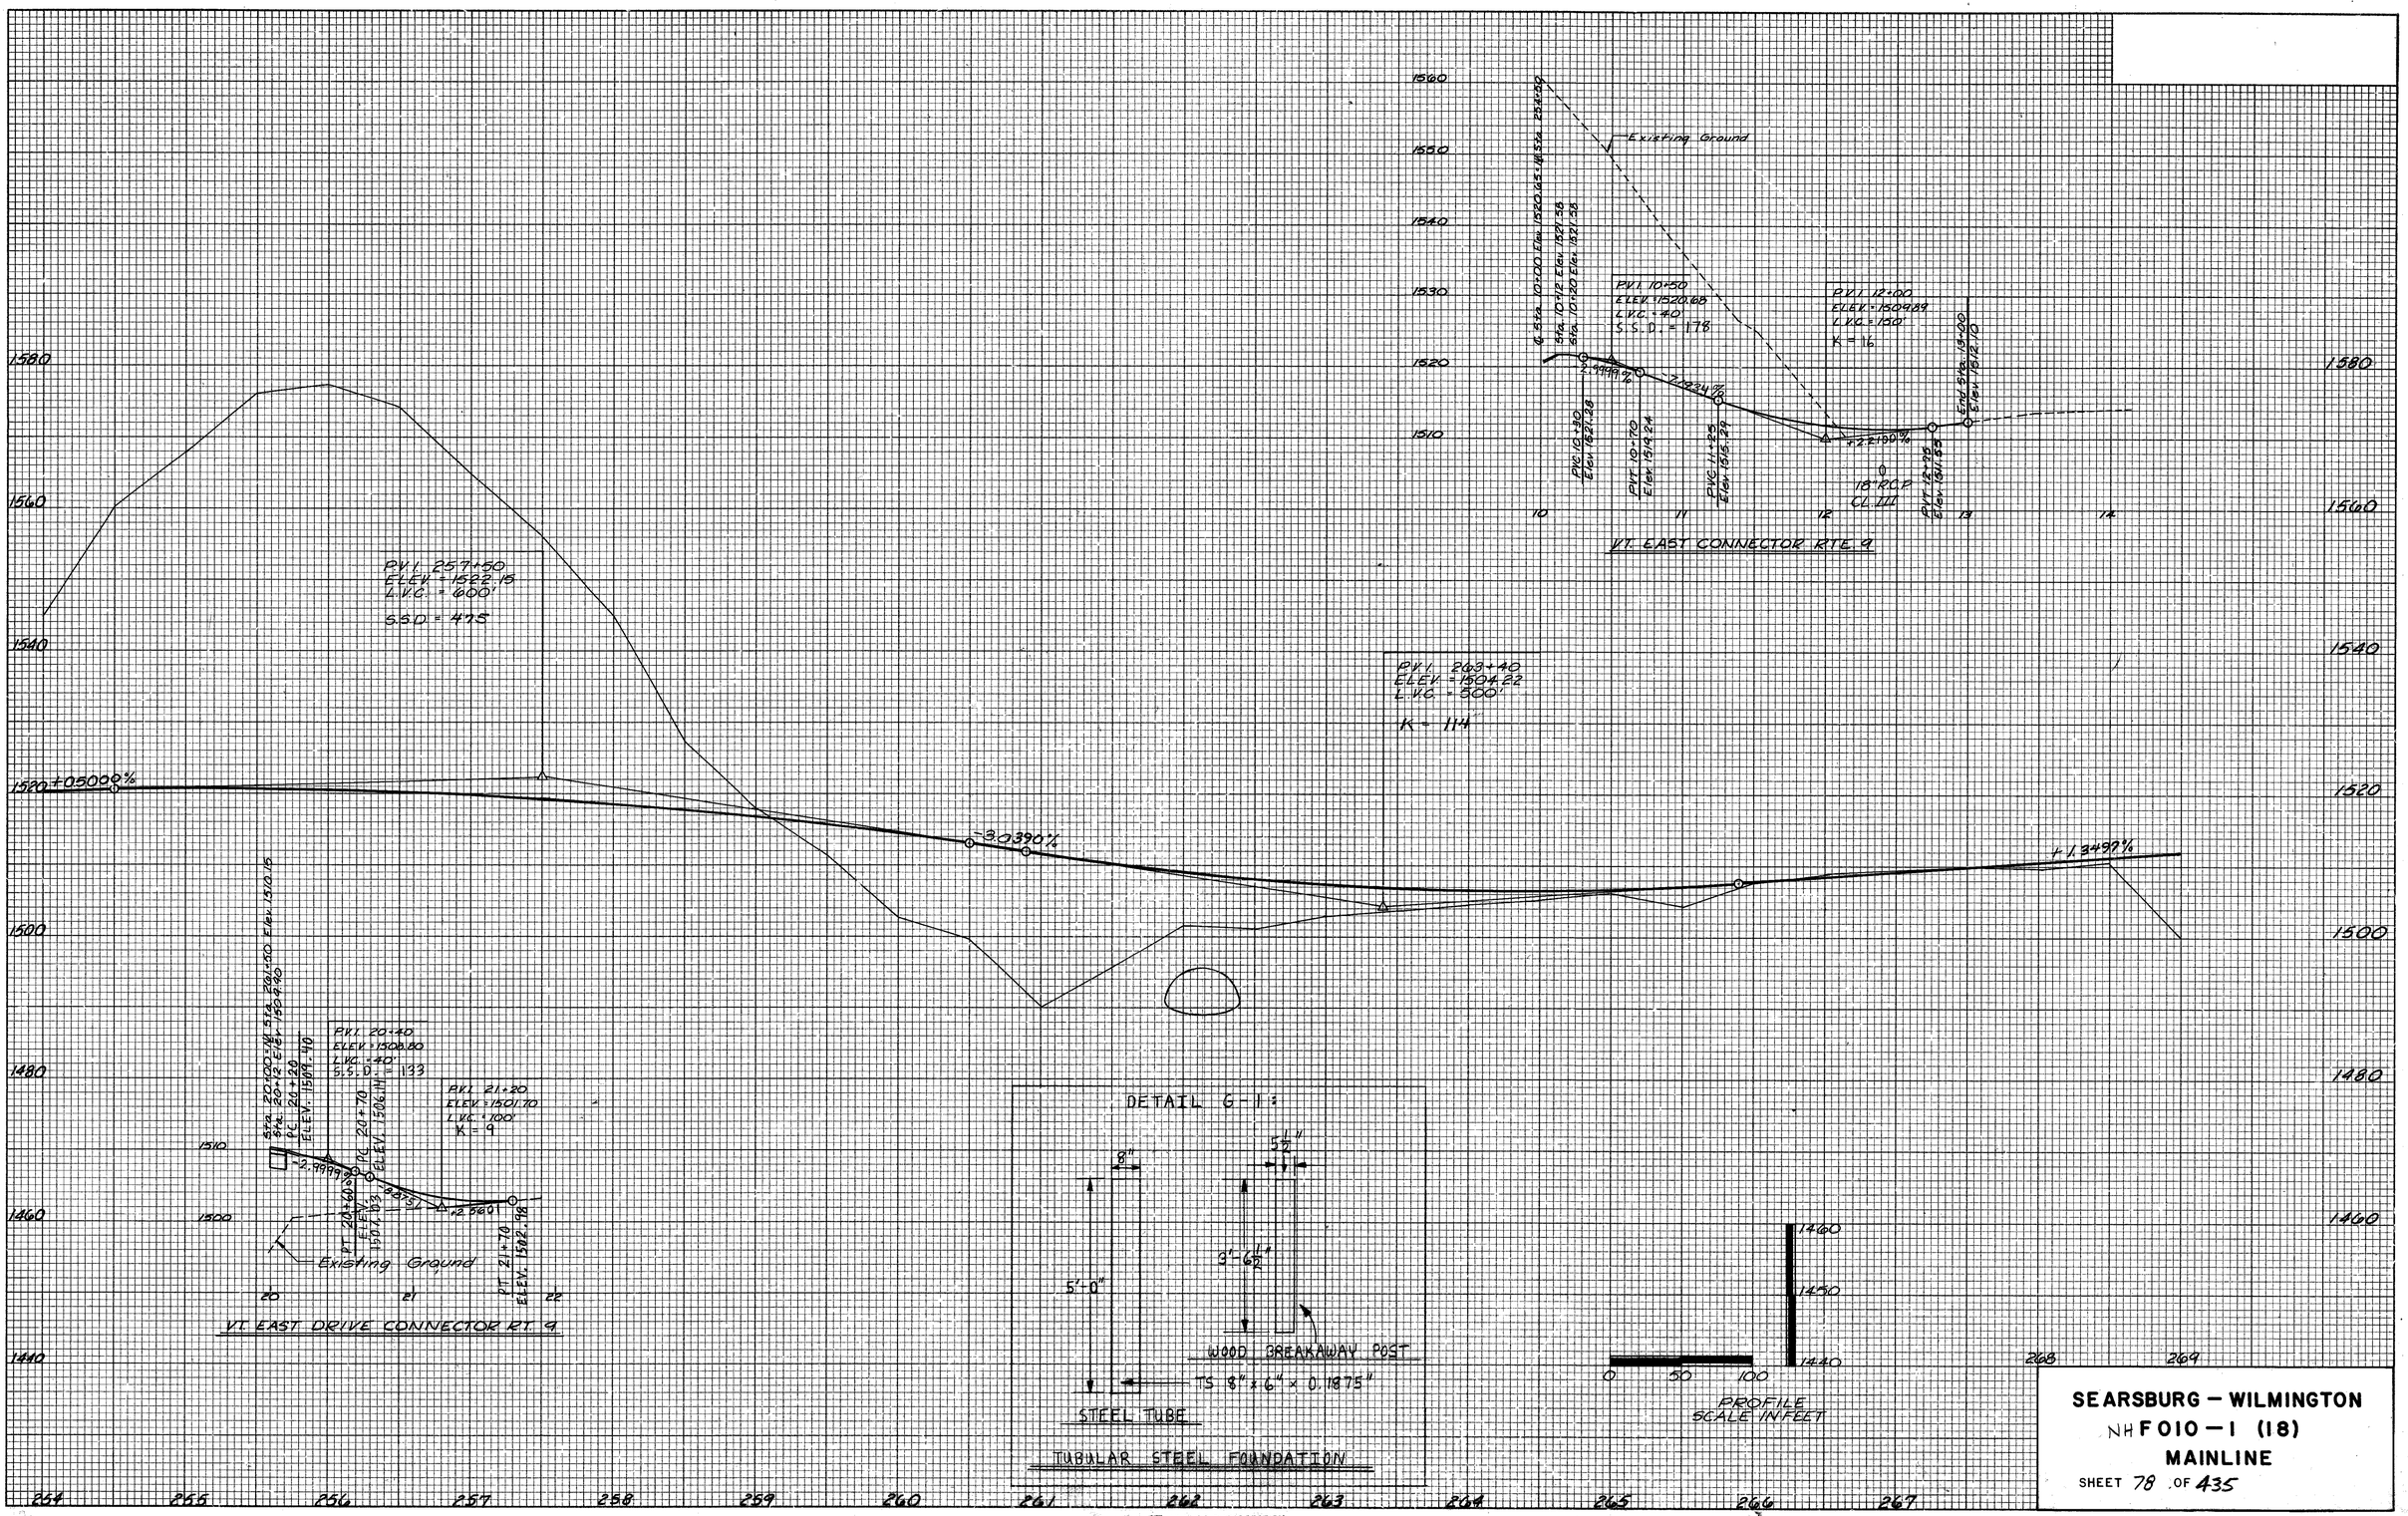

FINAL SURVEY — SURVEYED, PLOTTED, TEMPLATE, AREAS, AREAS CHECKED — NOTE BOOK — NO. — BY — DATE

ORIGINAL SURVEY — SURVEYED, PLOTTED, TEMPLATE, AREAS, AREAS CHECKED — NOTE BOOK — NO. — BY — DATE

SEARSBURG – WILMINGTON

NH F 010 – 1 (18)

MAINLINE

SHEET 78 OF 435

K+E PLATE 3, CROSS SECTION KEUFFEL & ESSER CO.

·18 7072 MADE IN U.S.A.·