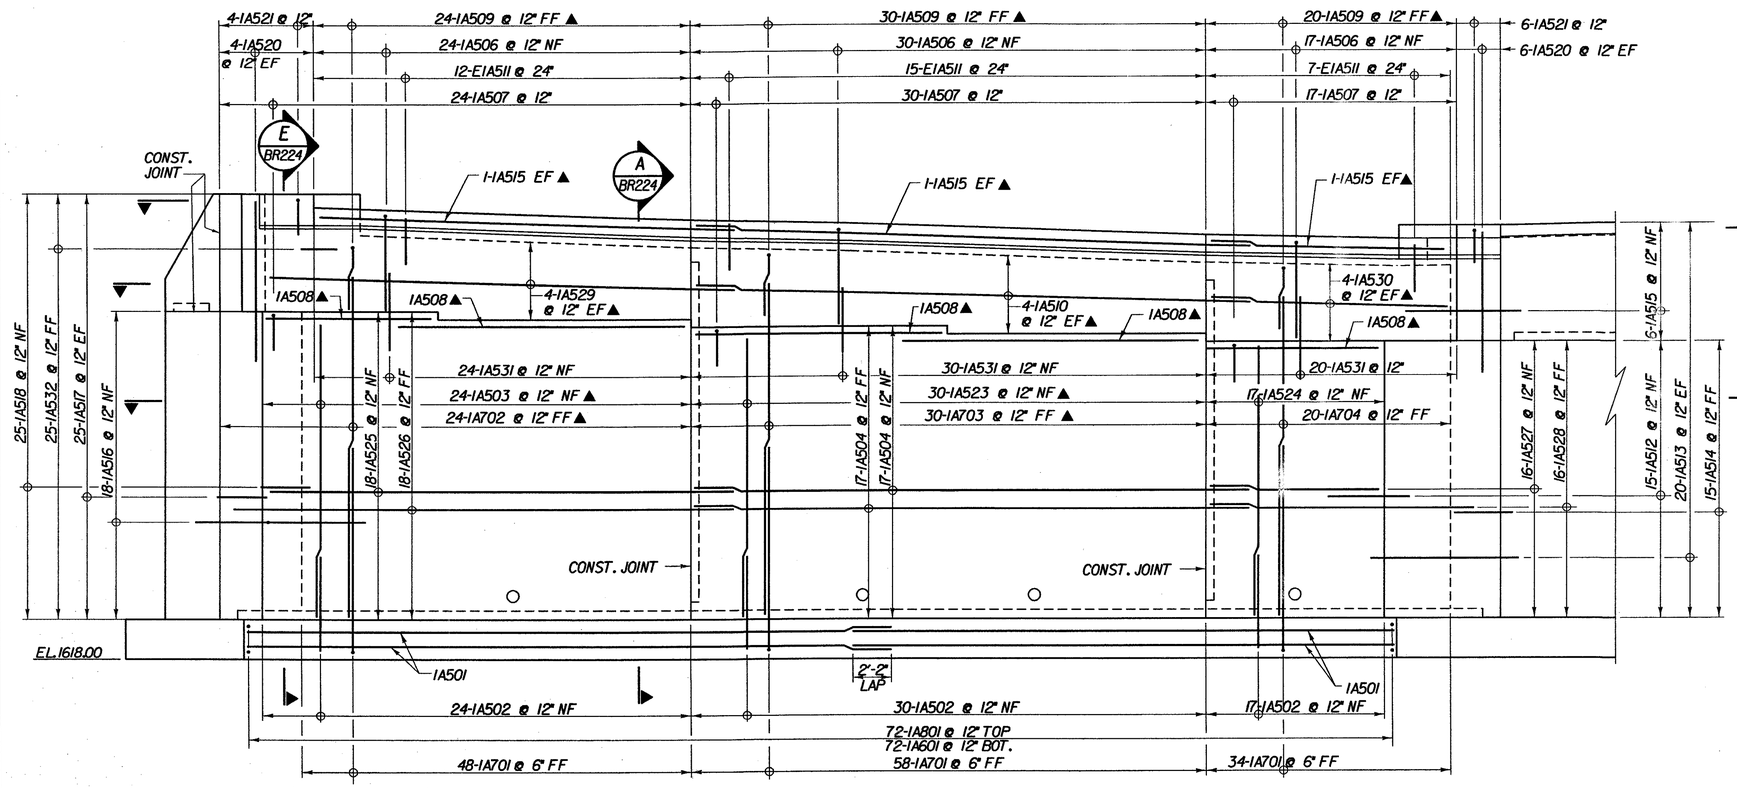

ABUTMENT I REINFORCING ELEVATION - BR 25

SCALE 1/4" = 1'-0

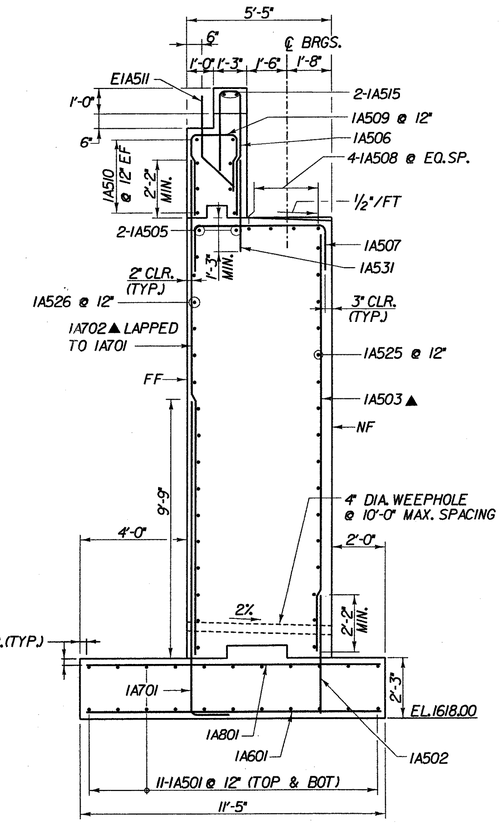

A BR224 ABUTMENT I SECTION - BR 25

SCALE 3/8" = 1'-0

KEY:

NF = NEAR FACE
FF = FAR FACE
EF = EACH FACE
▲ = CUT TO FIT IN FIELD
3" CLR. UNLESS OTHERWISE SPECIFIED ON THE PLANS.

CLOUGH, HARBOUR & ASSOCIATES LLP
ENGINEERS, SURVEYORS, PLANNERS & LANDSCAPE ARCHITECTS
11 WINNERS CIRCLE ALBANY, NEW YORK, 12205

STATE OF VERMONT
AGENCY OF TRANSPORTATION

Town Of SEARSBURG		Bridge No. 25
Highway No. VT. RTE. 9		Log Sta. / Surv. Sta.
VT. RTE. 9 OVER DEERFIELD RIVER		
ABUTMENT I REINFOFRCING ELEVATION - BR 25		
Designed By D. VIENI		Drawn by K. DETRICK/Wm WEATHERBY
Checked By M. OLSTAD	Date 12/2001	Bridge Design Supervisor M. OLSTAD Date 12/2001
PROJECT SEARSBURG - WILMINGTON		PROJECT NO. NHF 010-1(18)
L.G.C. Info.		
Bridge Sheet No. BR224		Sheet 150 OF 435

FILE NAME =u:\3735\mstr\15\BR0025\25.ableler rf.plt
DATE/TIME =12/14/2001
USER =664