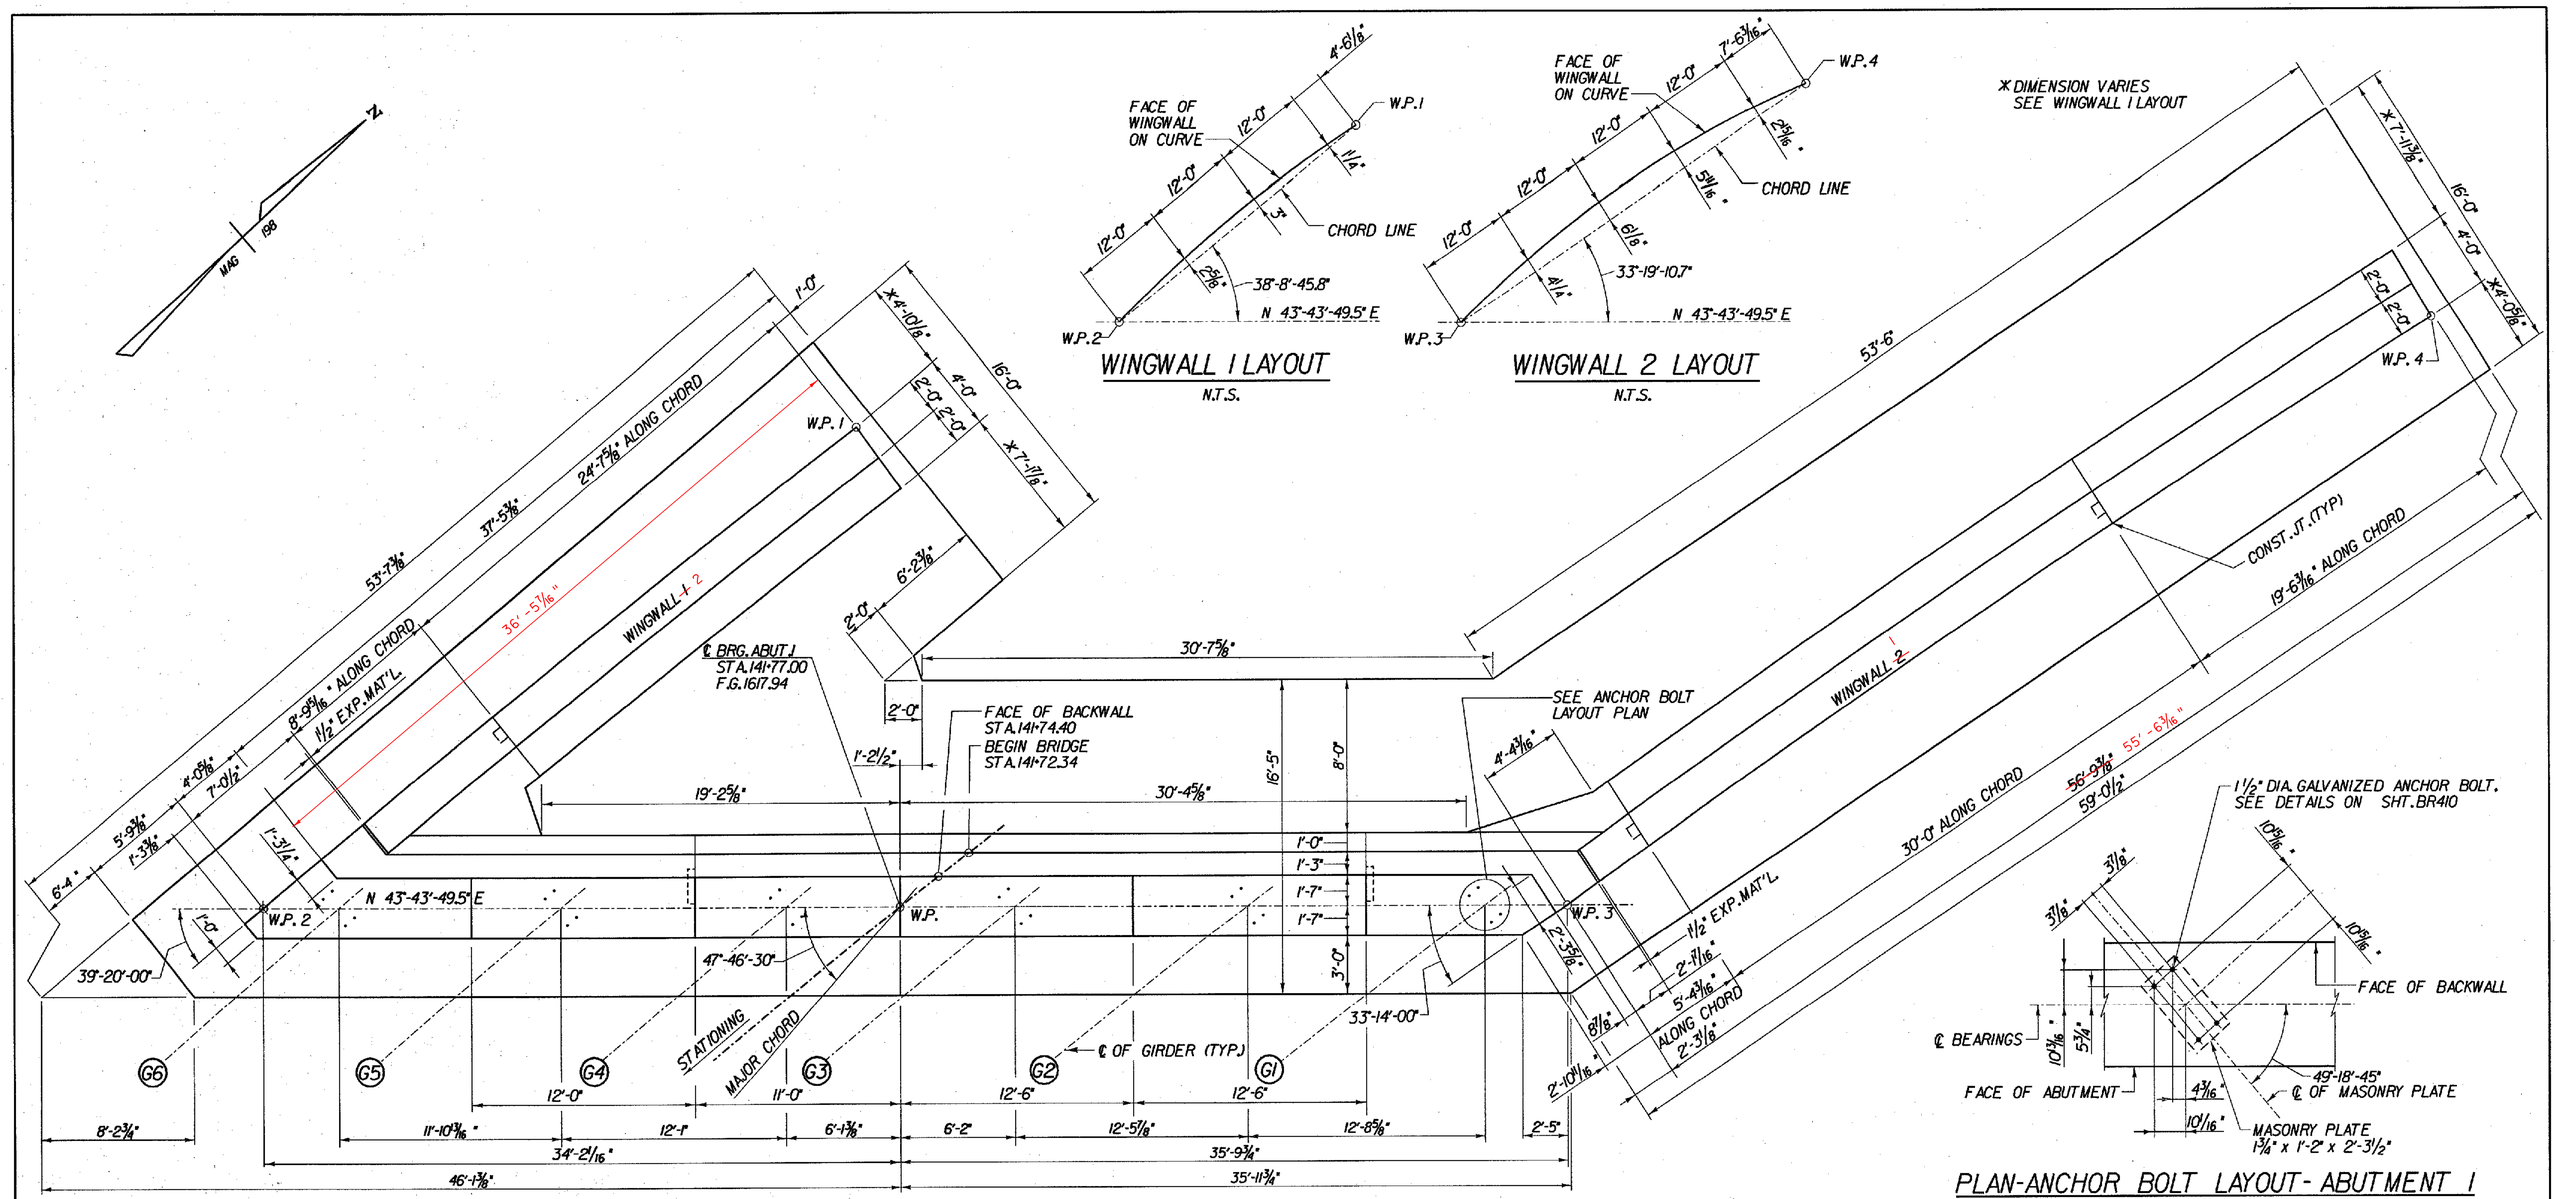

NOTES:

1. PEDESTAL REINFORCEMENT IS NOT SHOWN. FOR BRIDGE SEAT DETAILS, SEE SHEET BR416 & BR418.
2. SEE SHEET BR416 AND BR419 FOR CORNER AND FILLET REINFORCEMENT DETAILS.
3. FOR APROACH SLAB DETAILS, SEE SHEET BR422.
4. FOR MAJOR CHORD LAYOUT, SEE SHEET BR406.
5. NF DENOTES NEAR FACE. FF DENOTES FAR FACE.

CLOUGH, HARBOUR & ASSOCIATES LLP
ENGINEERS, SURVEYORS, PLANNERS & LANDSCAPE ARCHITECTS
8 WINNERS CIRCLE ALBANY, NEW YORK, 12205

STATE OF VERMONT
AGENCY OF TRANSPORTATION

Town Of	SEARSBURG	Bridge No. 25B	
Highway No.	VT. RTE. 9	Log Sta.	
		Surv. Sta.	
VT. RTE. 9 OVER DEERFIELD RIVER			
ABUTMENT 1 PLAN			
Designed By D. VIENI		Drawn by J. LAGONE	
Checked By M. OLSTAD	Date 2/2002	Bridge Design Supervisor M. OLSTAD	Date 2/2002
PROJECT SEARSBURG - WILMINGTON		PROJECT NO. NHF 010-1(18)	
L.G.C. Info.			
Bridge Sheet No. BR414		Sheet 220 OF 435	

DATE/TIME = 02/28/02
USER = 2225