


ORIGINAL SURVEY	DATE
NOTE BOOK	BY
SURVEYED	
PLOTTED	
TEMPLATE	
AREAS	
AREAS CHECKED	
NO.	

GUARDRAIL

LINE OF NORMAL SHOULDER

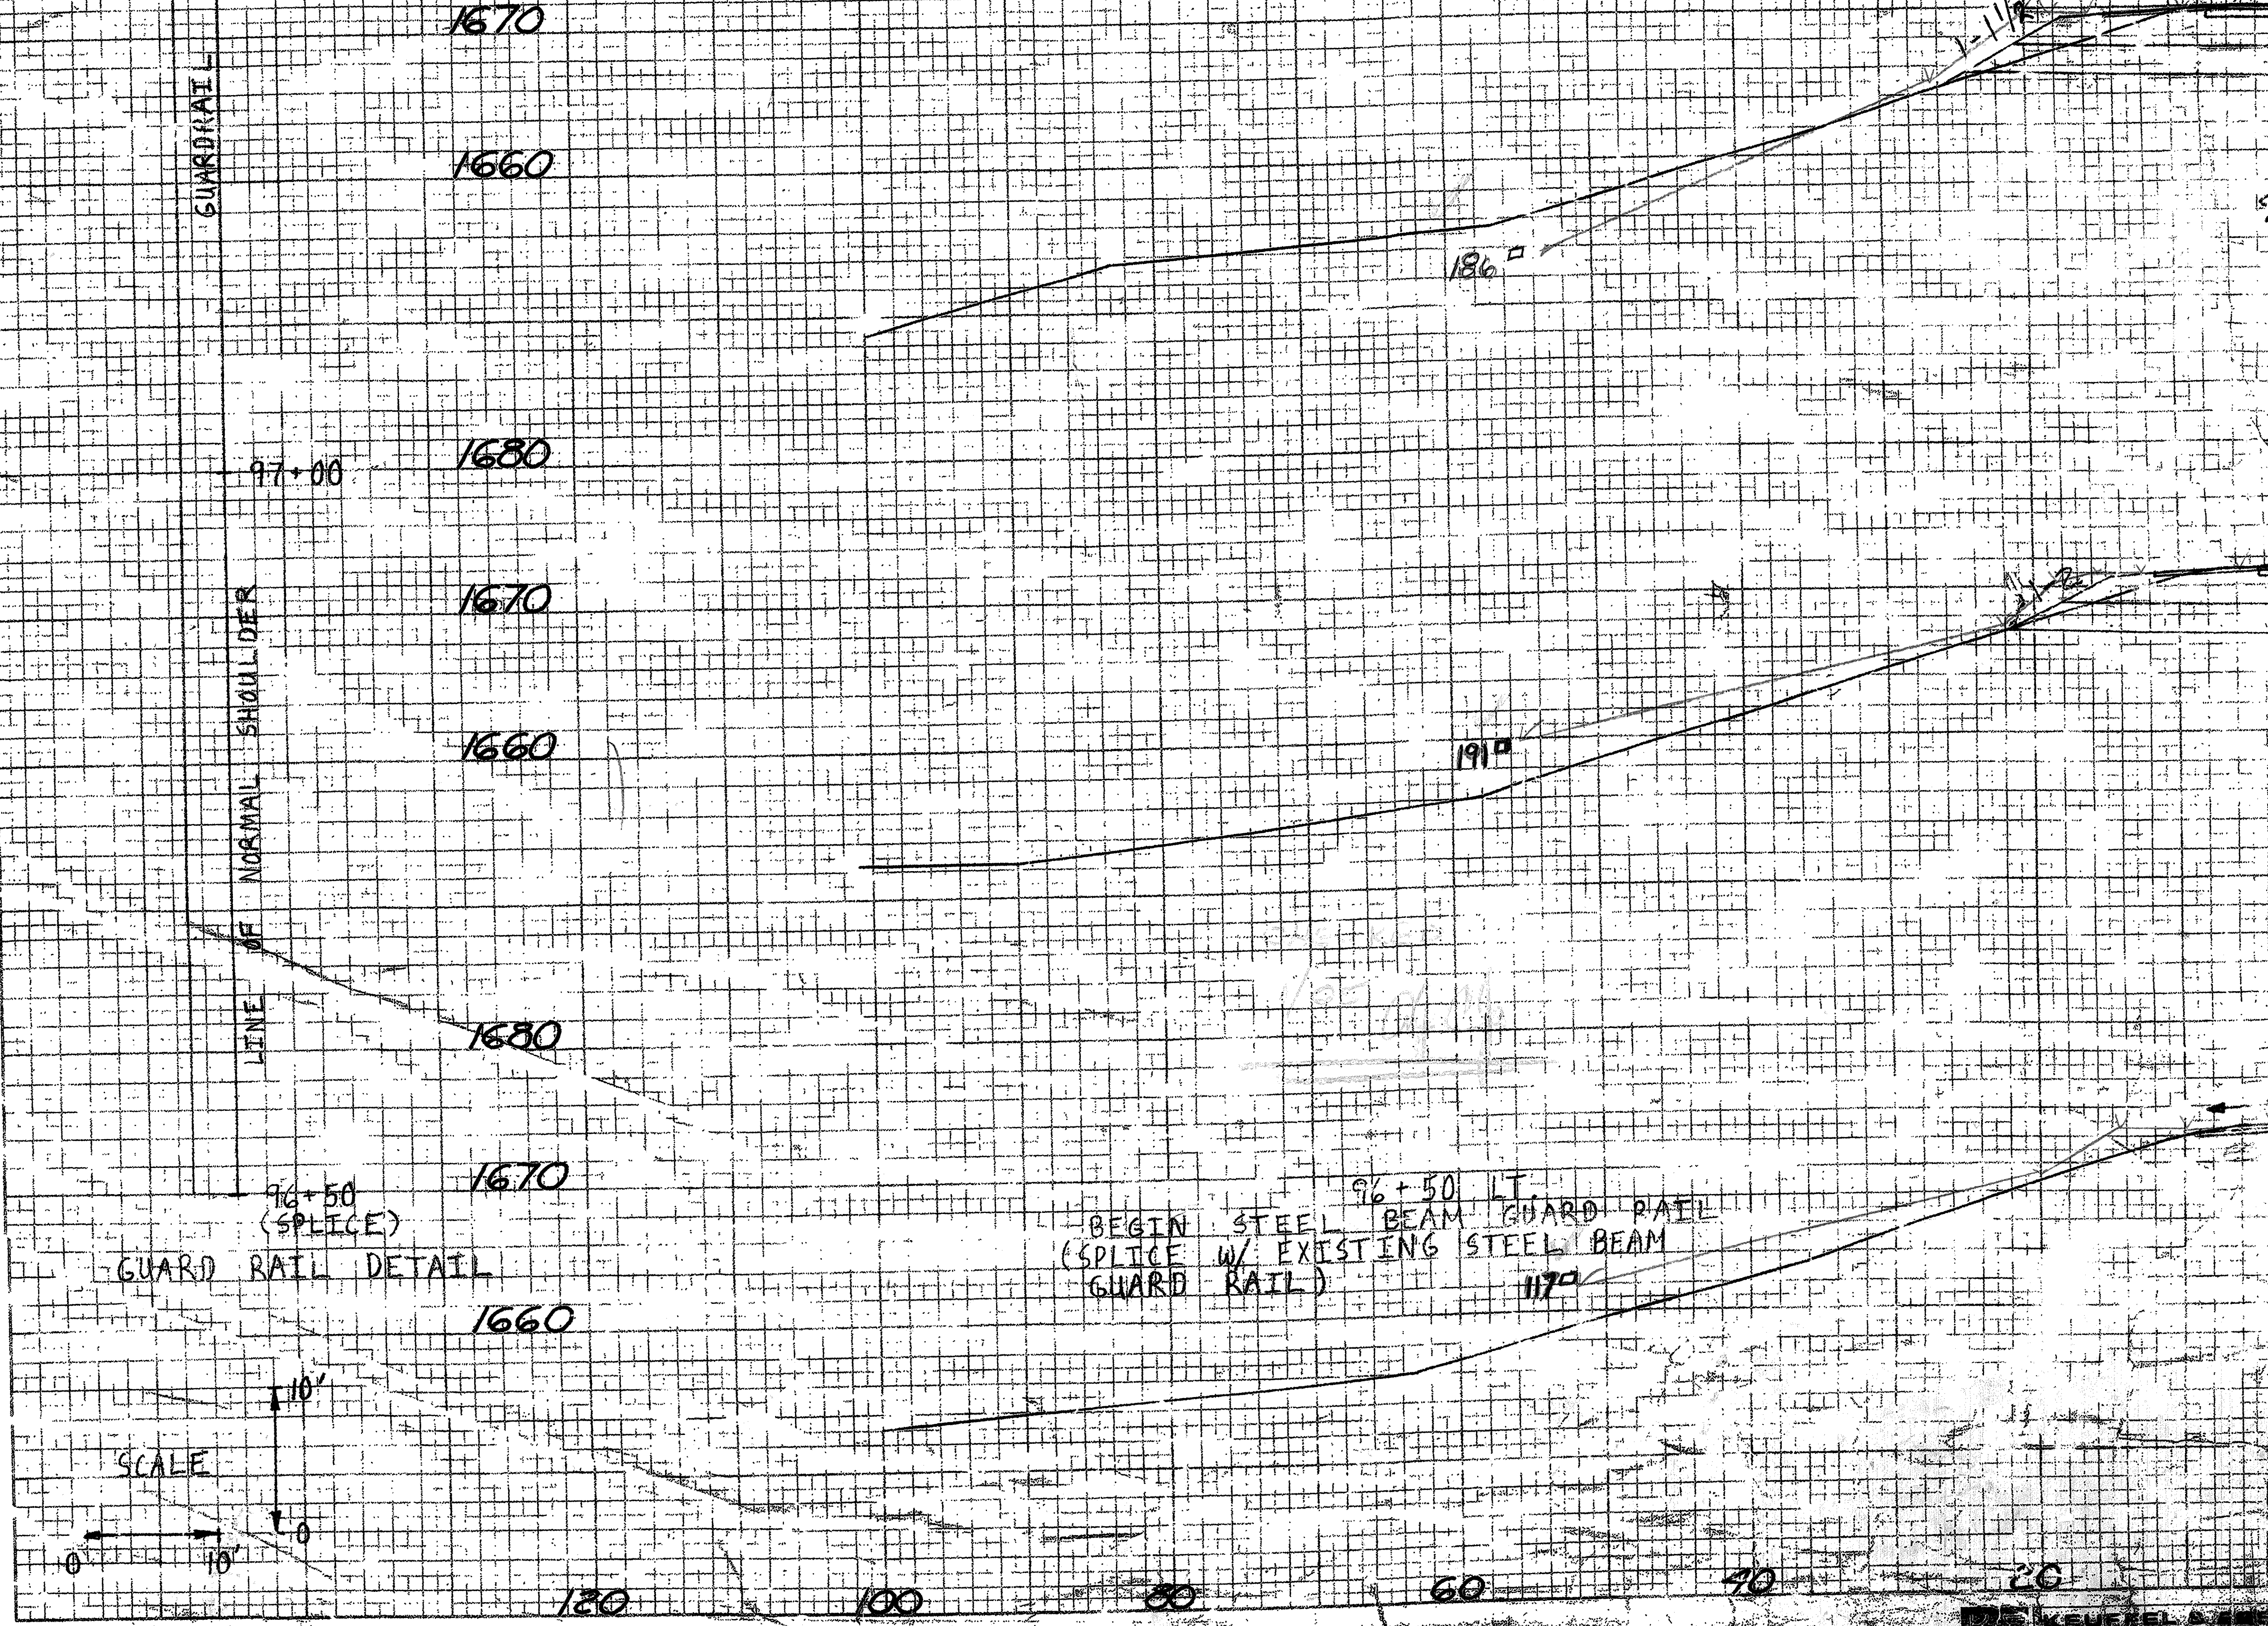

SCALE



120 100 80 60 40 20