


DATE	
BY	
SURVEYED	
PLOTTED	
TEMPLATE	
AREAS	
CHECKED	
ORIGINAL SURVEY NOTE BOOK NO.	

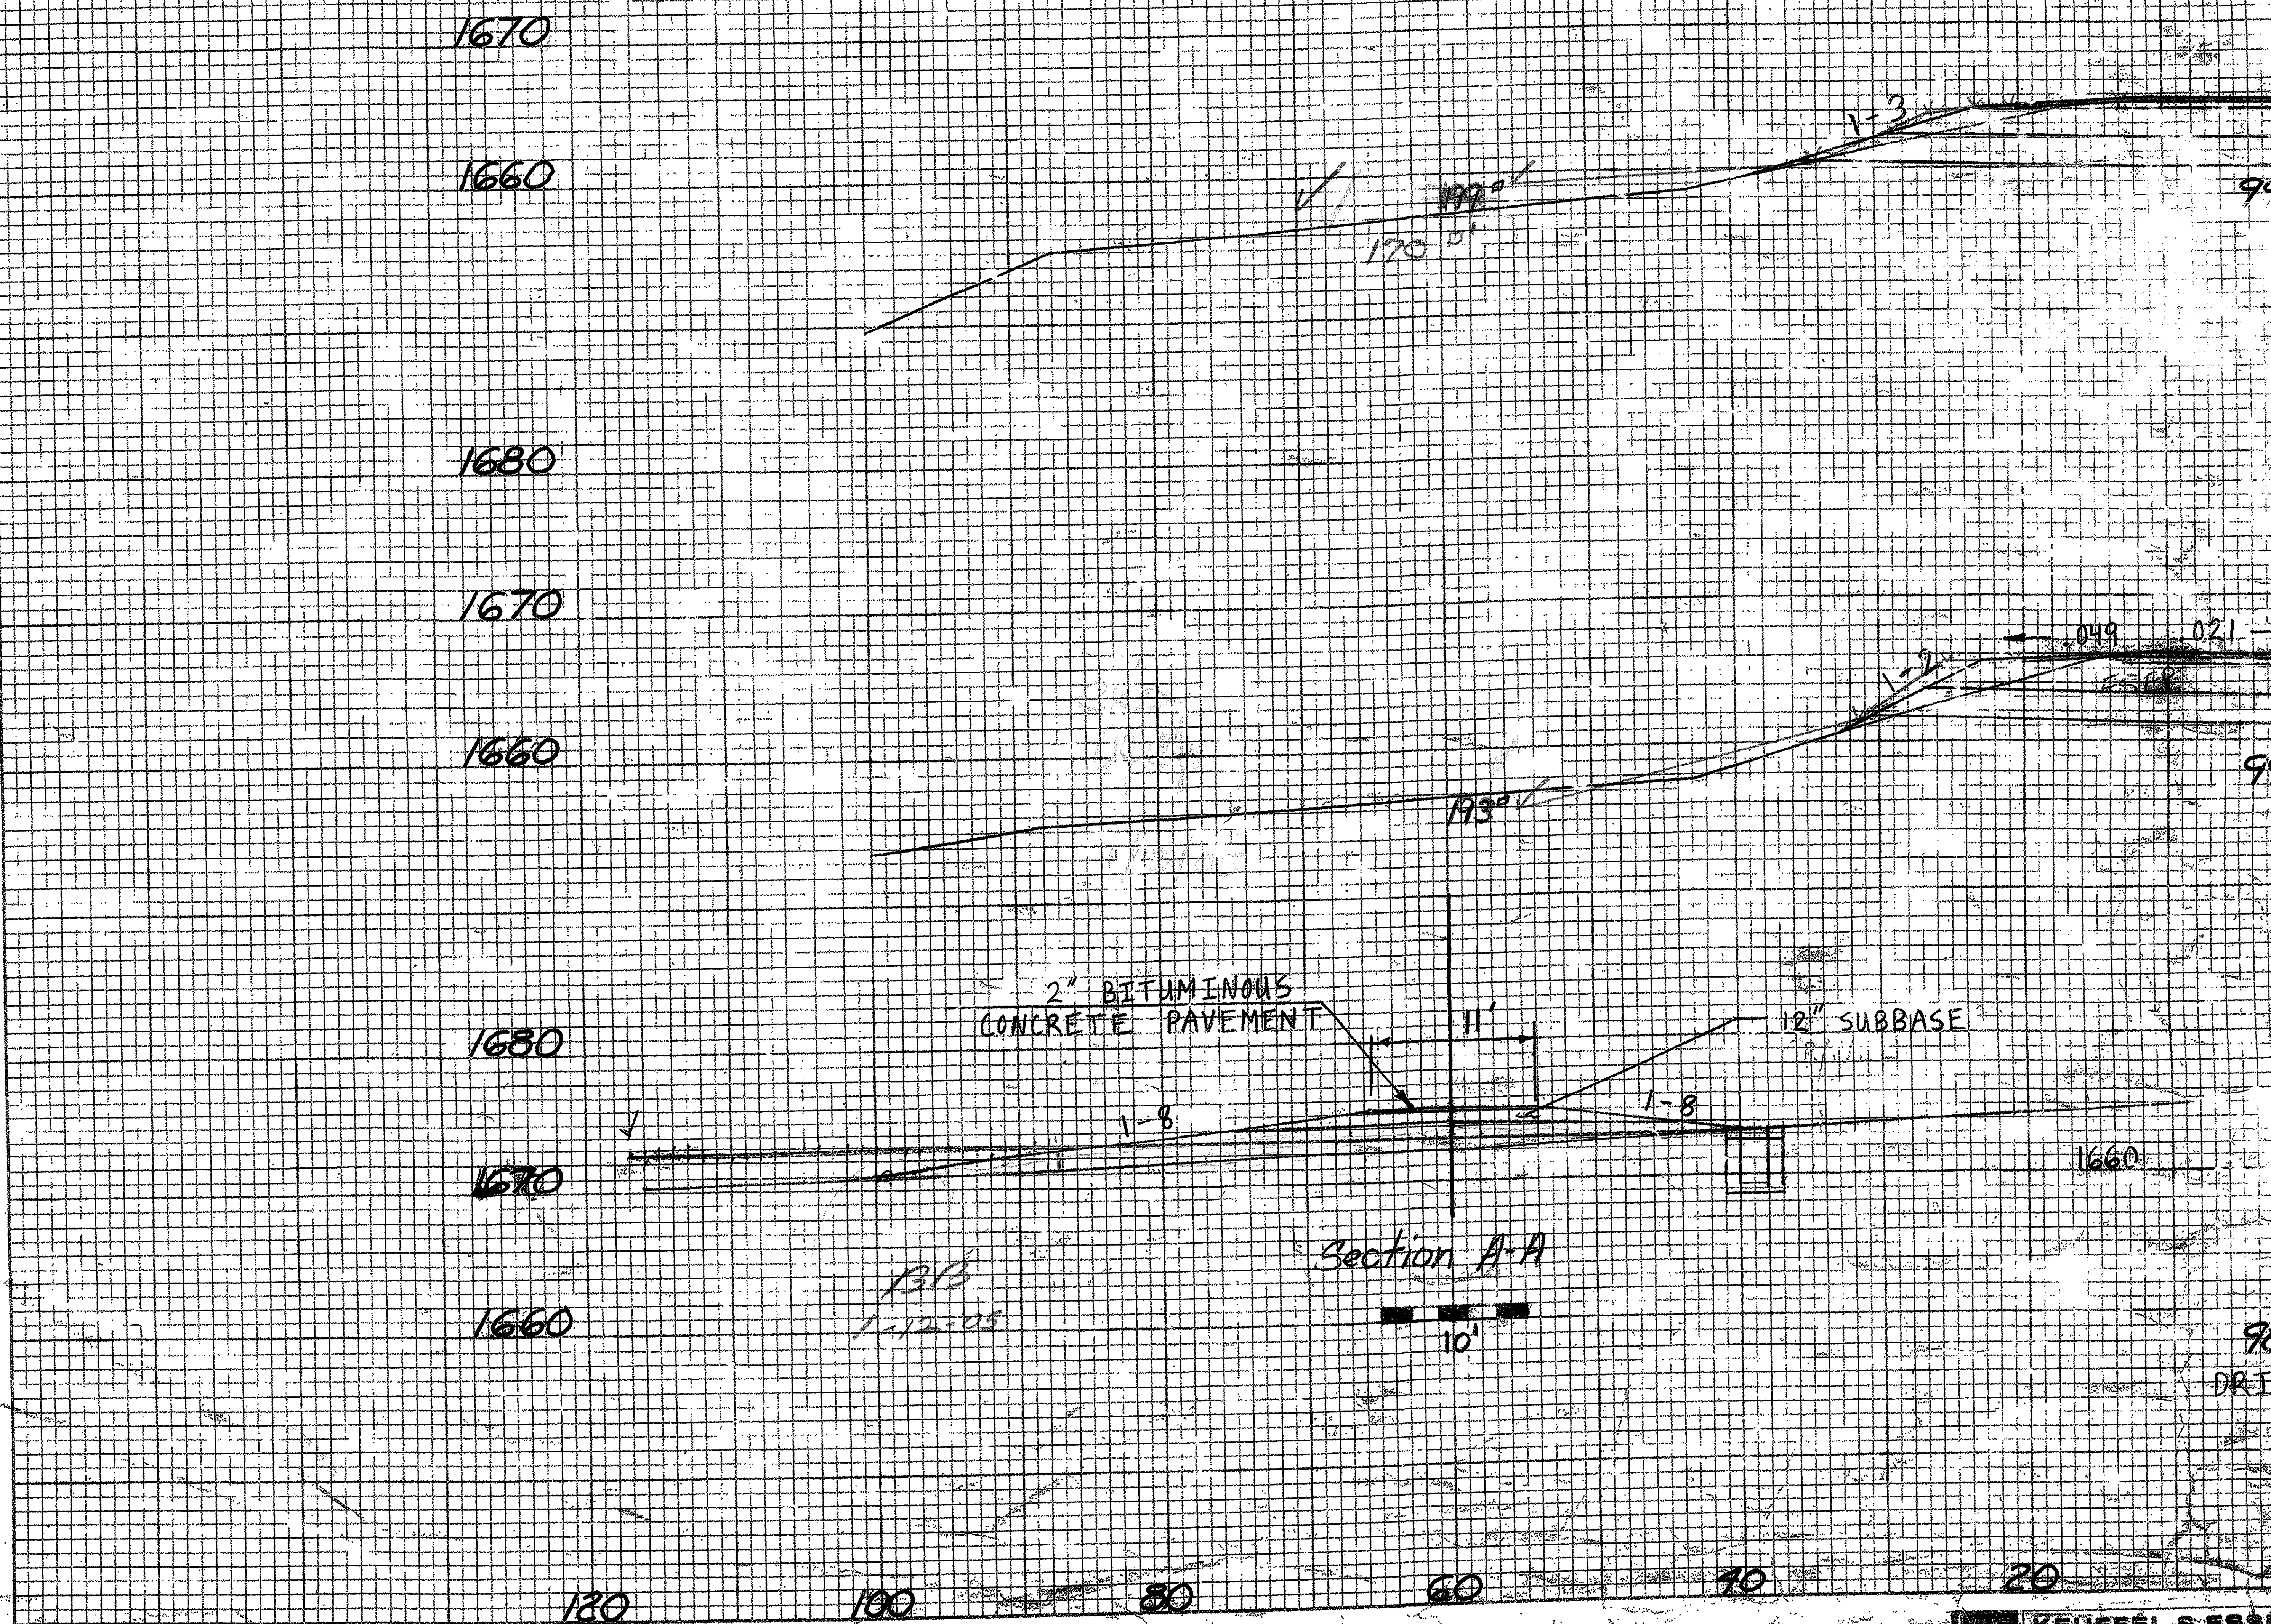

2" BITUMINOUS  
CONCRETE PAVEMENT

12" SUBBASE

Section A-A

10'

1313  
1-12-05