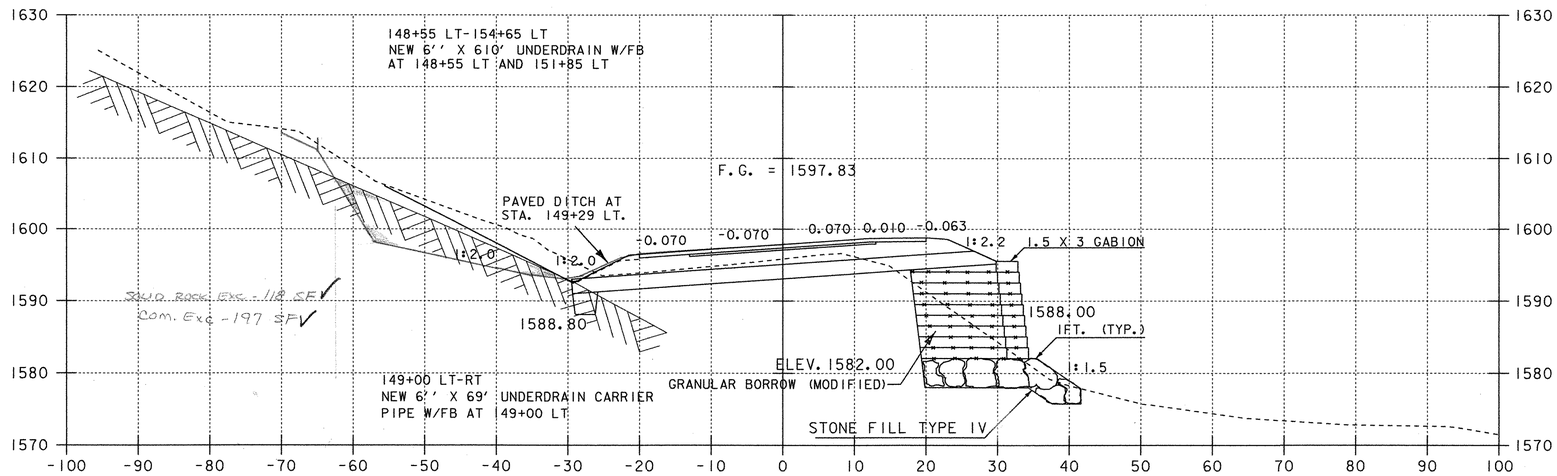

STA. 148+75 RT~ 152+25 RT
CONSTRUCT GABION WALL

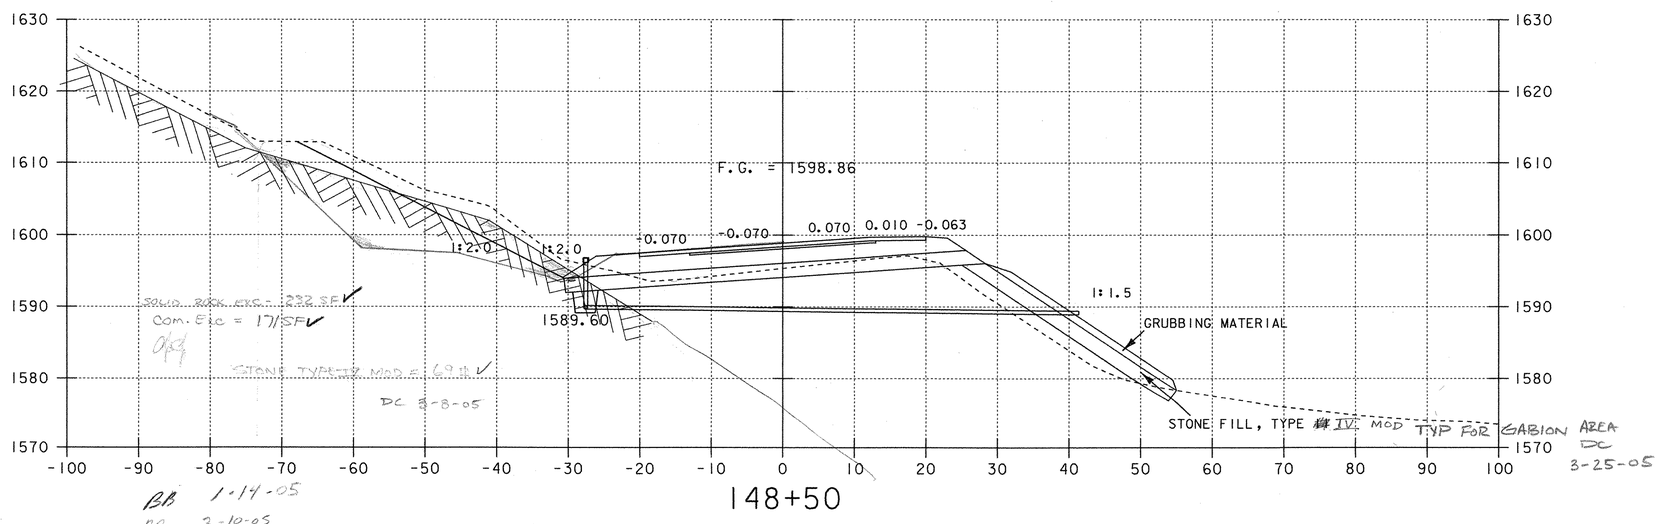

BB 1-14-05
BB 3-10-05

0 10 20
SCALE IN FEET

PROJECT NAME:	SEARSBURG - WILMINGTON
PROJECT NUMBER:	NHF 010-1(18)

PLOT FILE NAME: DD096X27 PLOT DATE: 20-FEB-2002
PROJECT LEADER: DELLA SANTA DRAWN BY: SQUAD B
DESIGN FILE NAME: 78D096/DESIGN/DD096CWRK.DGN:
SHEET 365 OF 435