SEARSBURG – WILMINGTON
NHF 010-1 (18)
STA. 187+50 TO 190+00
SHEET 381 OF 435

FINAL SURVEY
SURVEYED
PLOTTED
TEMPLATE
AREAS
AREAS CHECKED
NOTE BOOK
NO.
BY
DATE

ORIGINAL SURVEY
SURVEYED
PLOTTED
TEMPLATE
AREAS
AREAS CHECKED
NOTE BOOK
NO.
BY
DATE
12-13-
1-5-3

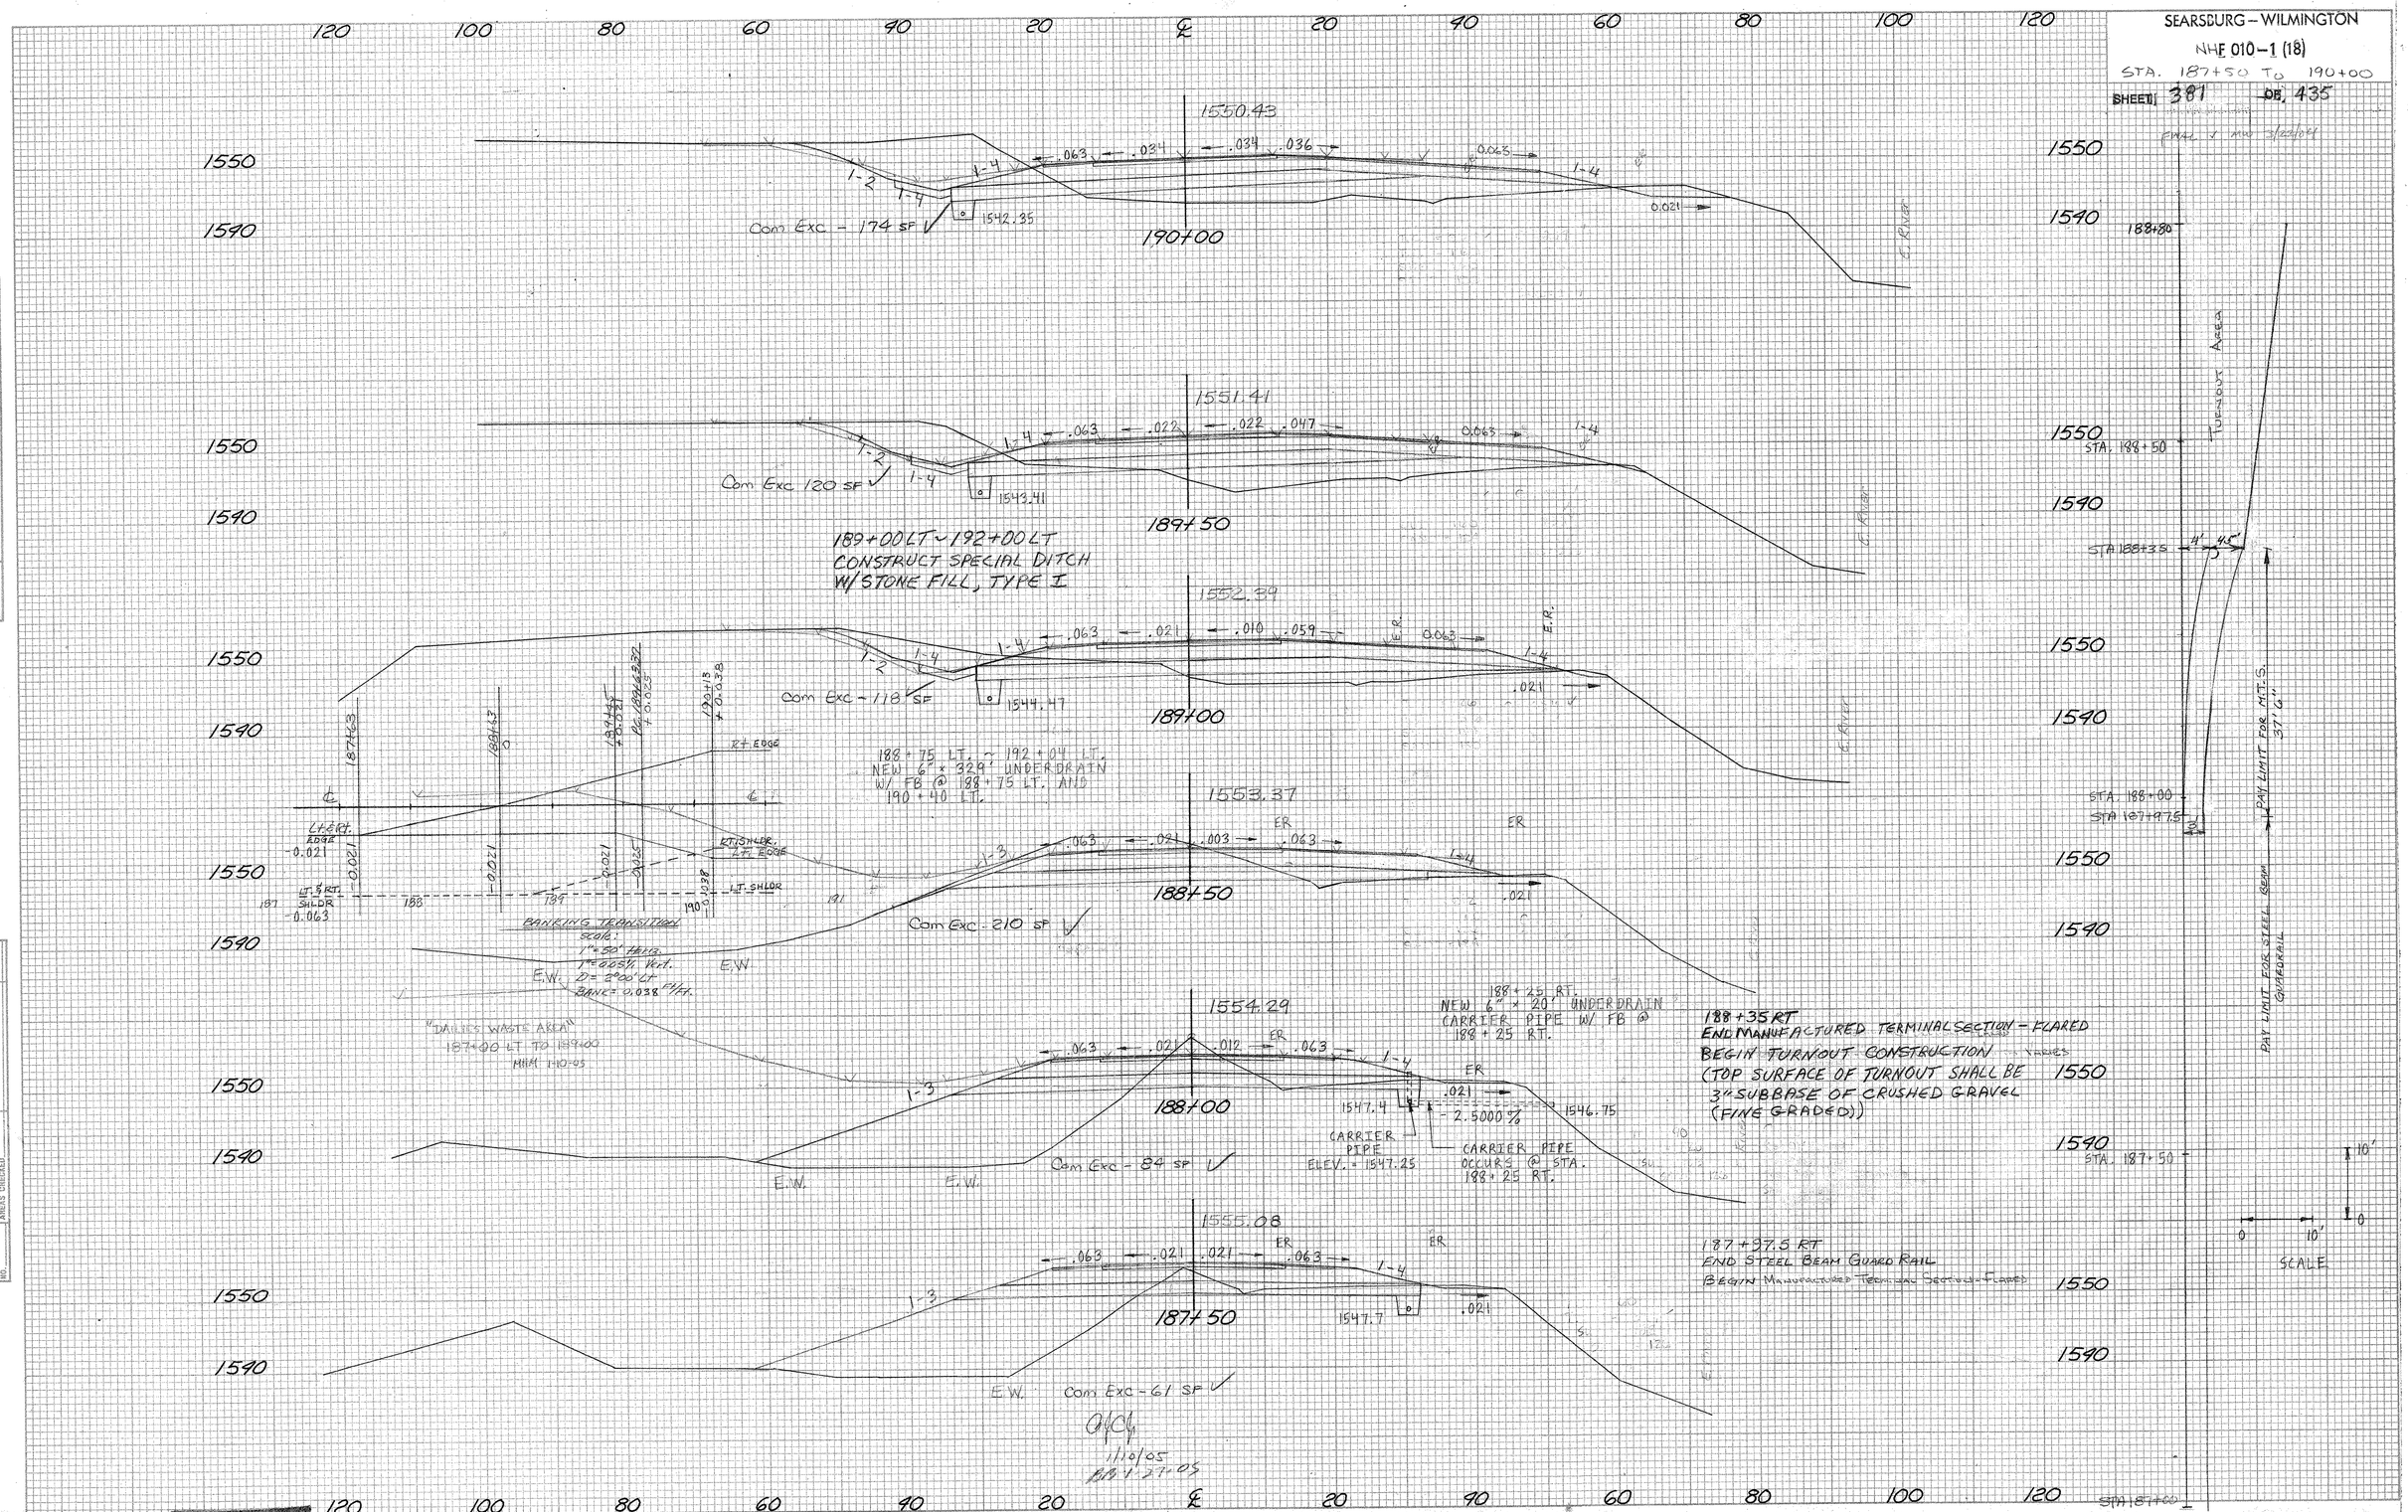

SHEET 381 OF 435