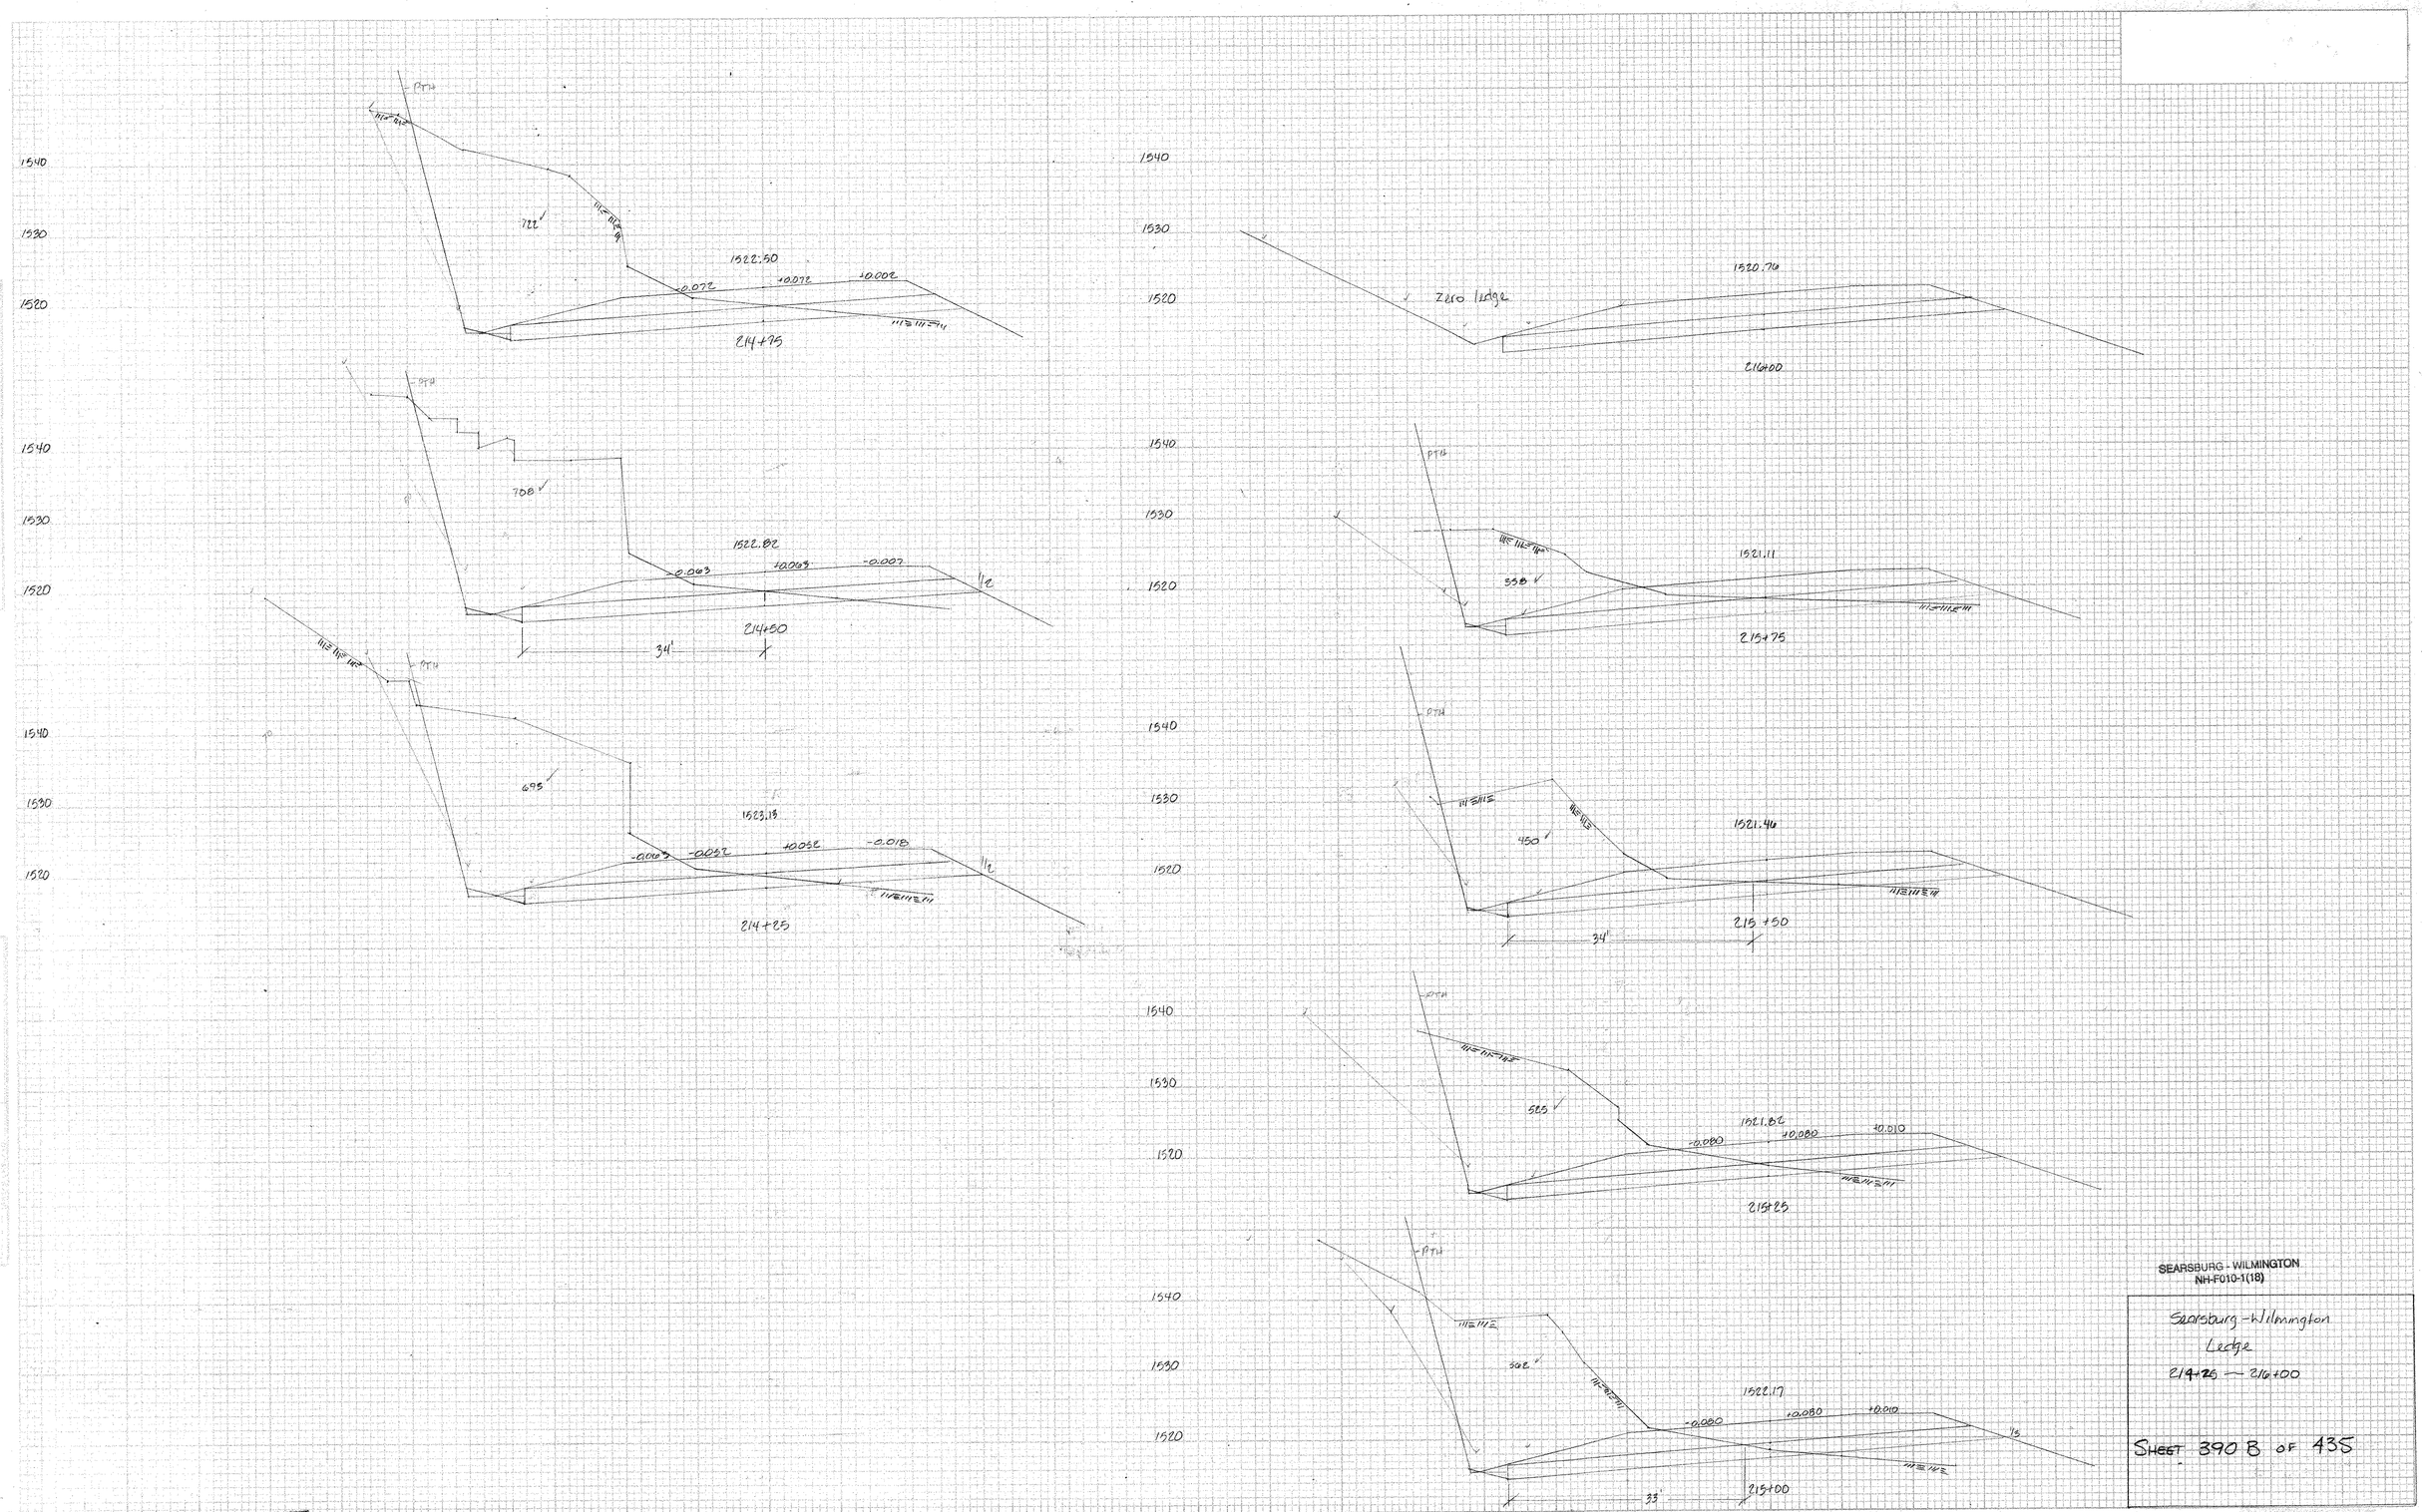

SEARSBURG - WILMINGTON
NH-F010-1(18)

Searsburg-Wilmington
Ledge
214+25 — 216+00

SHEET 390 B OF 435