SEARSBURG – WILMINGTON
NHF 010-1 (18)
STA. 230+00 TO 231+00
SHEET 397 OF 435

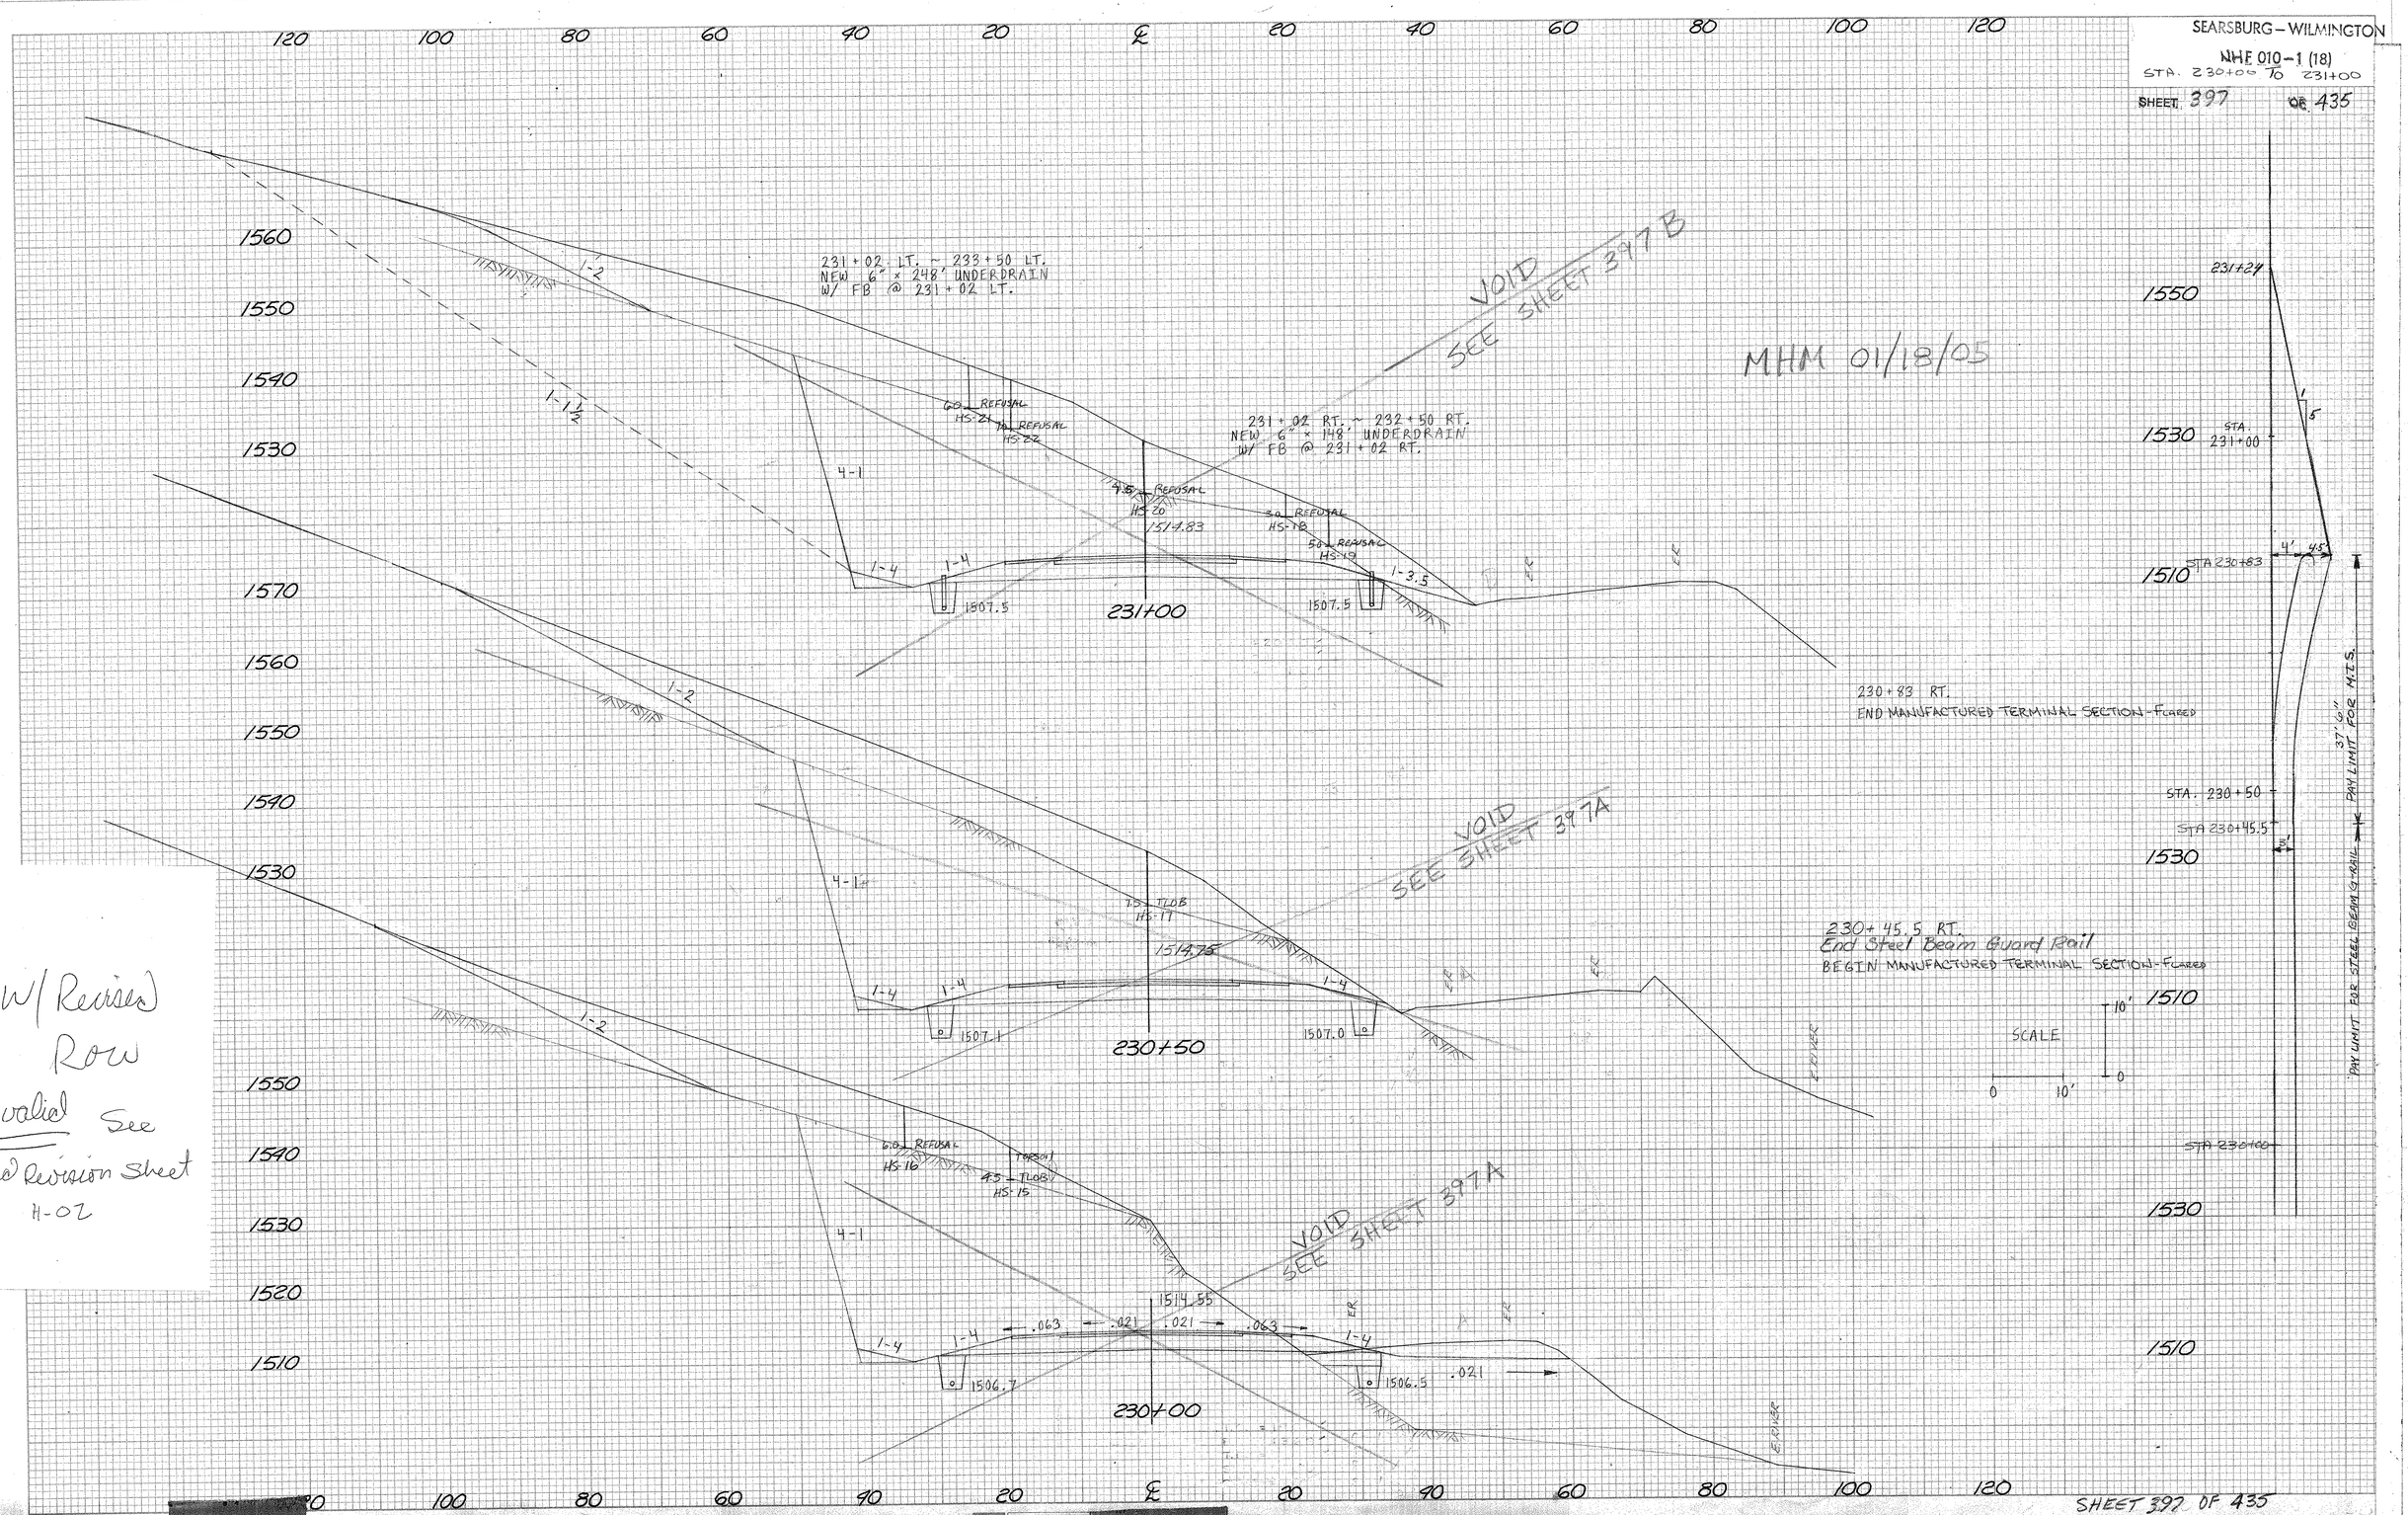

W/ Revised Row
Invalid See 2nd Revision Sheet H-02

FINAL SURVEY		BY	DATE
	SURVEYED		
	PLOTTED		
	TEMPLATE		
NOTE BOOK	AREAS		
	AREAS CHECKED		
NO.			