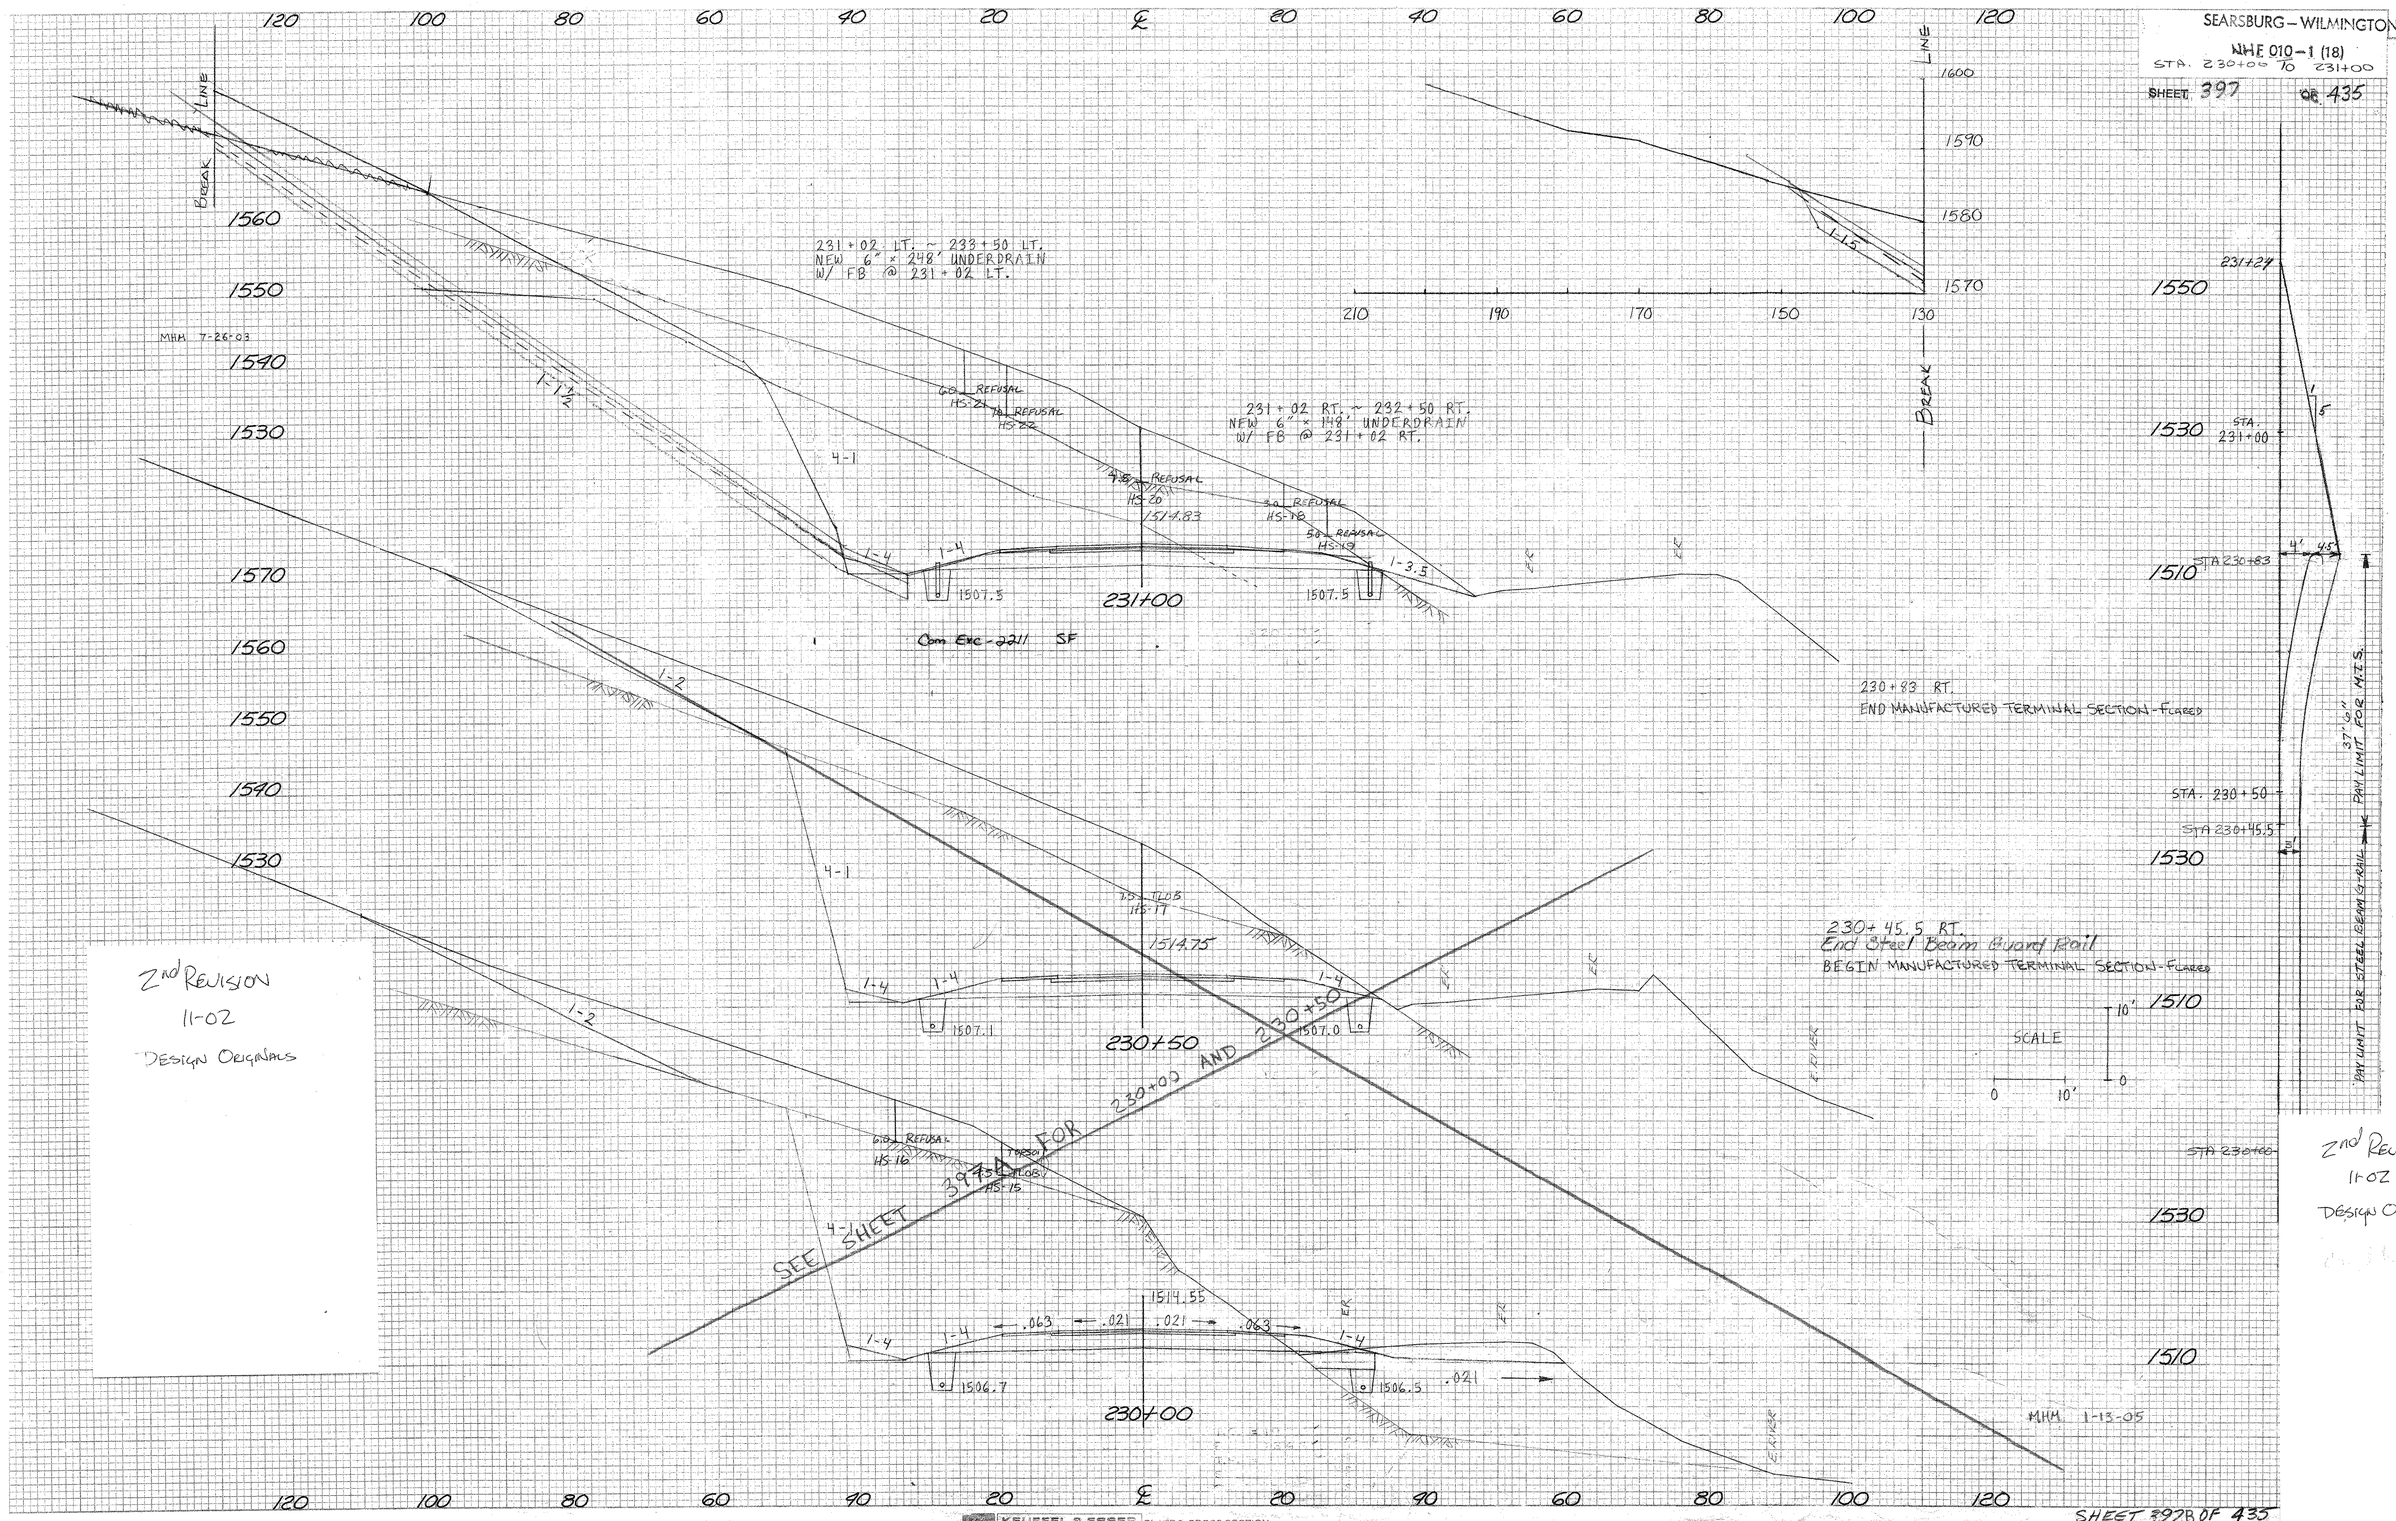
SEARSBURG – WILMINGTON
WHE 010-1 (18)
STA. 230+00 TO 231+00
SHEET 397 OF 435
231+02 LT. ~ 233+50 LT.
NEW 6" x 248' UNDERDRAIN
W/ FB @ 231+02 LT.
231+02 RT. ~ 232+50 RT.
NEW 6" x 148' UNDERDRAIN
W/ FB @ 231+02 RT.
231+00
230+83 RT.
END MANUFACTURED TERMINAL SECTION - FLARED
230+45.5 RT.
End Steel Beam Guard Rail
BEGIN MANUFACTURED TERMINAL SECTION - FLARED
230+50
230+00
SEE SHEET 397A FOR 230+00 AND 230+50
SCALE
PAY LIMIT FOR M.T.S.
PAY LIMIT FOR STEEL BEAM G-RAIL
2nd REVISION
11-02
DESIGN ORIGINALS
MHM 7-26-03
MHM 1-13-05
KEUFFEL & ESSER
PLATE 3, CROSS SECTION
SHEET 397B OF 435