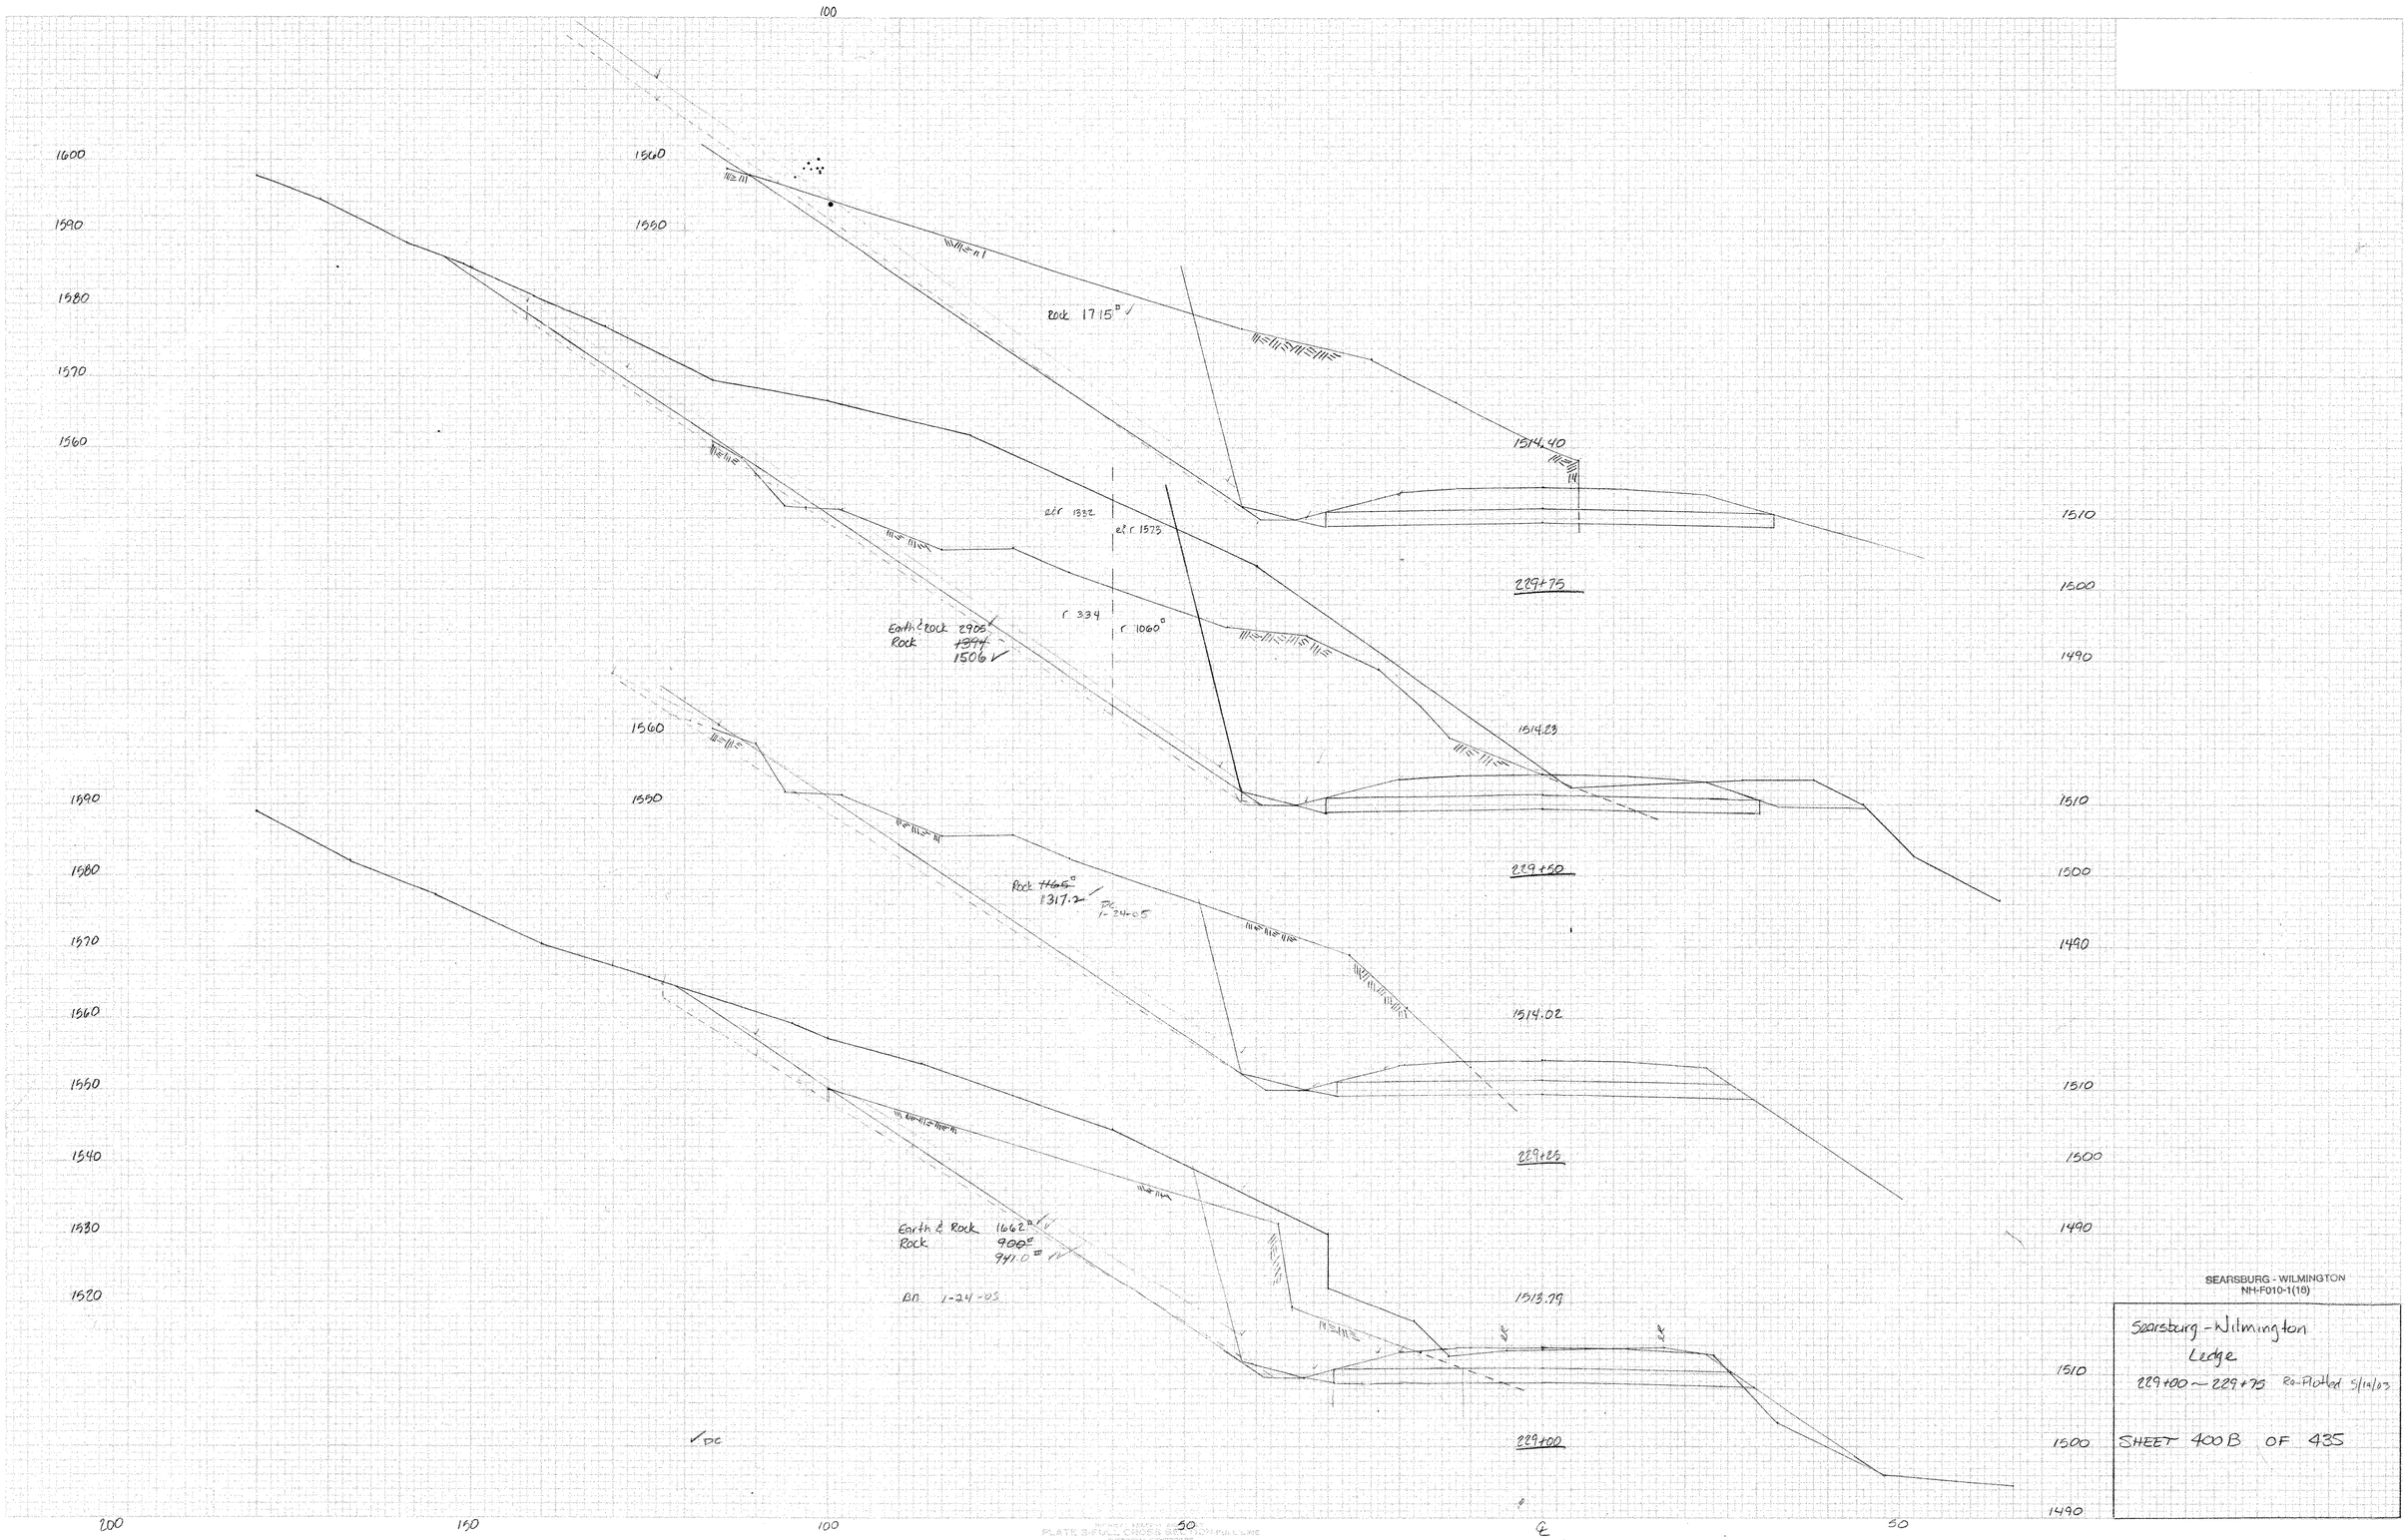

SEARSBURG - WILMINGTON
NH-F010-1(18)

Searsburg - Wilmington
Ledge
229+00 ~ 229+75 Re-Plotted 5/14/03

SHEET 400B OF 435