SEARSBURG – WILMINGTON

NHF 010-1 (18)

STA. 265+50 TO 267+00

SHEET 417 OF 435

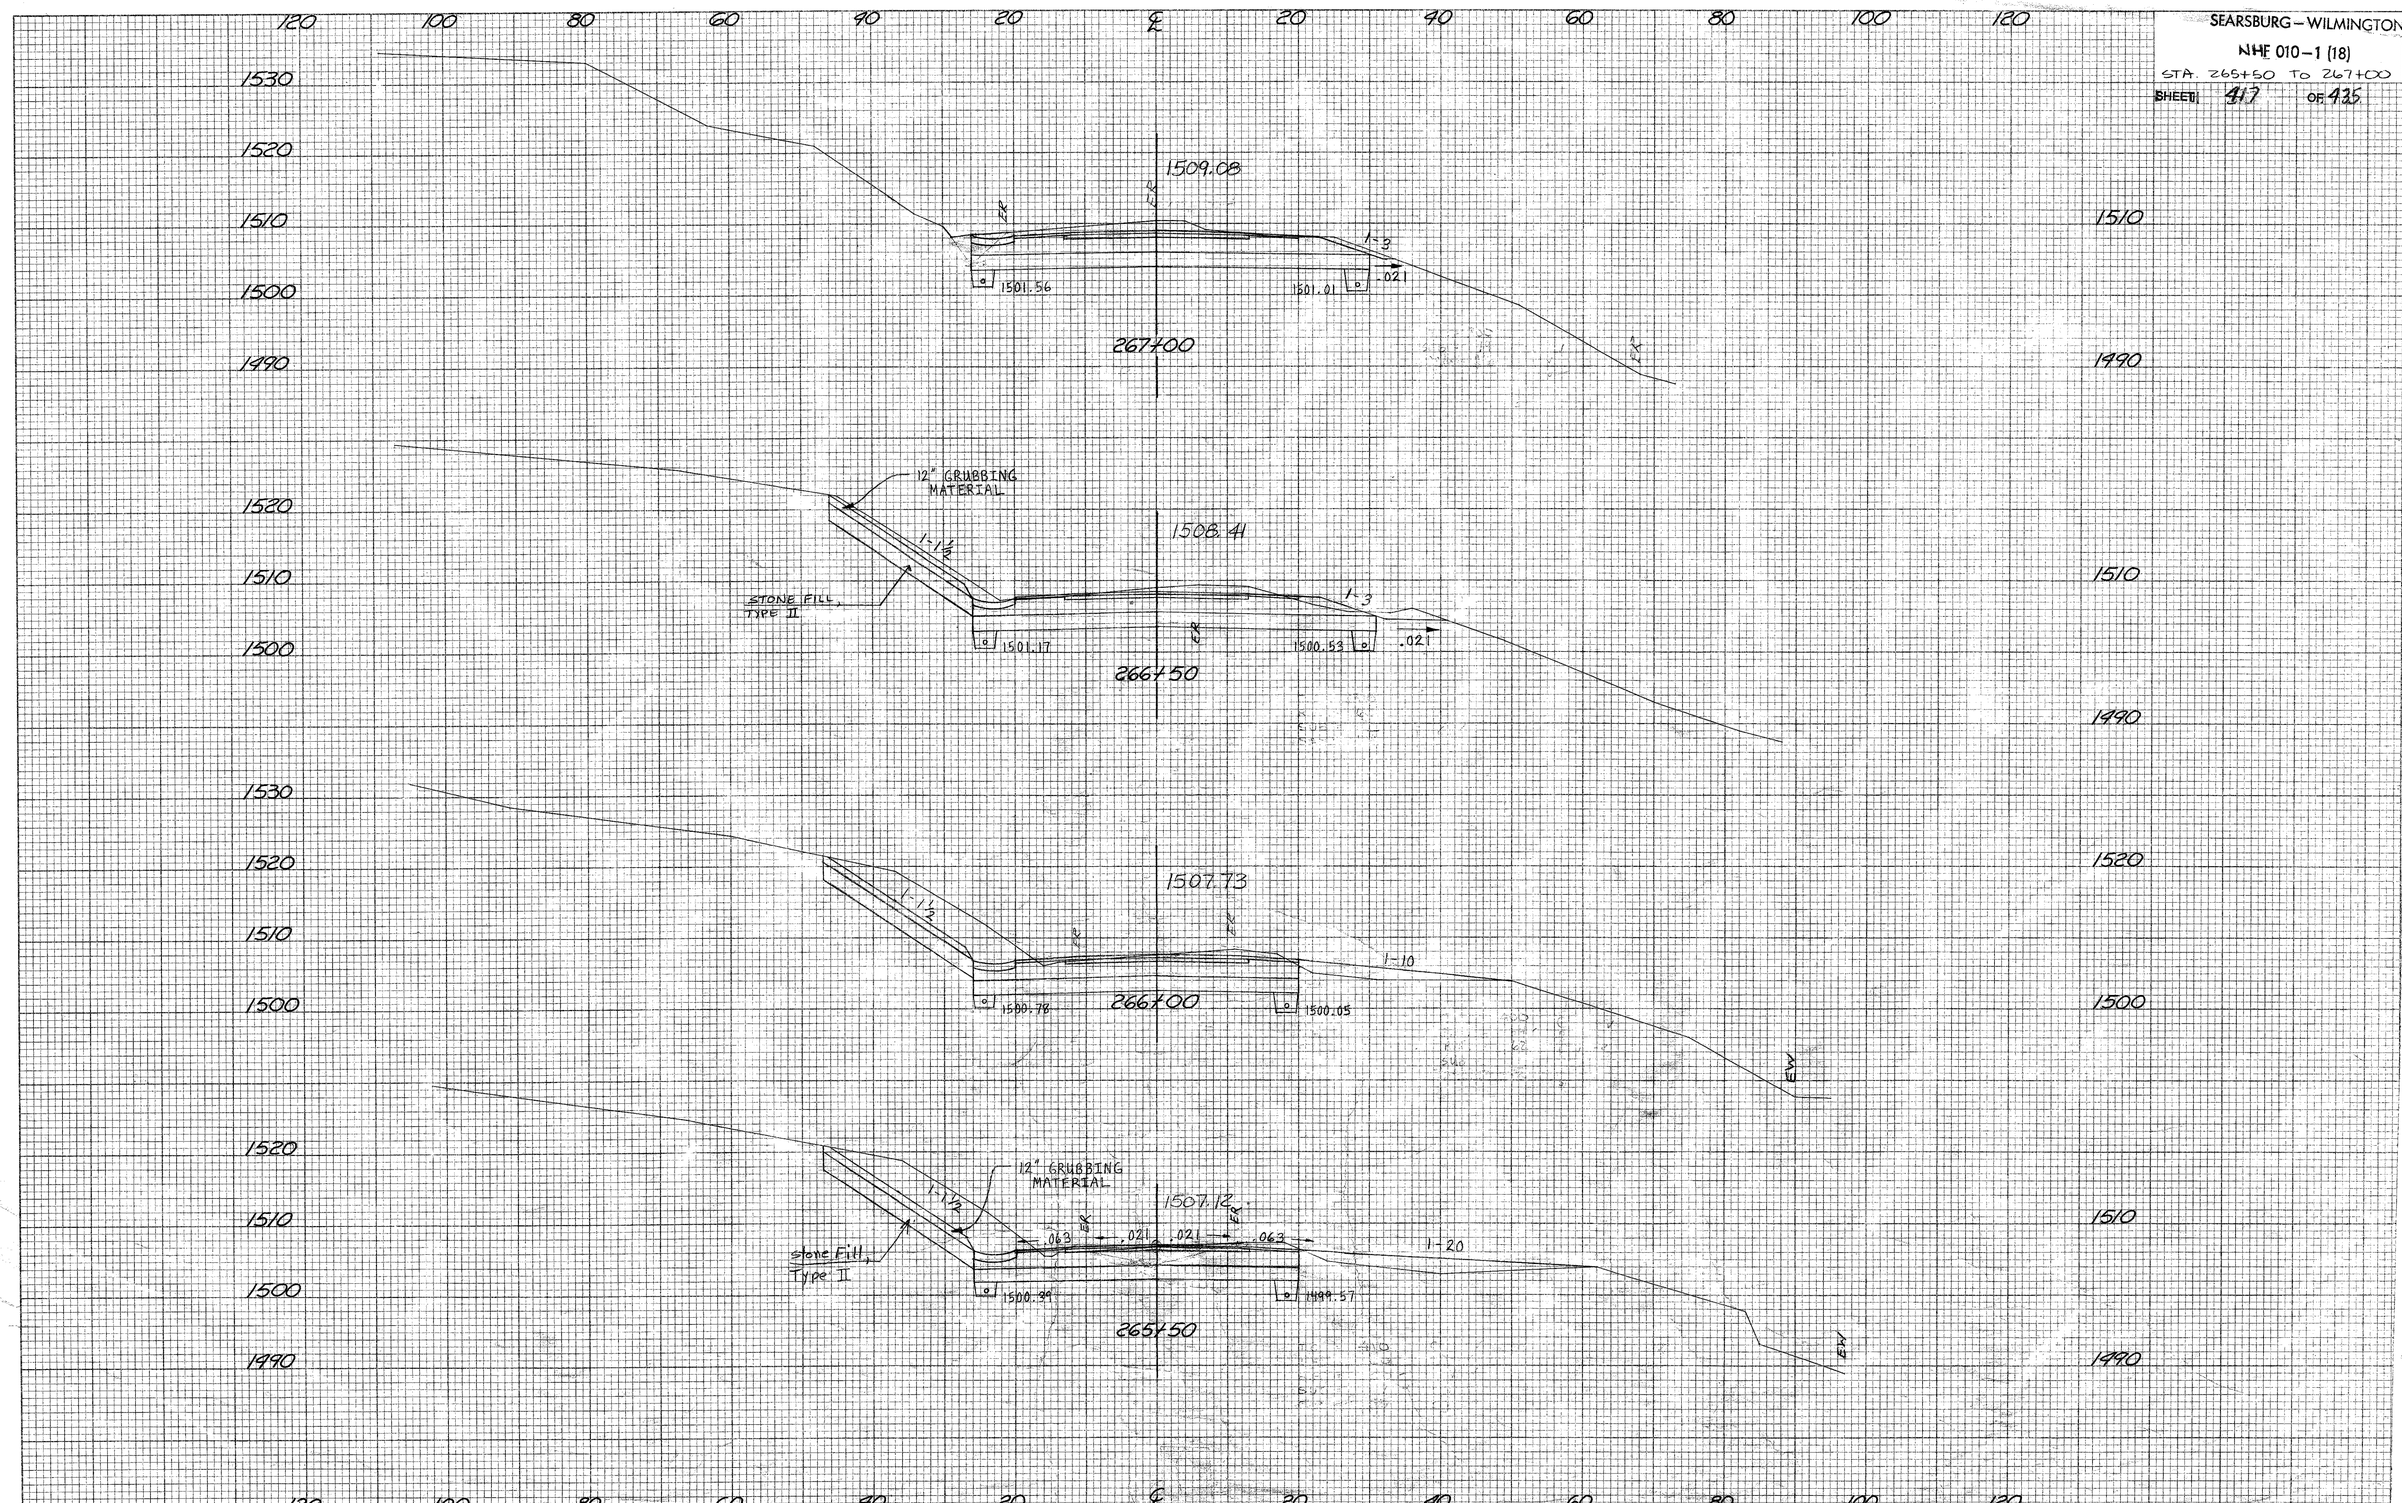

FINAL SURVEY		BY	DATE
NOTE BOOK	SURVEYED		
	PLOTTED		
	TEMPLATE		
	AREAS		
NO.	AREAS CHECKED		

ORIGINAL SURVEY		BY	DATE
NOTE BOOK	SURVEYED		
	PLOTTED		
	TEMPLATE		
	AREAS		
NO.	AREAS CHECKED		

KEUFFEL & ESSER / KNATCH Company PLATE 3, CROSS SECTION

SHEET 417 OF 435