SEARSBURG – WILMINGTON
NHF 010-1 (18)
STA 285+00 TO 287+50
SHEET 425 OF 435

FINAL SURVEY		BY	DATE
NOTE BOOK	SURVEYED		
	PLOTTED		
	TEMPLATE		
	AREAS		
NO.	AREAS CHECKED		

ORIGINAL SURVEY		BY	DATE
NOTE BOOK	SURVEYED		
	PLOTTED		
	TEMPLATE		
	AREAS		
NO.	AREAS CHECKED		

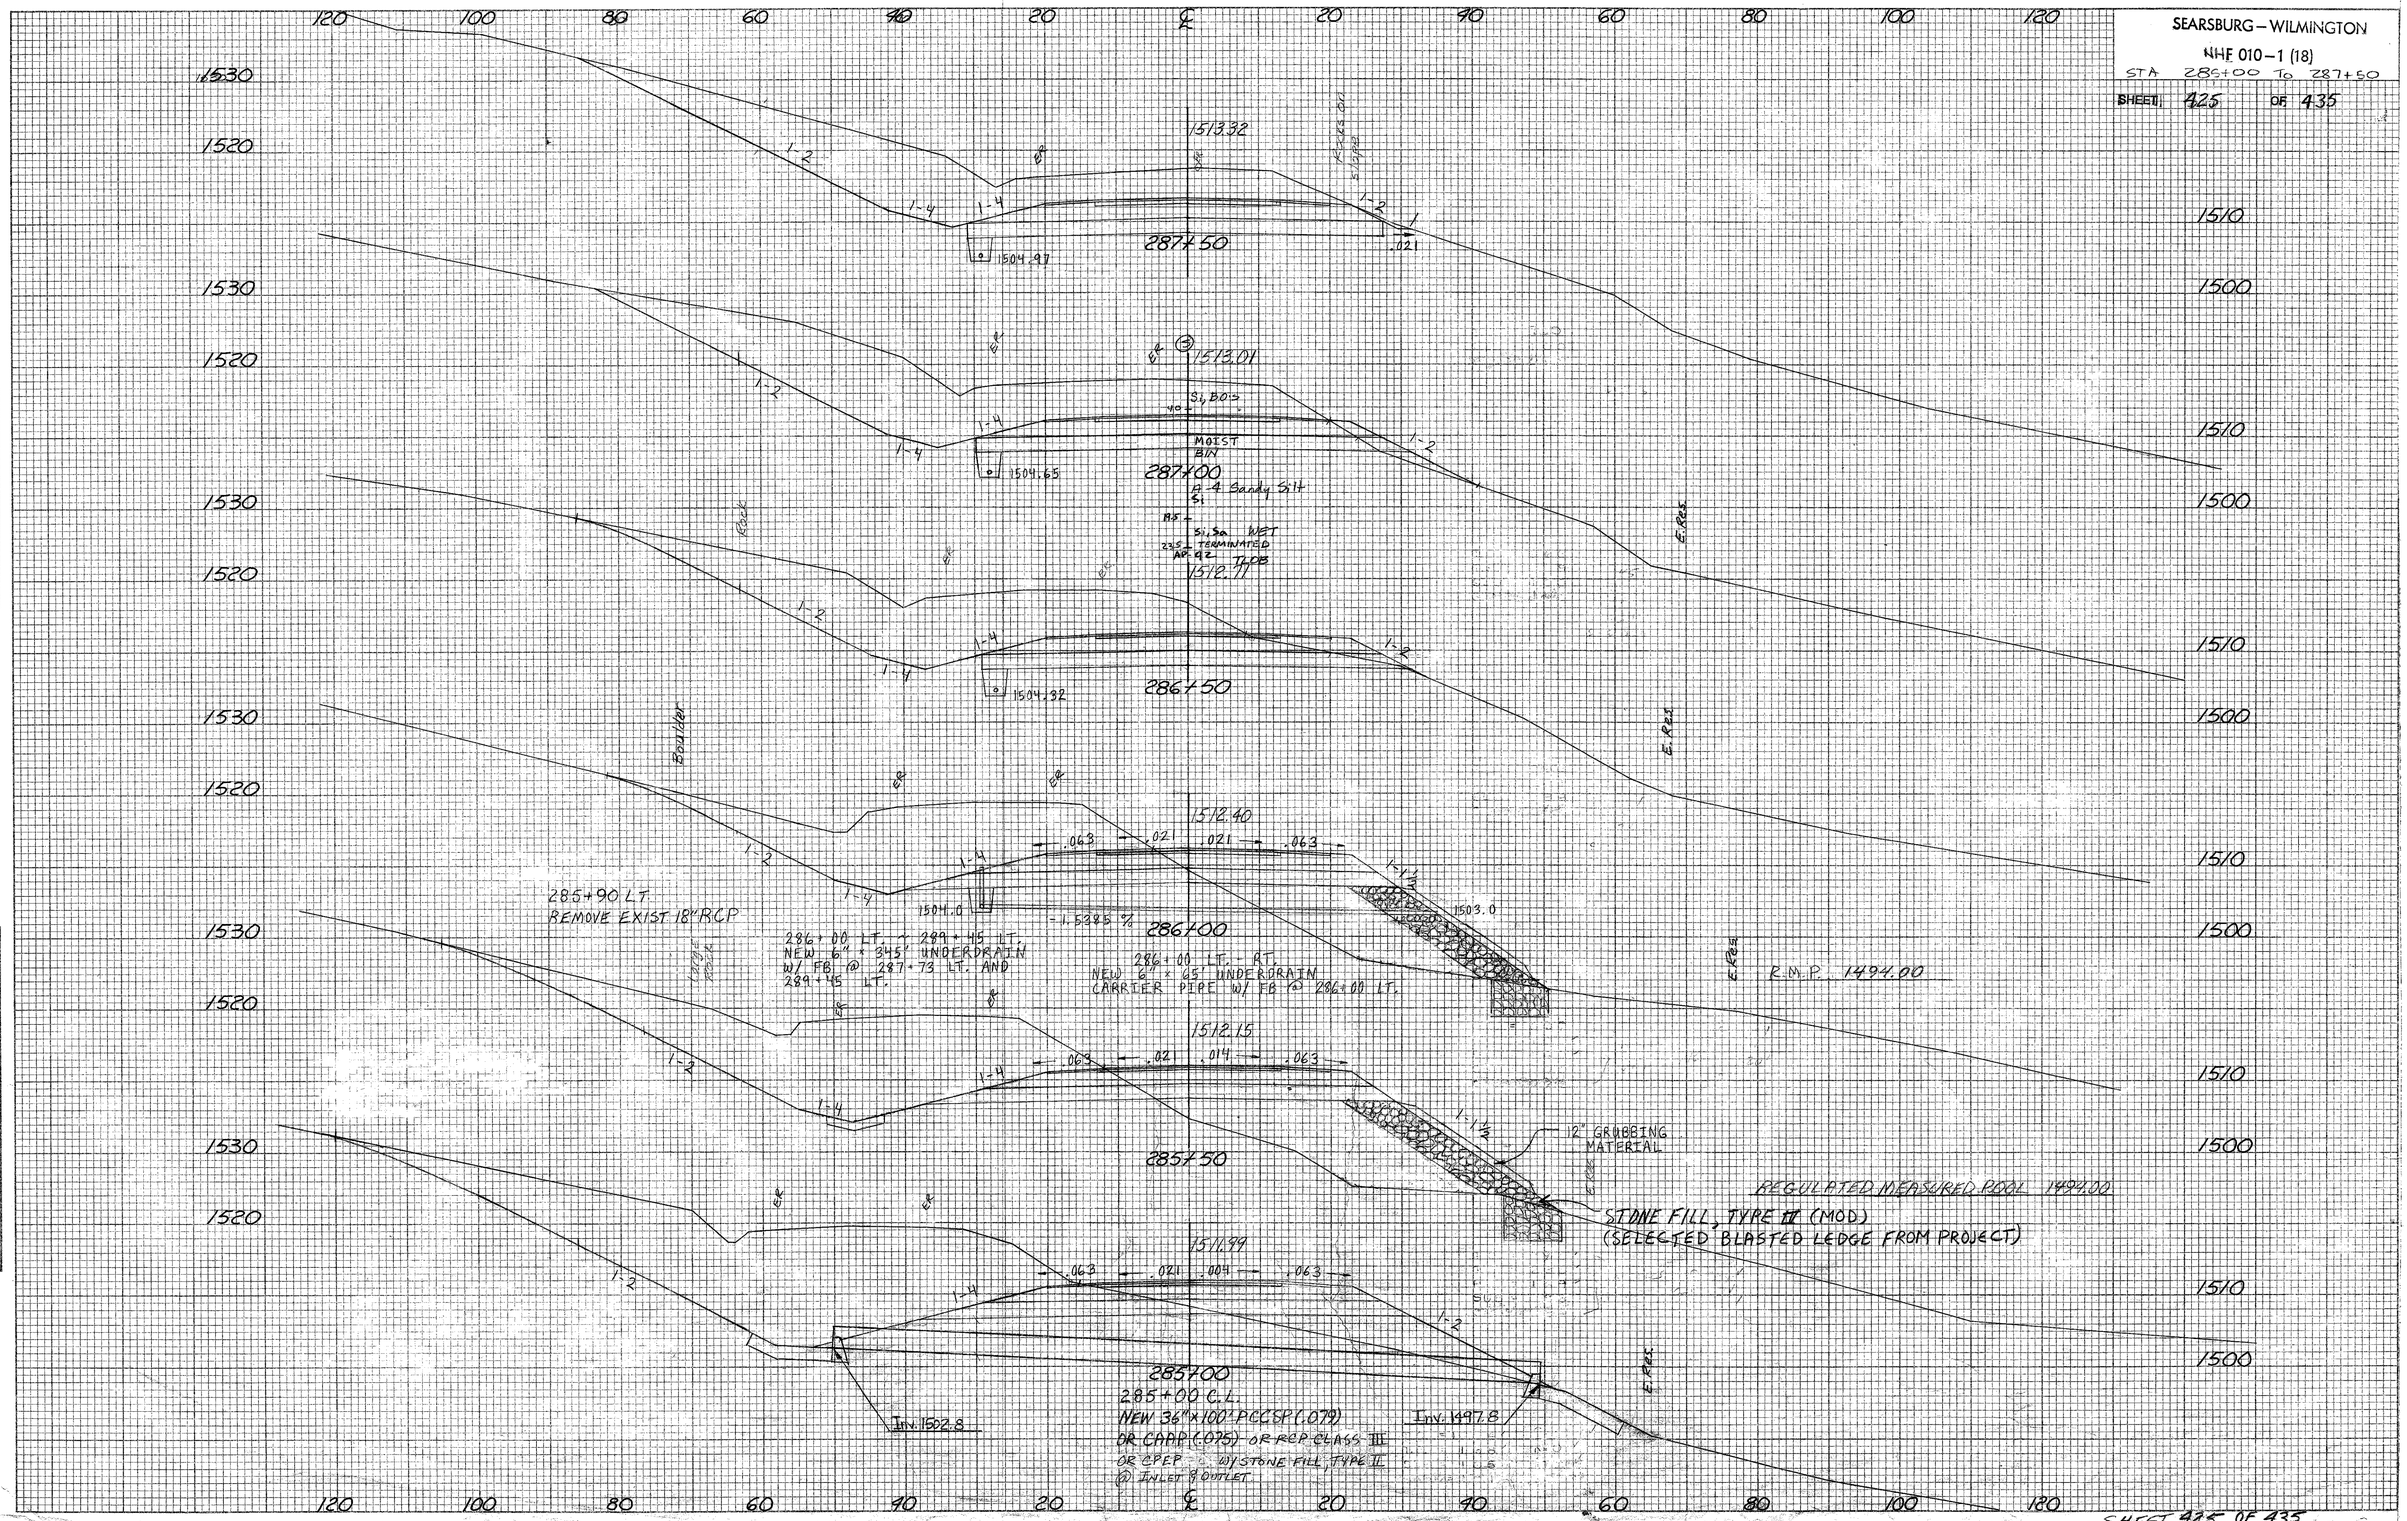

PLATE 3, CROSS SECTION
KEUFFEL & ESSER CO.

SHEET 425 OF 435