


DATE _____
 BY _____
 ORIGINAL SURVEY PLOTTED _____
 SURVEY NOTE BOOK NO. _____
 AREAS CHECKED _____

DATE _____
 BY _____
 ORIGINAL SURVEY PLOTTED _____
 SURVEY NOTE BOOK NO. _____
 AREAS CHECKED _____

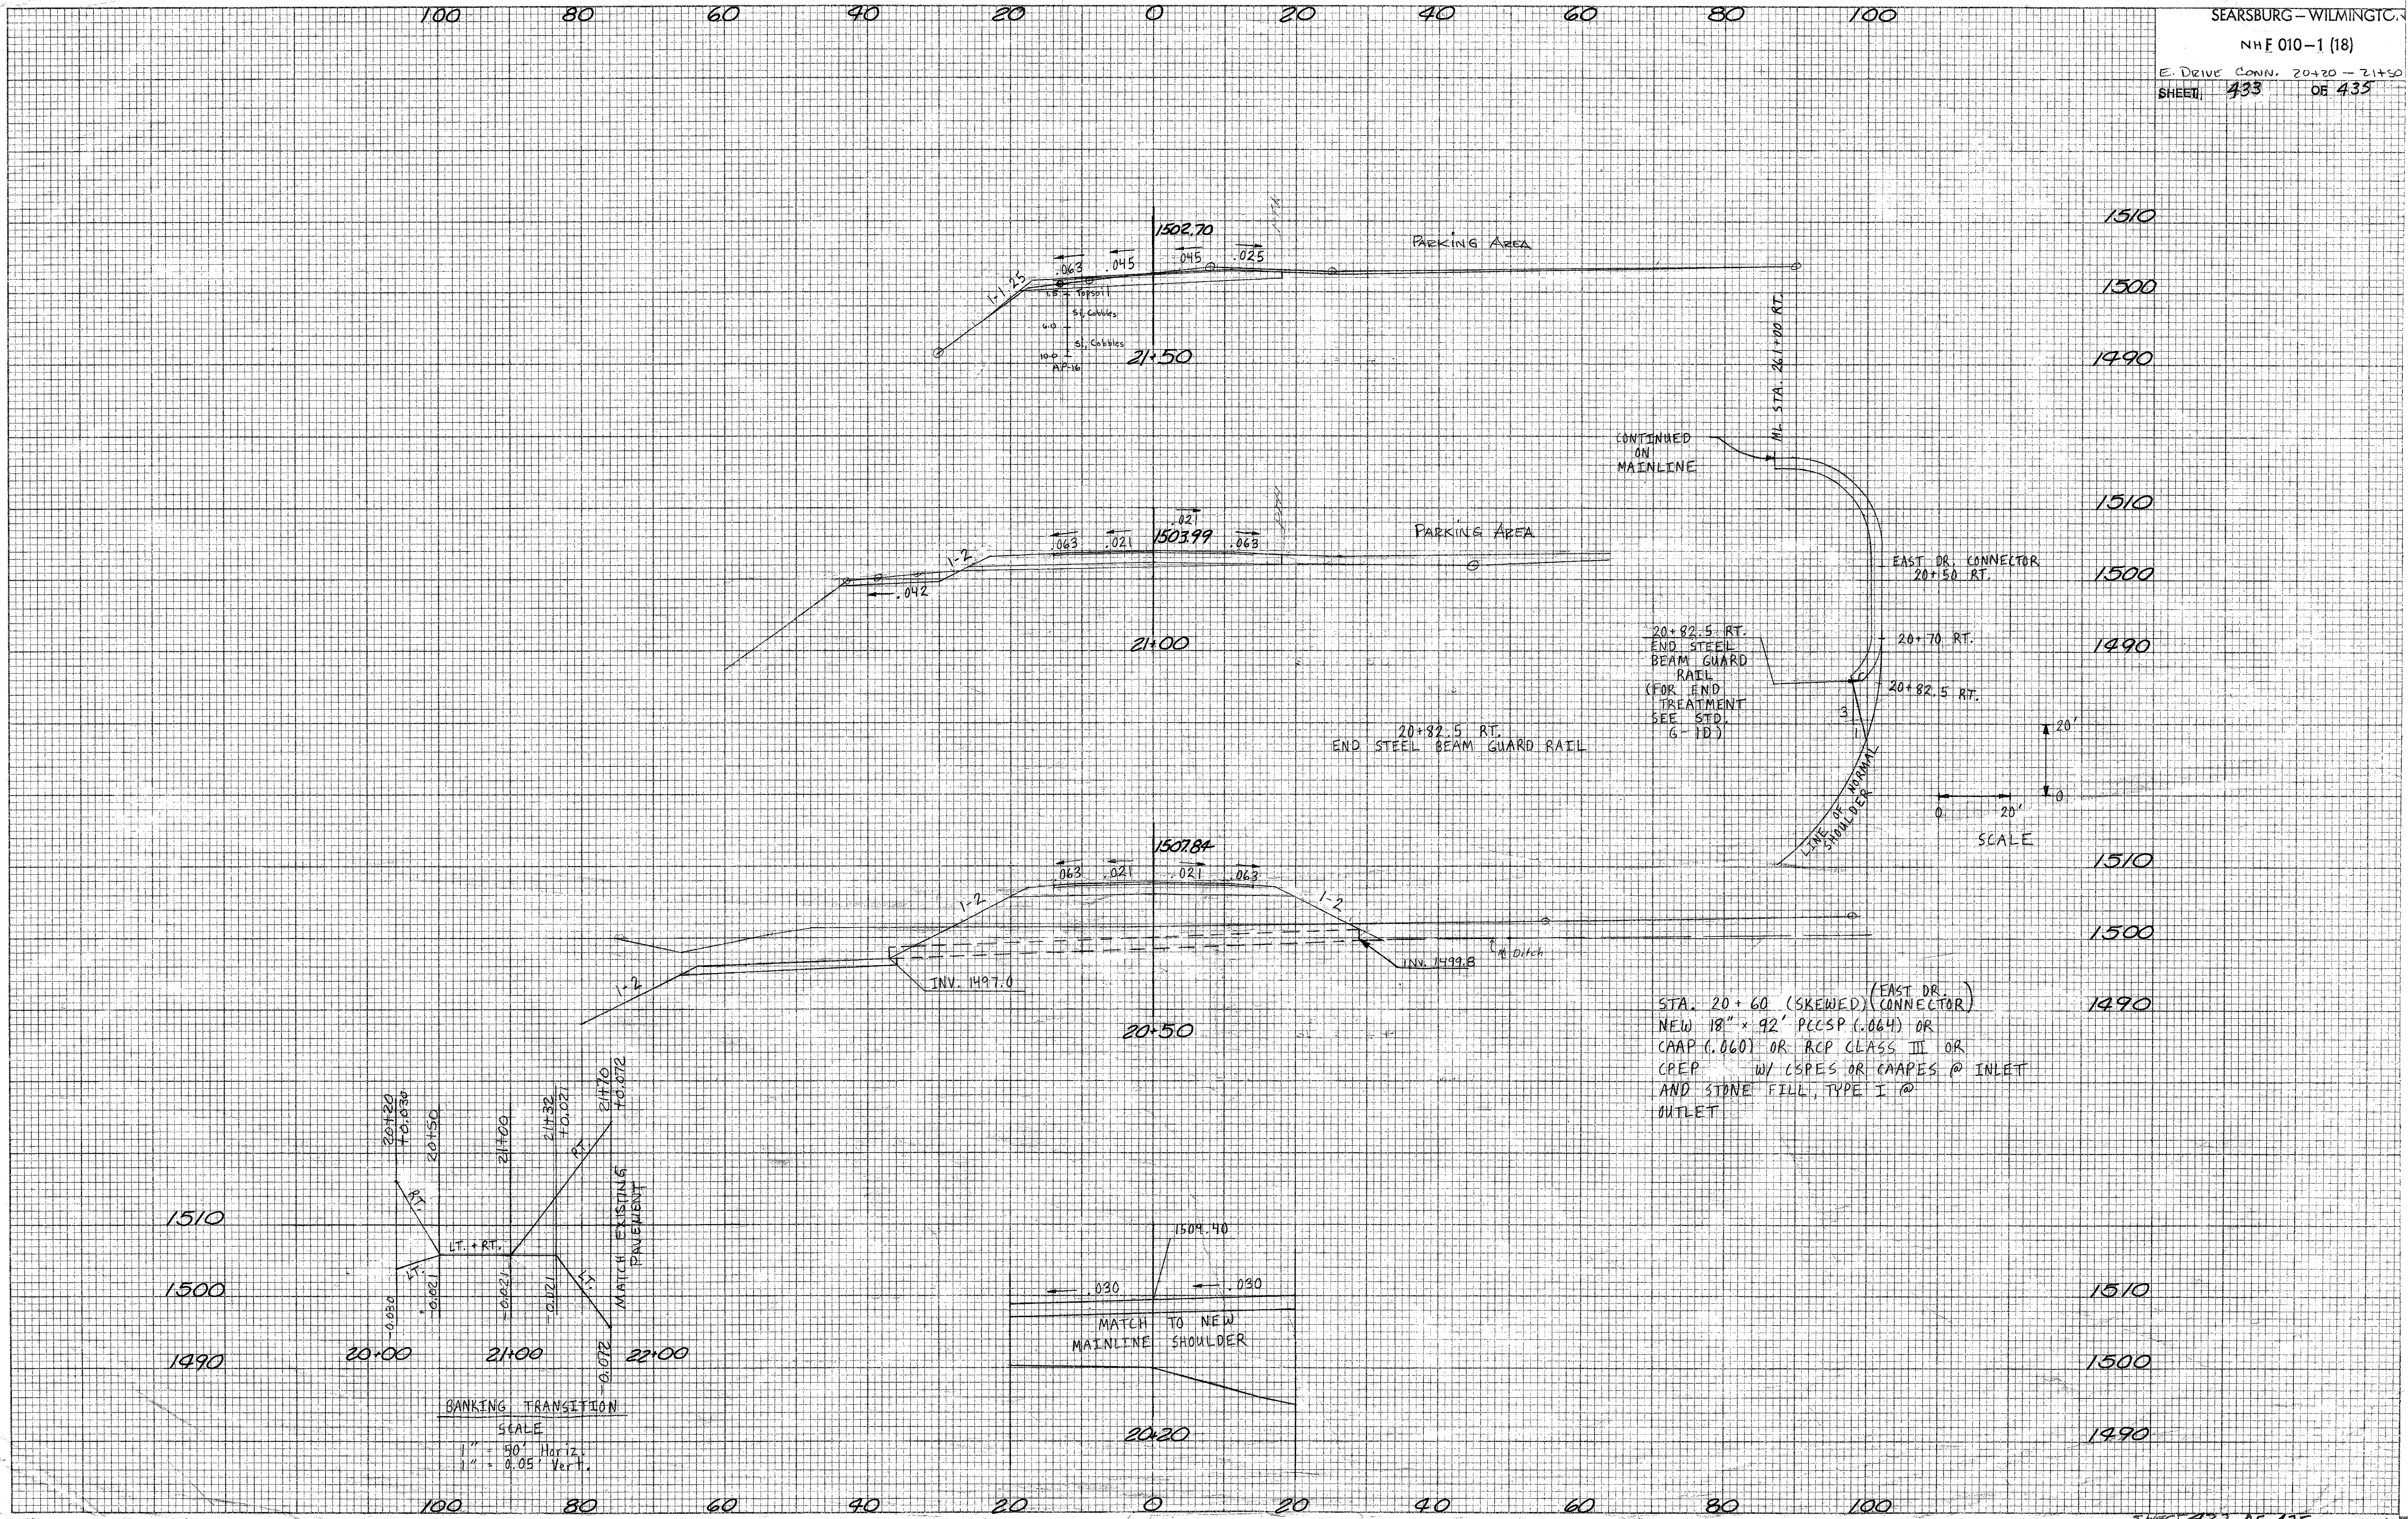

20+82.5 RT.
 END STEEL BEAM GUARD RAIL
 (FOR END TREATMENT SEE STD. G-1B)

20+82.5 RT.
 END STEEL BEAM GUARD RAIL

STA. 20+60 (SKEWED) (EAST DR. CONNECTOR)
 NEW 18" x 92' PCCSP (.064) OR
 CAAP (.060) OR RCP CLASS III OR
 CPEP W/ CSPES OR CAAPES @ INLET
 AND STONE FILL, TYPE I @
 OUTLET

BANKING TRANSITION
 SCALE
 1" = 50' Horiz.
 1" = 0.05' Vert.