PLAN SKETCH BR. 25B ABUT 2.

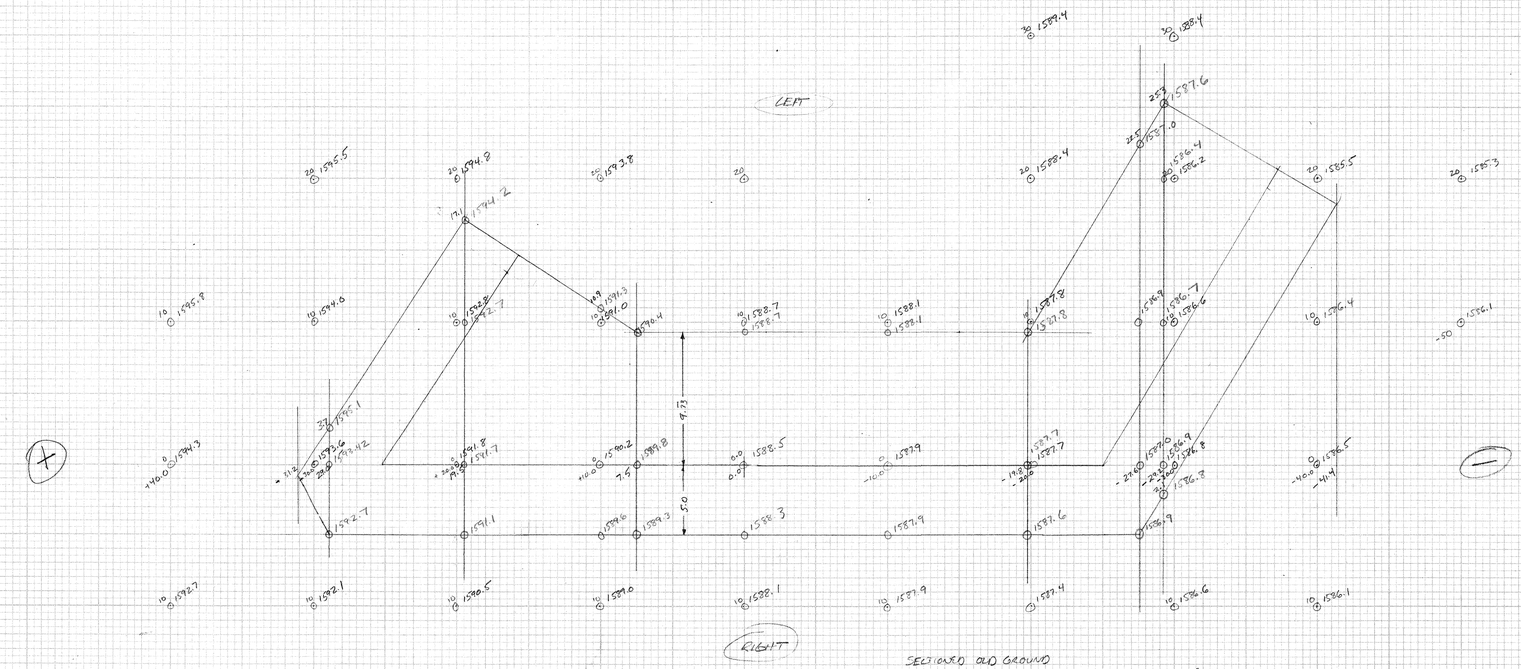

SECTION'D OLD GROUND
INTERPOLATED OLD GROUND

BOTTOM OF EXCAVATION: 1584.00 − 1.5 = 1582.5

HIGHWAY FEDERAL AID SHEET
PLATE 3-FULL CROSS SECTION-FULL LINE
NATIONAL PRINTRAFF
PRINTED IN U.S.A.

467 BR25B-AB2