BR25B
ABUT. #2

SEARSBURG - WILMINGTON
NH-F010-1(18)

SCALE 1:5

XBR25B-9

*ITEM 204.25 CALCULATIONS
NOT BASED ON THESE SECTIONS
SEE CALCULATION SHEETS

SEE NOTE ON XBR25B-1

ZERO 203.27, 613.13, 651.40, 649.31 ✓
-45

3-25-04 akw
8/26-03 JDG
~~204.25: 80.11(70)-45.11 = 223.24 Sq. Ft.~~ ✓ V010 *
204.30: 64.22 + 7.31 + 34.88 + 7.75 + 0.60 + ~~44.76 Sq. Ft.~~ 188.35 + 1.55 = 189.88 SF ✓ ABC 6/3/04
613.13: 9 + 84.58 - ~~99.38~~ Sq. Ft. 25.57 + 78.38 = 103.95 SF ✓ ABC 6/3/04
651.40 = 7 FT ✓ ABC 6/3/04
203.27 = 14.42 SF ✓ ABC 6/3/04
3-25-04 akw

BOTTOM USED IN THIS AREA.

649.31 = 18 LF ✓

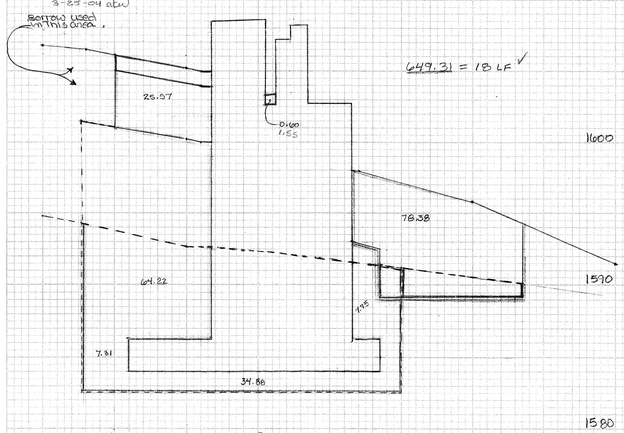

3-23-04 akw
8/26-03
~~613.13: 101 + 57.5 = 158.50 Sq. Ft.~~ 123.41 SF ✓
203.27 = 60.64 SF ✓ ABC 6/3/04
651.40 = 39 ft ✓ ABC 6/3/04
3-23-04 akw

649.31 = 35 LF ✓

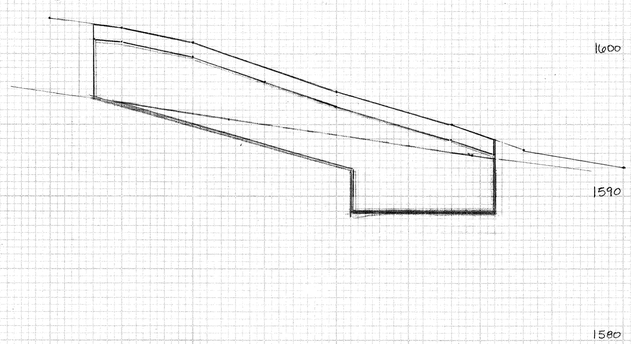

akw 3-25-04
akw 3-23-04
8/26-03 JDG
~~204.25: 77.87 + 37.13 = 115.00 Sq. Ft.~~ V010 *
204.30: 96.80 + 3.98 + 20.88 + 9.35 = 131.01 Sq. Ft. 137.11 SF ✓ ABC 6/3/04

Note: color codes got mixed for this section only
= 204.25
= 203.27

649.31 = 18.5 LF ✓

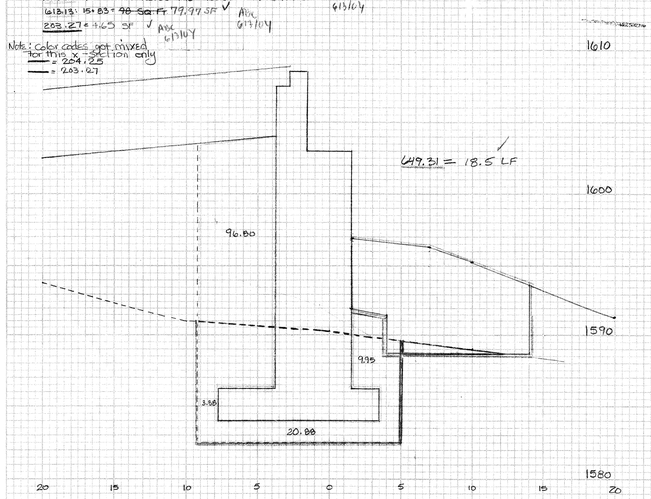

3-23-04 akw
8/26-03 JDG
~~204.25: 5.53 + 53.25 = 58.78 Sq. Ft.~~ V010 *
204.30: 25.90 + 8.50 = ~~34.40 Sq. Ft.~~ 53.48 SF ✓ ABC 6/3/04
613.13: 125 + 64 = ~~189 Sq. Ft.~~ 164.3 SF ✓ ABC 6/3/04
203.27 = 22.28 SF ✓ ABC 6/3/04
651.40 = 35.5 ft ✓ ABC 6/3/04
3-23-04 akw

649.31 = 42 LF ✓

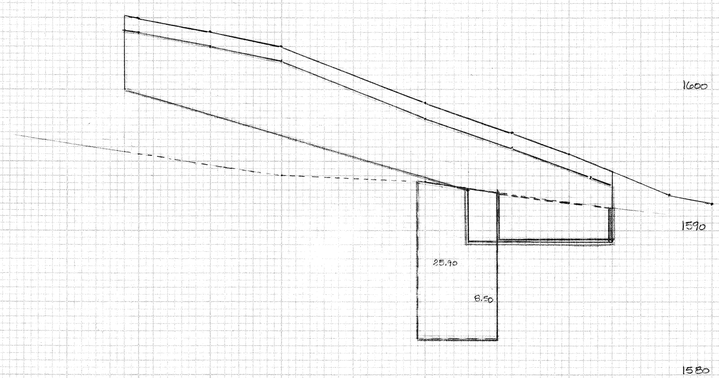

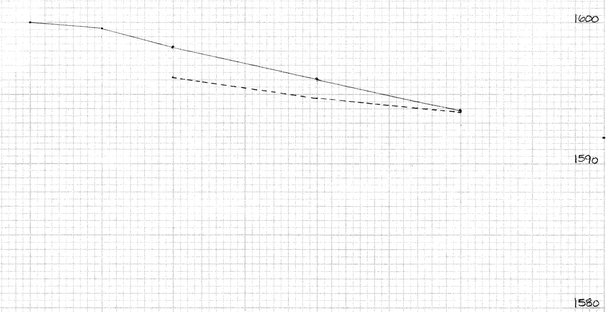

FINAL SURVEY
NOTE BOOK
NO.
SURVEYED
PLOTTED
TEMPLATE
AREAS
AREAS CHECKED

ORIGINAL SURVEY
NOTE BOOK
NO.
SURVEYED
PLOTTED
TEMPLATE
AREAS
AREAS CHECKED
DATE
BY

469 BR25B ABZ