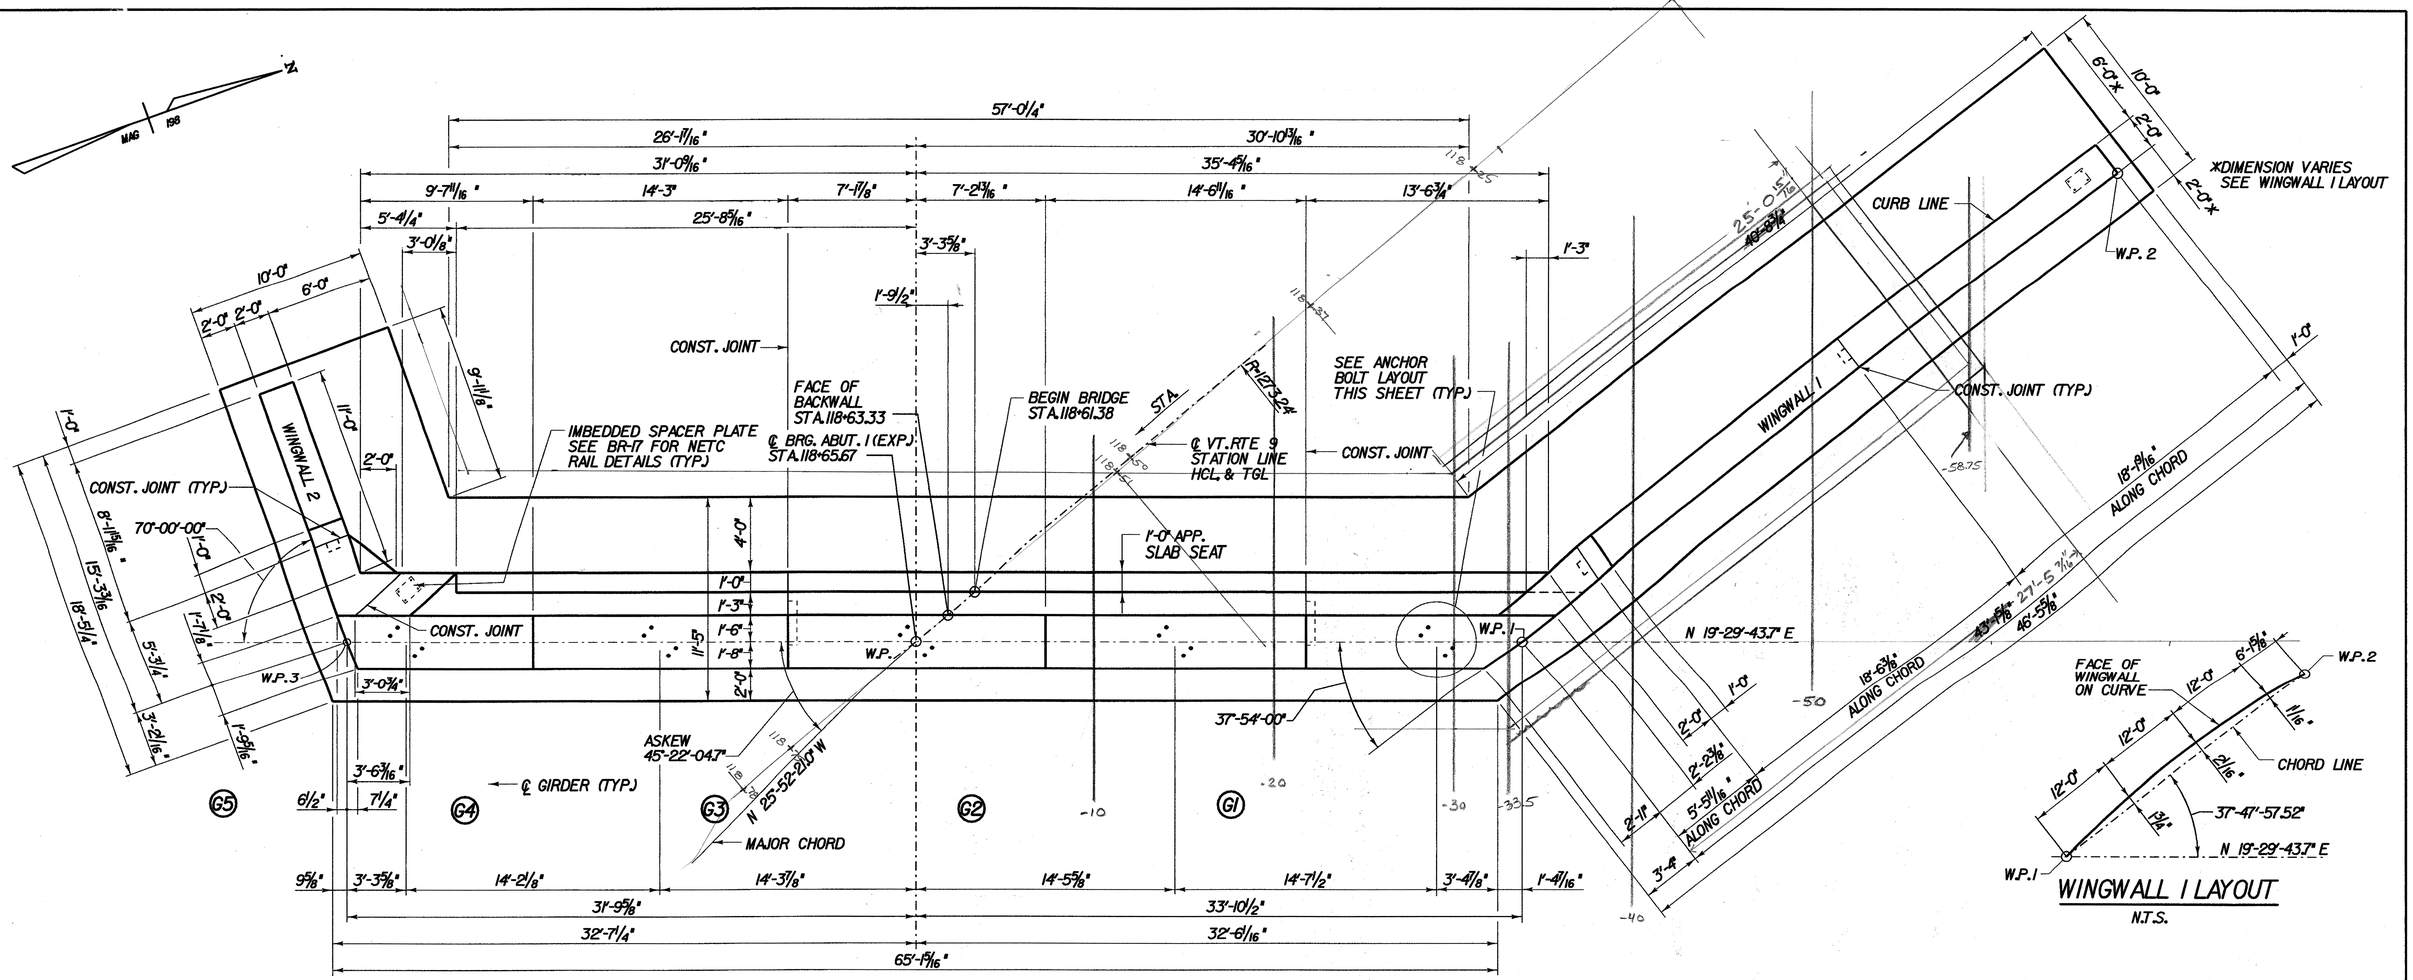

WINGWALL 1 LAYOUT

N.T.S.

ABUTMENT 1 PLAN - BR 25

SCALE 1/4" = 1'-0

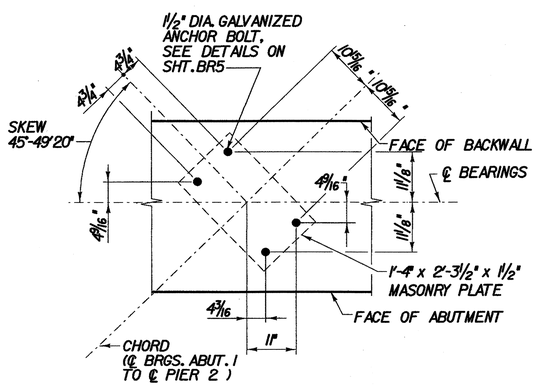

PLAN-ANCHOR BOLT LAYOUT-ABUTMENT 1

SCALE 3/4" = 1'-0

NOTE:

1. FOR BEARING DETAIL SEE BRIDGE SHEET BR5 AND BR7.
2. FOR CONSTRUCTION JOINT DETAIL SEE BRIDGE SHEET BR15.

STATE OF VERMONT
AGENCY OF TRANSPORTATION

Town Of	SEARSBURG	Bridge No. 25	
Highway No.	VT. RTE. 9	Log Sta.	
		Surv. Sta.	
VT. RTE. 9 OVER DEERFIELD RIVER			
ABUTMENT 1 PLAN - BR 25			
Designed By D. VIENI		Drawn by K. DETRICK/Wm WEATHERBY	
Checked By M. OLSTAD	Date 2/2002	Bridge Design Supervisor M. OLSTAD	Date 2/2002
PROJECT SEARSBURG - WILMINGTON		PROJECT NO. NHF 010-1(18)	
I.G.C. Info.			
Bridge Sheet No. BR220		Sheet 146 OF 435	

CLOUGH, HARBOUR & ASSOCIATES LLP
ENGINEERS, SURVEYORS, PLANNERS & LANDSCAPE ARCHITECTS
11 WINNERS CIRCLE ALBANY, NEW YORK 12205

482 BR25-AB1

FILE NAME =n\78d0f96 /ustures\consultant 022002\15\br-dg25\25_ebut1.dgn
DATE/TIME =2/12/20 =
USER =Whitacomb