BRIDGE 24
SECTIONS
SCALE: 1:5

SEARSBURG - WILMINGTON
NH-F010-1(18)

XBR24-2

ABUT # 1 ABUT # 2

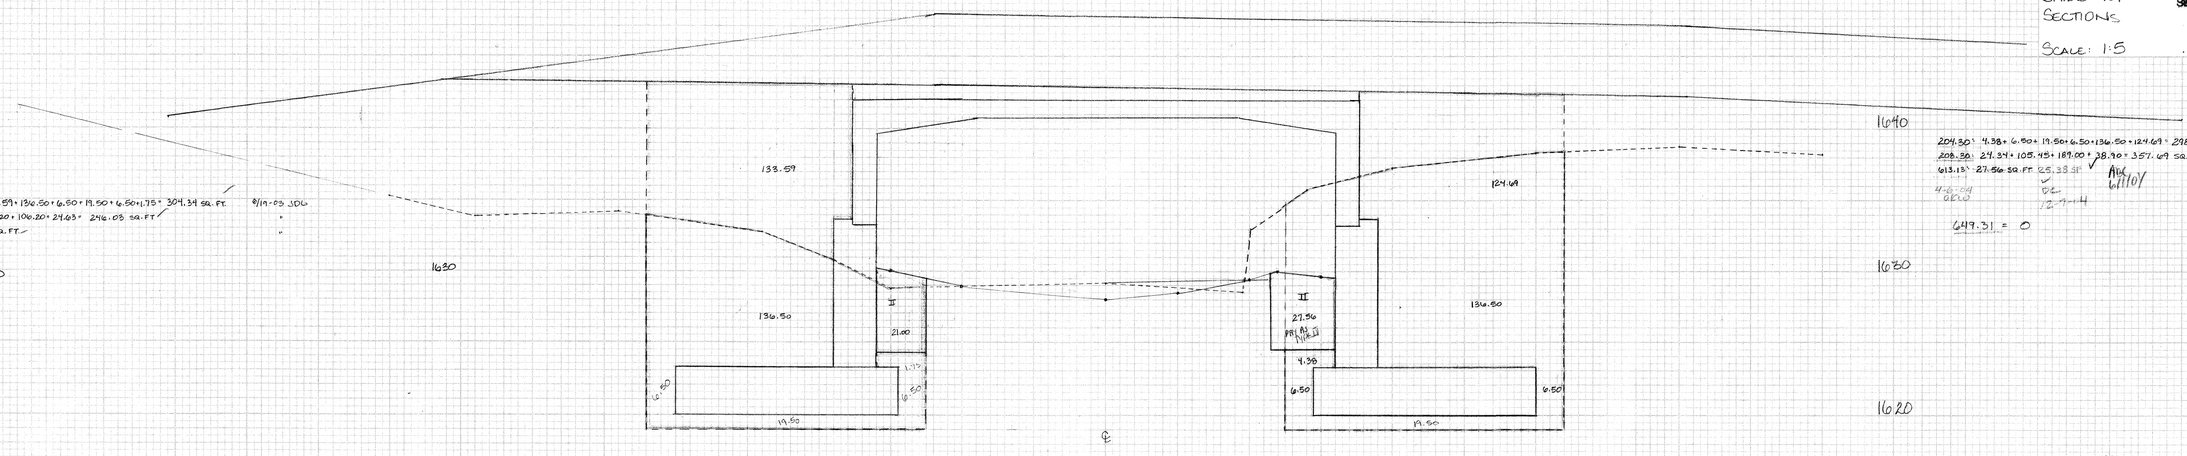

204.30: 133.59 + 136.50 + 6.50 + 19.50 + 6.50 + 1.75 = 304.34 SQ. FT. 8/19-03 JDG
208.30: 115.20 + 106.20 + 24.68 = 246.08 SQ. FT. "
613.13: 21 SQ. FT. "
4-7-04 OKD
649.31 = 0

204.30: 4.38 + 6.50 + 19.50 + 6.50 + 136.50 + 124.69 = 298.07 SQ. FT. 8/15-03 JDG
208.30: 24.34 + 105.45 + 187.00 + 38.90 = 357.69 SQ. FT. "
613.13: 27.56 SQ. FT. 25.38 SF ✓ "
ADC 6/11/04
4-6-04 OKD
DL 12-7-04
649.31 = 0

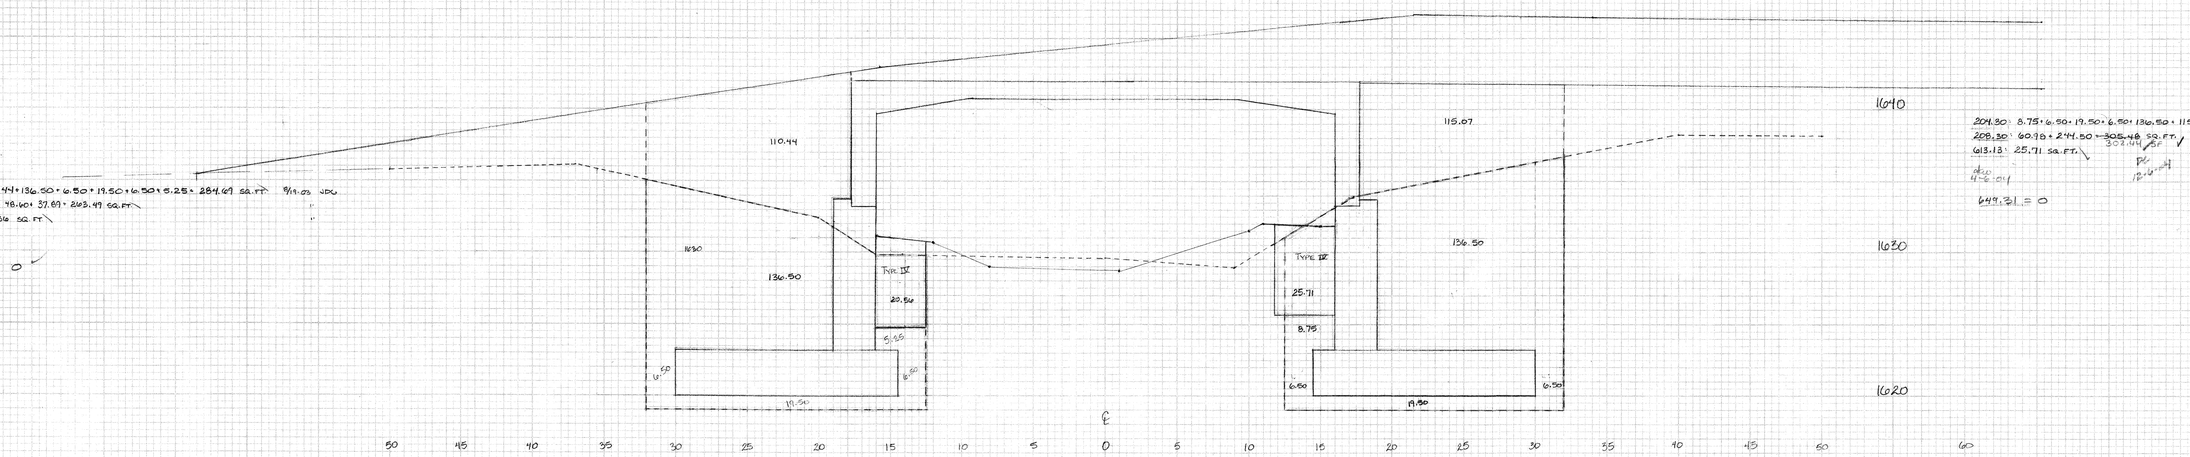

204.30: 110.44 + 136.50 + 6.50 + 19.50 + 6.50 + 5.25 = 284.69 SQ. FT. 8/19-03 JDG
208.30: 177.48.60 + 37.89 = 203.49 SQ. FT. "
613.13: 20.56 SQ. FT. "
4-6-04 OKD
649.31 = 0

204.30: 8.75 + 6.50 + 19.50 + 6.50 + 136.50 + 115.07 = 292.82 SQ. FT. 8/15-03 JDG
208.30: 60.98 + 244.50 = ~~305.48~~ SQ. FT. 302.44 SF ✓ "
613.13: 25.71 SQ. FT. "
ADC 6/11/04
DL 12-6-04
4-6-04
649.31 = 0

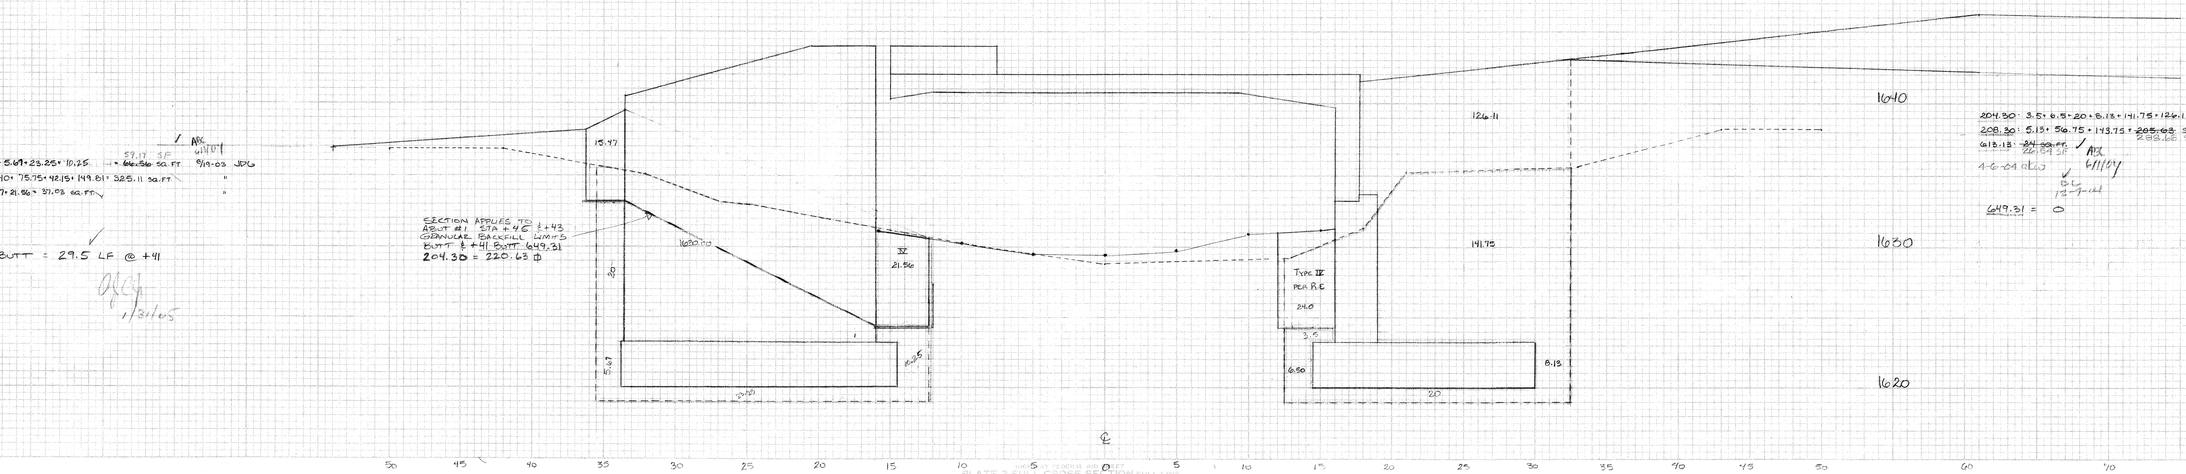

204.30: 20 + 5.67 + 25.25 + 10.25 = ~~66.56~~ 57.17 SF SQ. FT. 8/19-03 JDG
208.30: 57.40 + 75.75 + 42.15 + 149.81 = 325.11 SQ. FT. "
613.13: 15.47 + 21.56 = 37.03 SQ. FT. "
ADC 6/11/04
4-6-04 OKD

649.31 BUTT = 29.5 LF @ +41
1/31/05

GRANULAR BACKFILL LIMITS
BUTT ± +41 BUTT 649.31
204.30 = 220.63 ☐

204.30: 3.5 + 6.5 + 20 + 8.13 + 141.75 + 126.11 = 305.99 SQ. FT. 8/15-03 JDG
208.30: 5.13 + 56.75 + 143.75 + ~~205.63~~ SQ. FT. 288.68 SF ✓ "
613.13: ~~24 SQ. FT.~~ 26.84 SF ✓ "
ADC 6/11/04
DL 12-6-04
4-6-04 OKD
DL 12-7-04
649.31 = 0

PLATE 3-FULL CROSS SECTION-FULL LINE

FOR +41 ABUT#1 USE +40 (649.31)

499 BR 24 x5